

# J. W. WARDEN & ASSOCIATES

CIVIL ENGINEERS AND SURVEYORS

D. D. ANDRUS, PRESIDENT  
405 ELYRIA BLOCK  
ELYRIA, OHIO

TELEPHONES FA 2-9828  
FA 2-1466

M. W. JACKSON  
SECRETARY



STATE OF OHIO

REGISTERED { PROFESSIONAL ENG.  
SURVEYOR

MAP PG 04-00-027-G

PDN 04-00-027-101-7???

14-11931

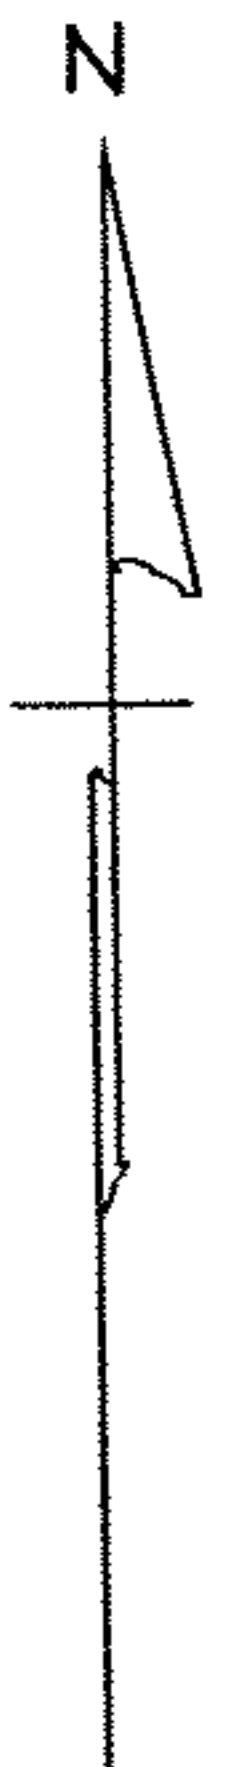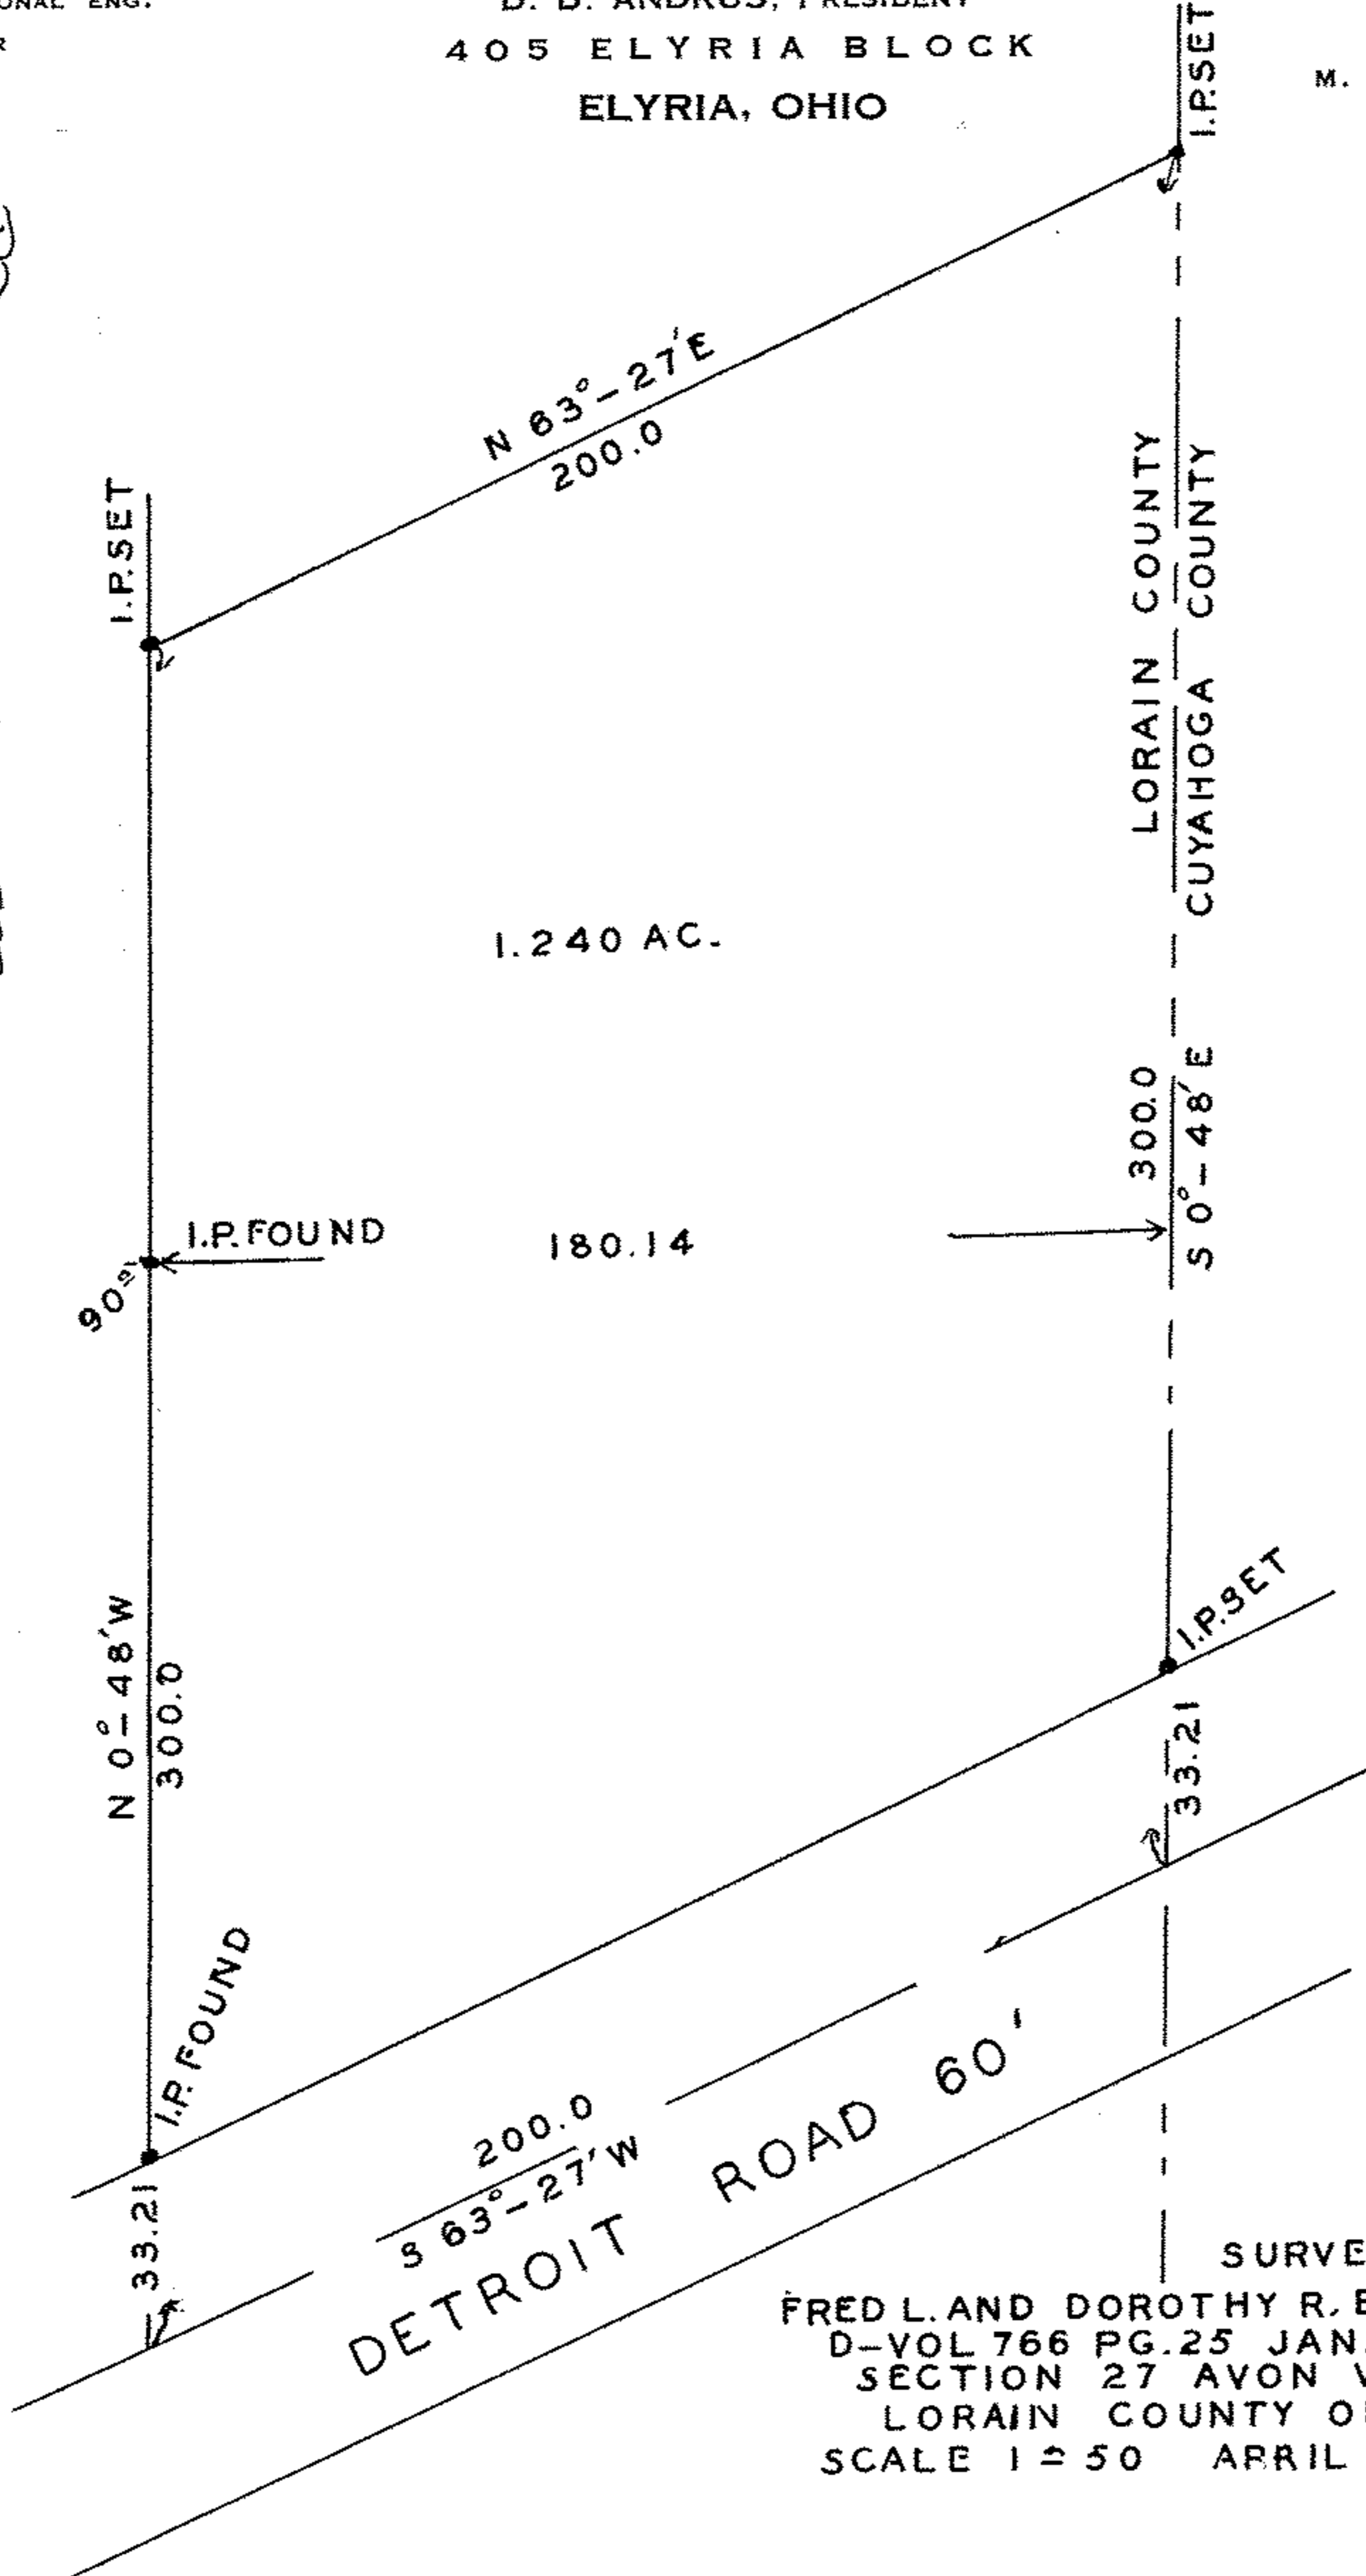

SURVEY FOR  
 FRED L. AND DOROTHY R. BURMEISTER  
 D-VOL 766 PG. 25 JAN. 26, 1960  
 SECTION 27 AVON VILLAGE  
 LORAIN COUNTY OHIO  
 SCALE 1" = 50' APRIL 20, 1960