

# J. W. WARDEN & ASSOCIATES


CIVIL ENGINEERS AND SURVEYORS

STATE OF OHIO  
REGISTERED { PROFESSIONAL ENG.  
SURVEYOR

D. D. ANDRUS, PRESIDENT  
405 ELYRIA BLOCK  
ELYRIA, OHIO

TELEPHONES 3211  
42871

M. W. JACKSON  
SECRETARY

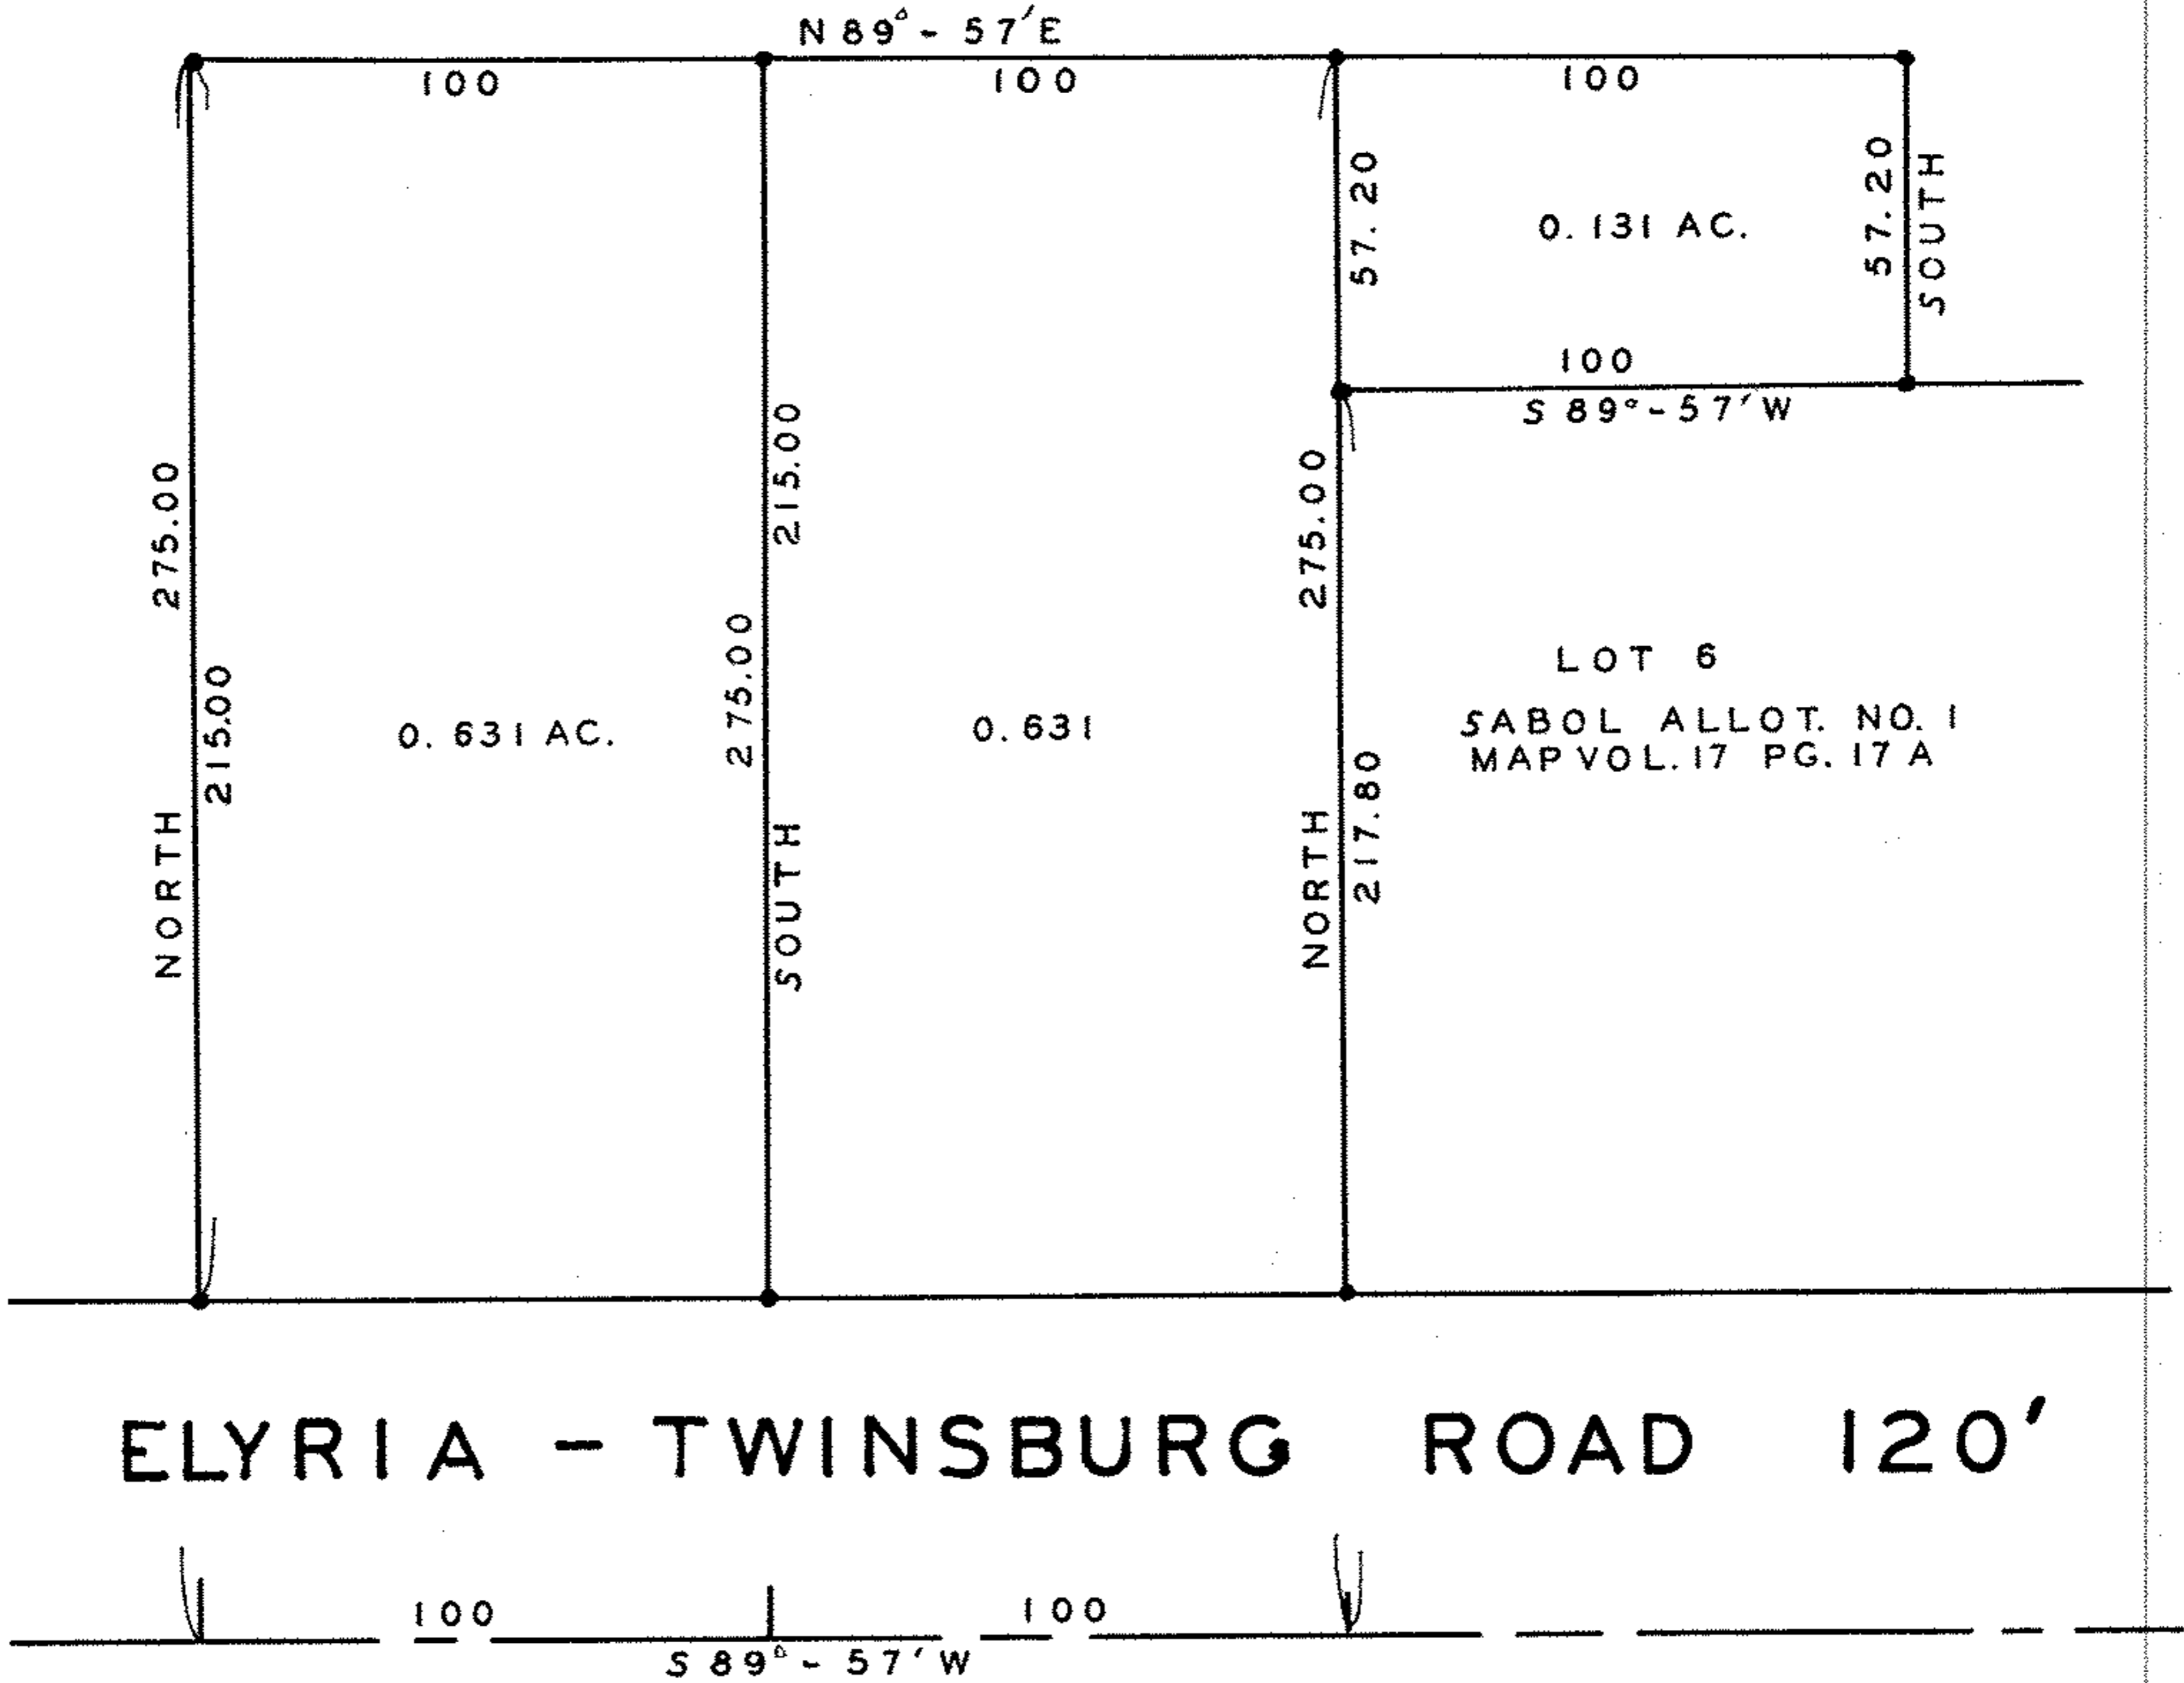

ELYRIA - TWINSBURG ROAD 120'

SURVEY FOR  
WILLIAM SABOL ETAL  
O. L. 75 EATON TOWNSHIP  
LORAIN COUNTY, OHIO  
SCALE 1" = 50' MAY 26, 1959

*0101-11*

Iron stakes set at all points indicated thus •