


14 0984

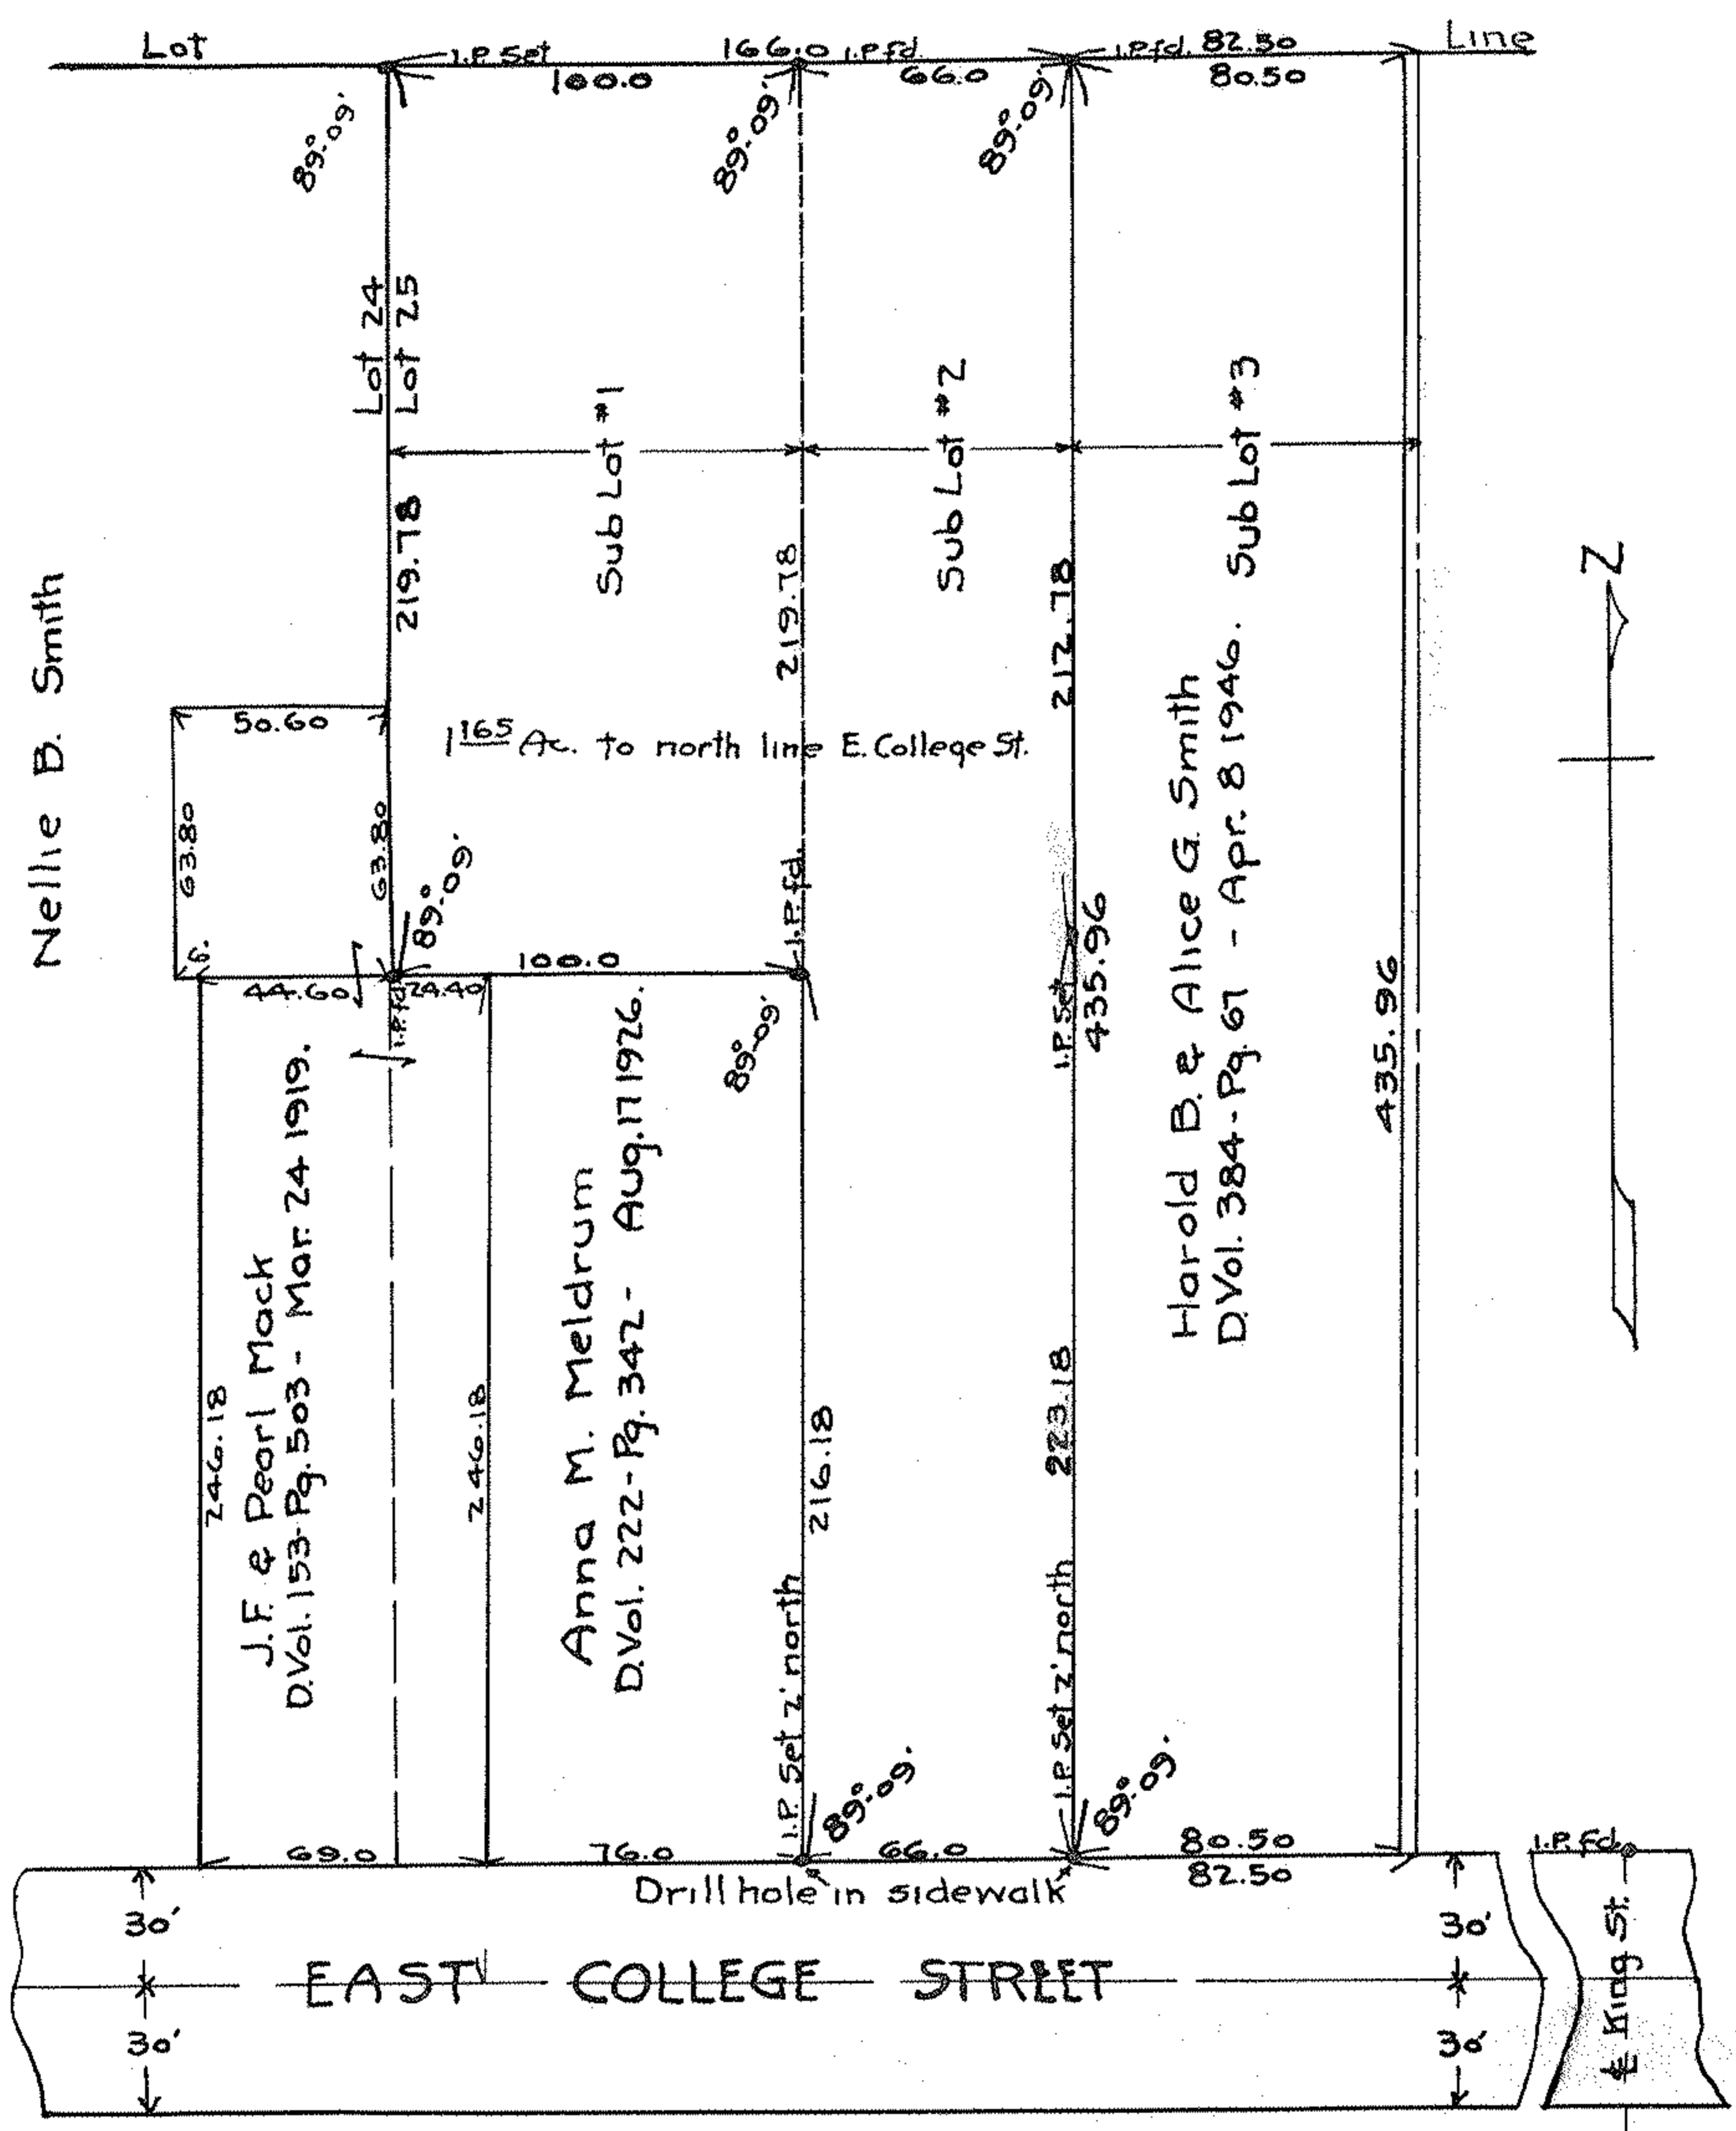

Survey for  
 G. L. & Laura Roberta Thourat  
 Lot 25 Original Village Plat - Village of Oberlin  
 O.L. 86 Russia Twp. - Lorain Co. Ohio.  
 Scale 1" = 60'  
 Dec. 10, 1946.  
 J. W. Worden Reg. Surveyor.

W-1-den