

100 356D

# Survey for MILO C. KENDEIGH.

Lot II, Amherst Twp.,

South Amherst Village - Lorain Co., O.

March 17, 1937.


Scale 1" = 200 ft.

J. W. Warden, - Registered Surveyor.

Revised Dec. 7, 1943

PPN 05-00-011-105-???

MAP P3 05-00-011-B A

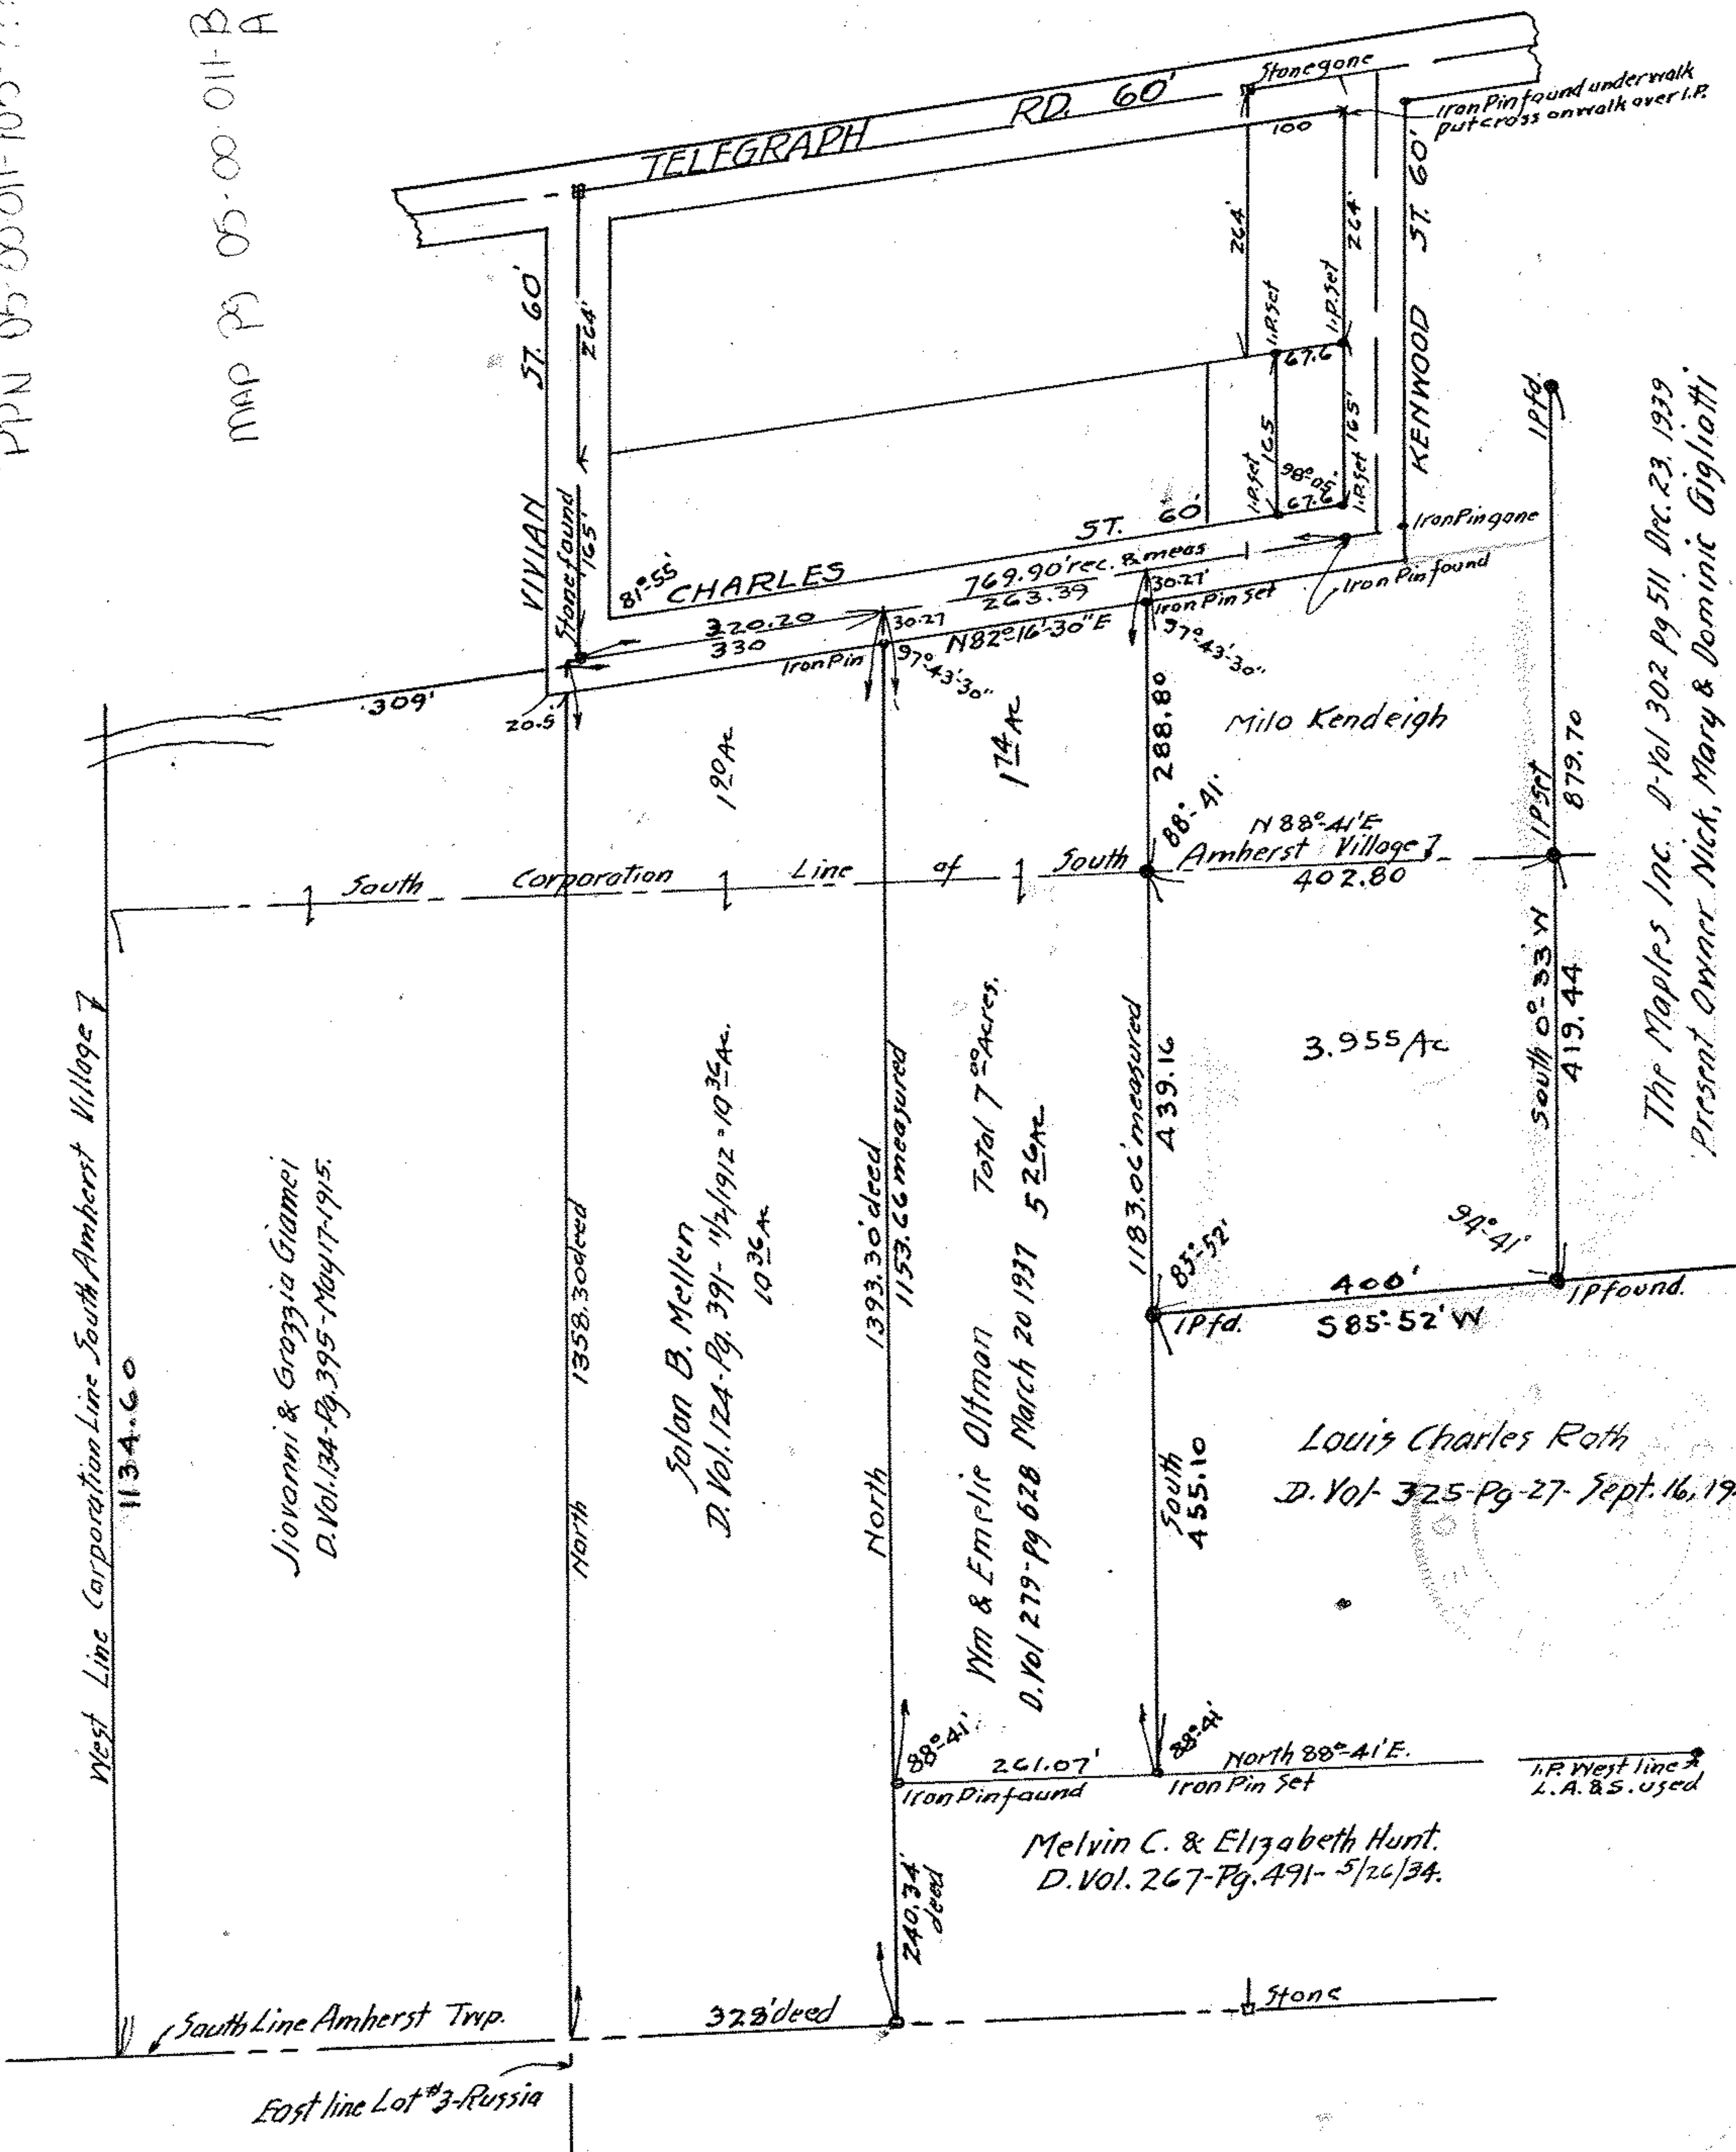

West Line Corporation Line South Amherst Village 7  
1134.60

Jiovanni & Grazia Giamei  
D. Vol. 134 - Pg. 395 - May 17, 1915.

Jolan B. Mellen  
D. Vol. 124 - Pg. 391 - 11/2/1912 - 10.35 Ac.  
10.35 Ac.

M & Emelie Oltman  
D. Vol. 279 - Pg. 628 March 20 1937 5.20 Ac.  
Total 7.00 Acres.

Louis Charles Roth  
D. Vol. 325 - Pg. 27 - Sept. 16, 1942

Melvin C. & Elizabeth Hunt.  
D. Vol. 267 - Pg. 491 - 5/26/34.

The Maples Inc. D. Vol. 302 Pg. 511 Dec. 23, 1939  
Present Owner Nick, Mary & Dominic Gigliotti

South Line Amherst Twp.

East line Lot #3 - Russia

I.P. West line L.A. & S. used