

O.L. 36  
33.57  
S 1° - 27' - 30" W  
81.80 REC.

S 88° - 24' - 30" E  
553.49 REC.

ROBERT B. AND MARGARET M. LAULE

D - VOL 329 PG. 201 AUG. 23, 1943

N 88° - 24' - 30" W  
314.67 REC. 509.50 REC.

0.454 AC.

194.92 REC.  
D - VOL 342 PG 65  
NOV. 10, 1945  
N 77° - 04' - 50" W  
179.58 REC.

I.P. SET  
1.75

158.75

I.P. SET  
S 85° - 17' - 30" E  
137.10

478.40


I.P. SET

147.70

I.P. SET  
32.51  
I.P. FD  
31.34  
33.10

EAST RIVER ROAD  
60'

40 REC.  
N 29° - 42' - 30" E  
92.74 REC.

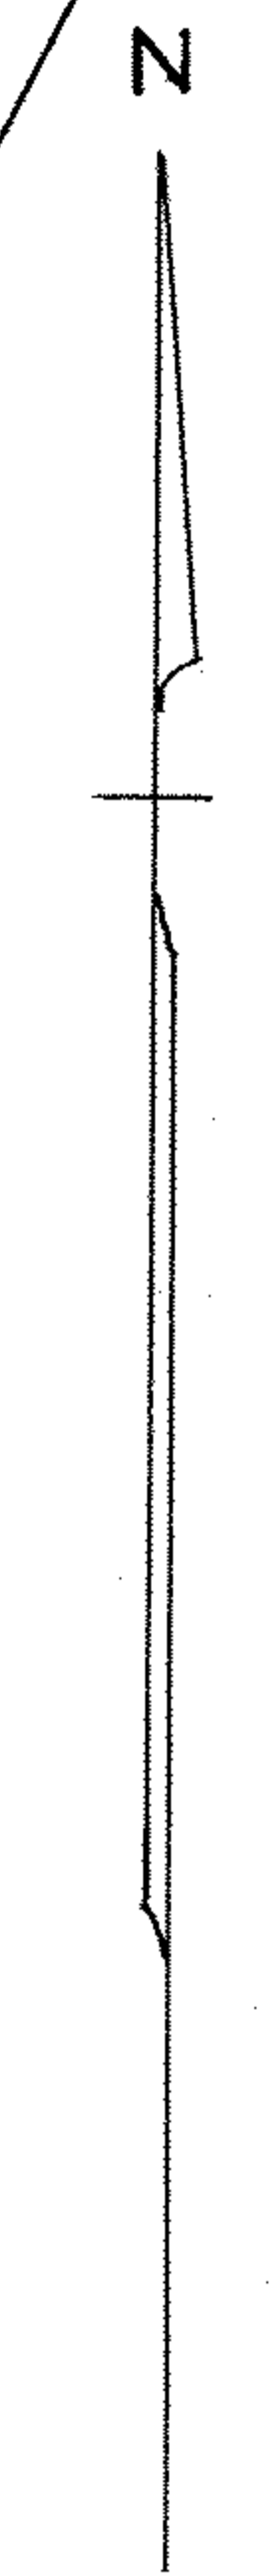

SURVEY FOR  
ROBERT B. AND MARGARET M. LAULE  
ORIGINAL LOT 36 COLUMBIA TWP.  
LORAIN COUNTY, OHIO  
SCALE 1" = 30' FEB. 27, 1964  
J. W. WARDEN AND ASSOCIATES  
REG. SURVEYORS

PREMISES OF - MARGARET H. KISTLER  
D - VOL 446 PG. 164 AUG. 13, 1948

PPM-01

MAP PG 12-00-036-A

PPM 12-00-036-000-005  
006  
073

10149