


Frank & Philomena Luppino
D-Vol. 286 Pg. 321 May 14 1937.

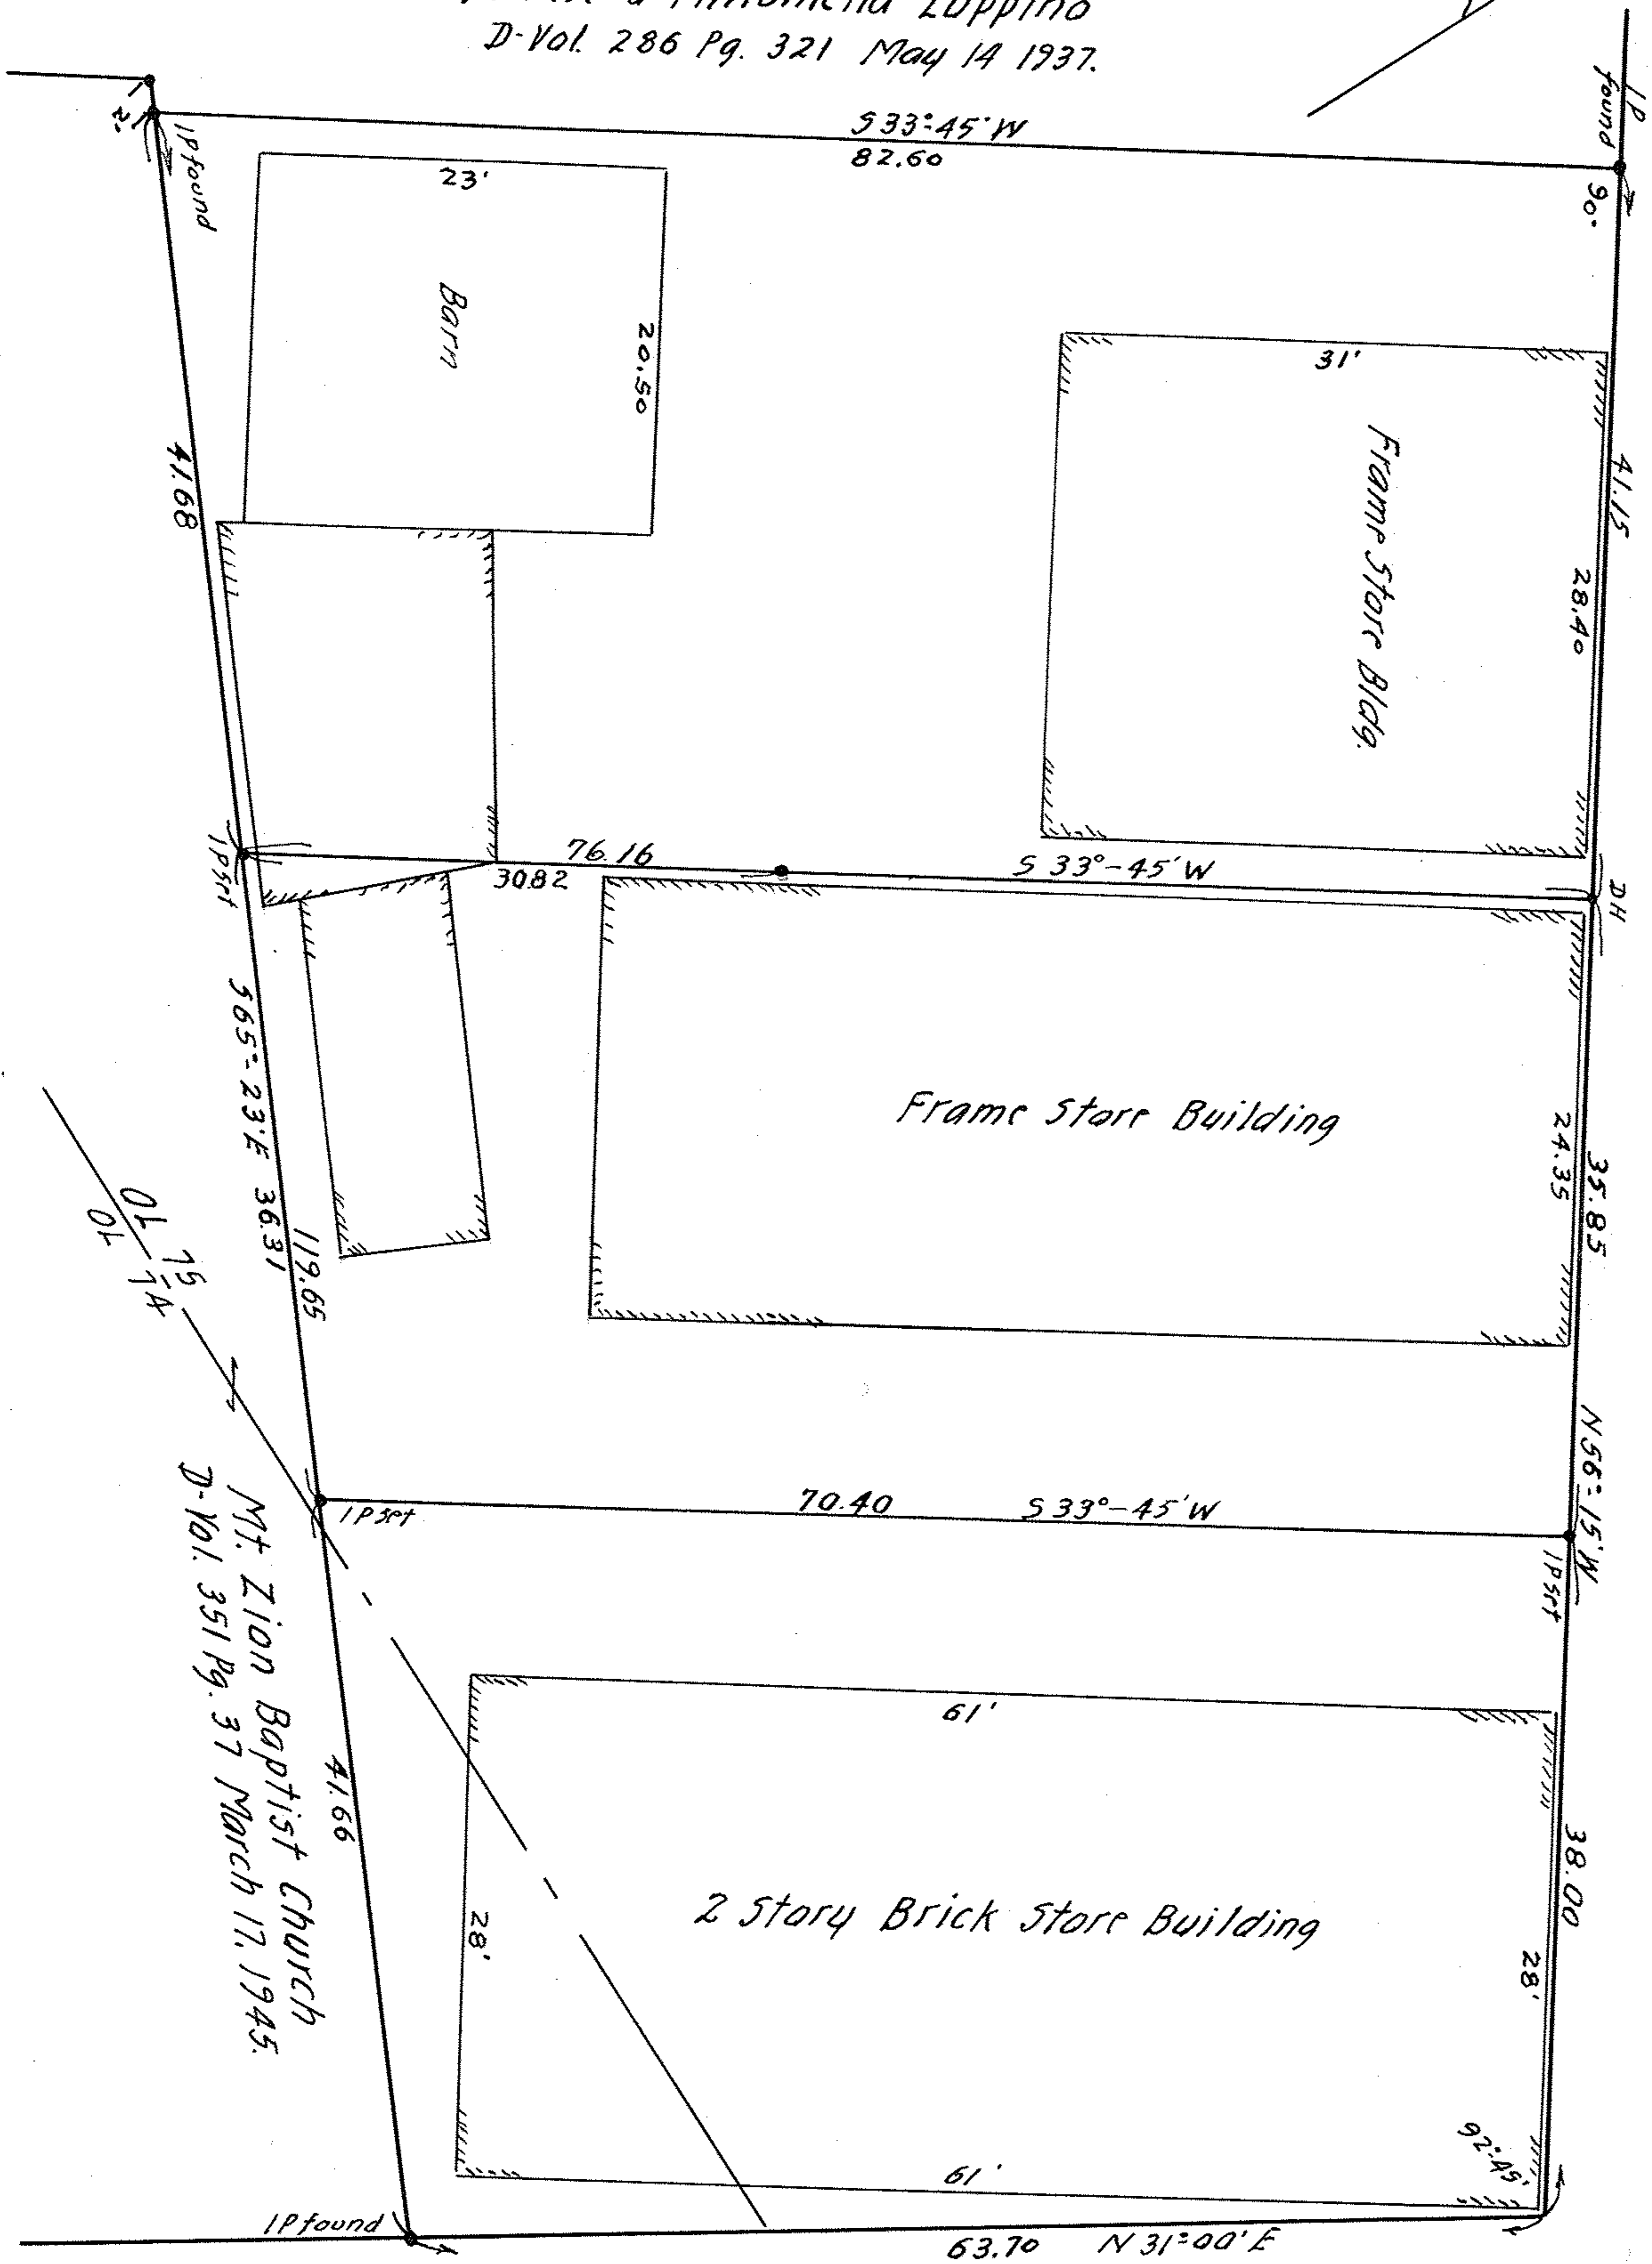

LODI ST. 66'

WEST RIVER ST. 66'

PPN 06-26-074-000-77?

map pg 6-100

SURVEY FOR
W. ARNOLD, MARGARET AND ANNA R. SMITH
D-VOL. 616 PG. 161 NOV. 19, 1954
ORIGINAL LOTS 74-75 WEST OF BLACK RIVER
ELYRIA CITY, LORAIN COUNTY, OHIO
SCALE 1"=10' JUNE 30, 1955
J. W. WARDEN AND ASSOCIATES, REG. SURVEYOR'S

5-150