

# J. W. WARDEN & ASSOCIATES

CIVIL ENGINEERS AND SURVEYORS


D. D. ANDRUS, PRESIDENT  
405 ELYRIA BLOCK  
ELYRIA, OHIO

STATE OF OHIO

REGISTERED } PROFESSIONAL ENG.  
SURVEYOR

TELEPHONES FA 2-9828  
FA 2-1466

M. W. JACKSON  
SECRETARY

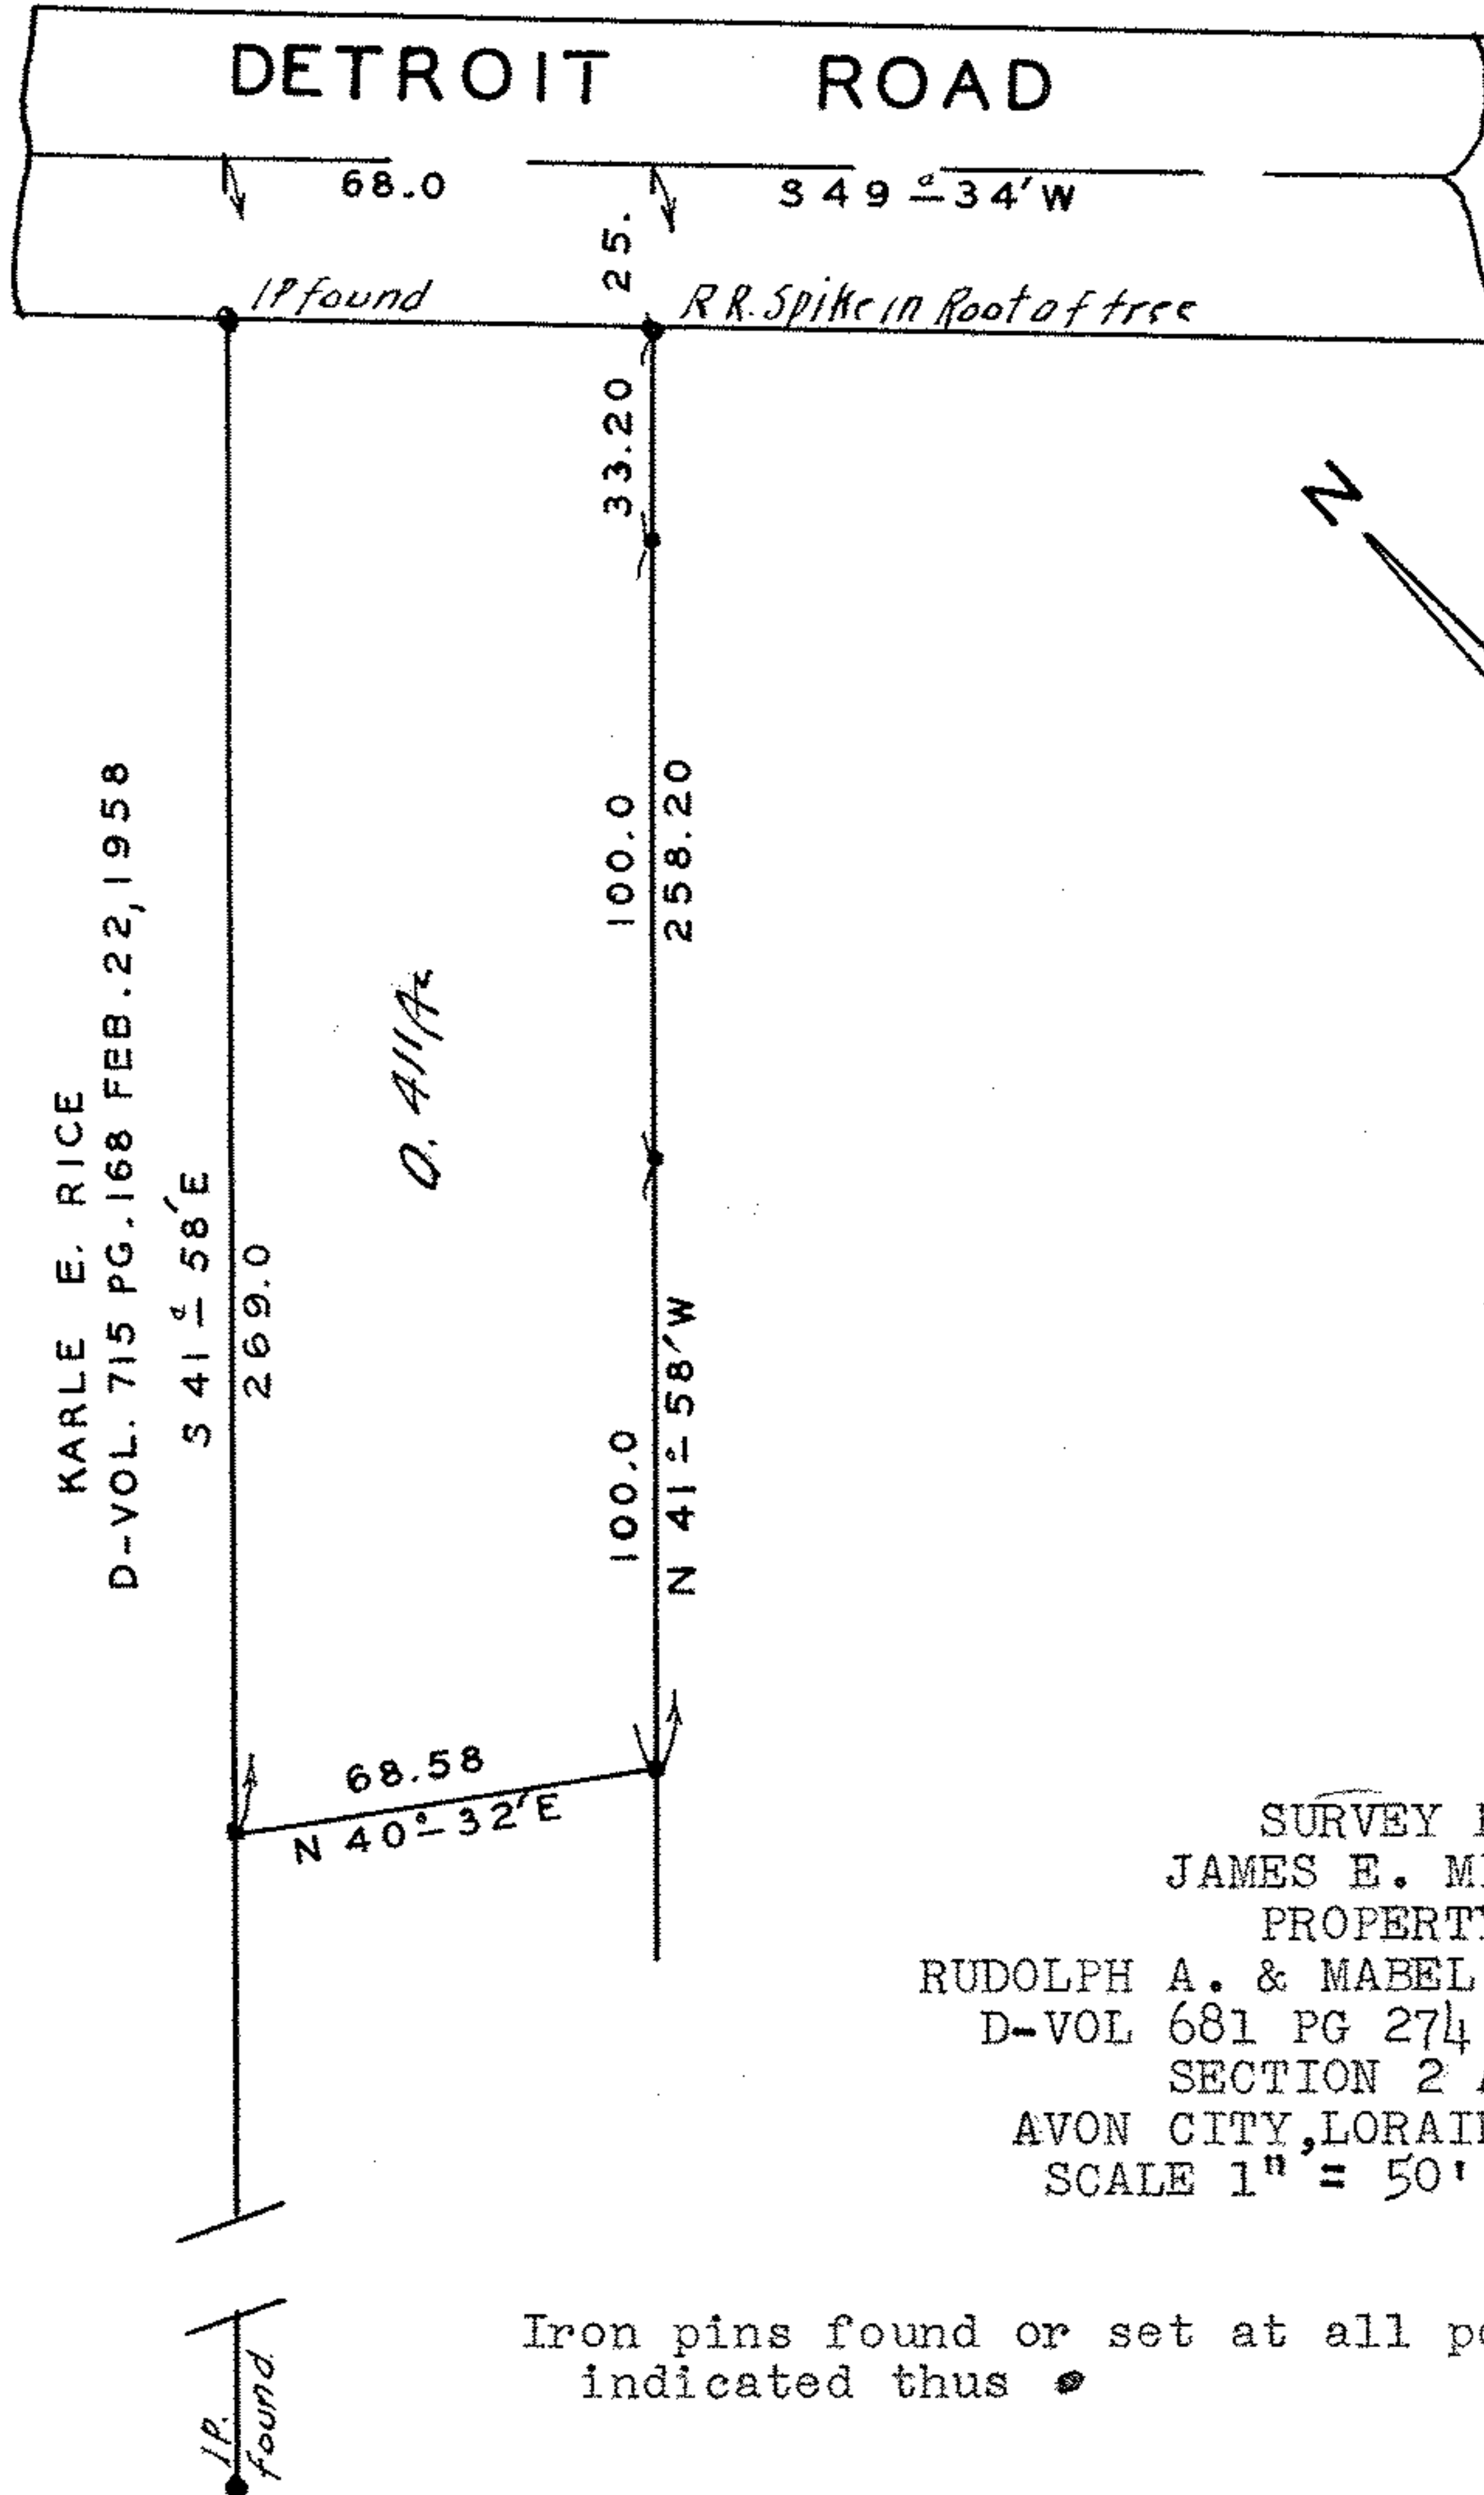

KARLE E. RICE  
D-VOL. 715 PG. 168 FEB. 22, 1958

*O. A. H. A.*

SURVEY FOR  
JAMES E. MILLICIC  
PROPERTY OF  
RUDOLPH A. & MABEL M. MITTELSTEAD  
D-VOL 681 PG 274 NOV. 3, 1956  
SECTION 2 AVON TWP.  
AVON CITY, LORAIN COUNTY, OHIO  
SCALE 1" = 50' MAY 20, 1963

Iron pins found or set at all points indicated thus ●

9013470