


Survey for
The Belle Vernon Mapes Dairy Co.
Original Twp. Lot #29. Wellington Twp.
Lorain Co., Ohio.
Nov. 21, 1913. T.L. Gibson C.E.
Wm. Evans

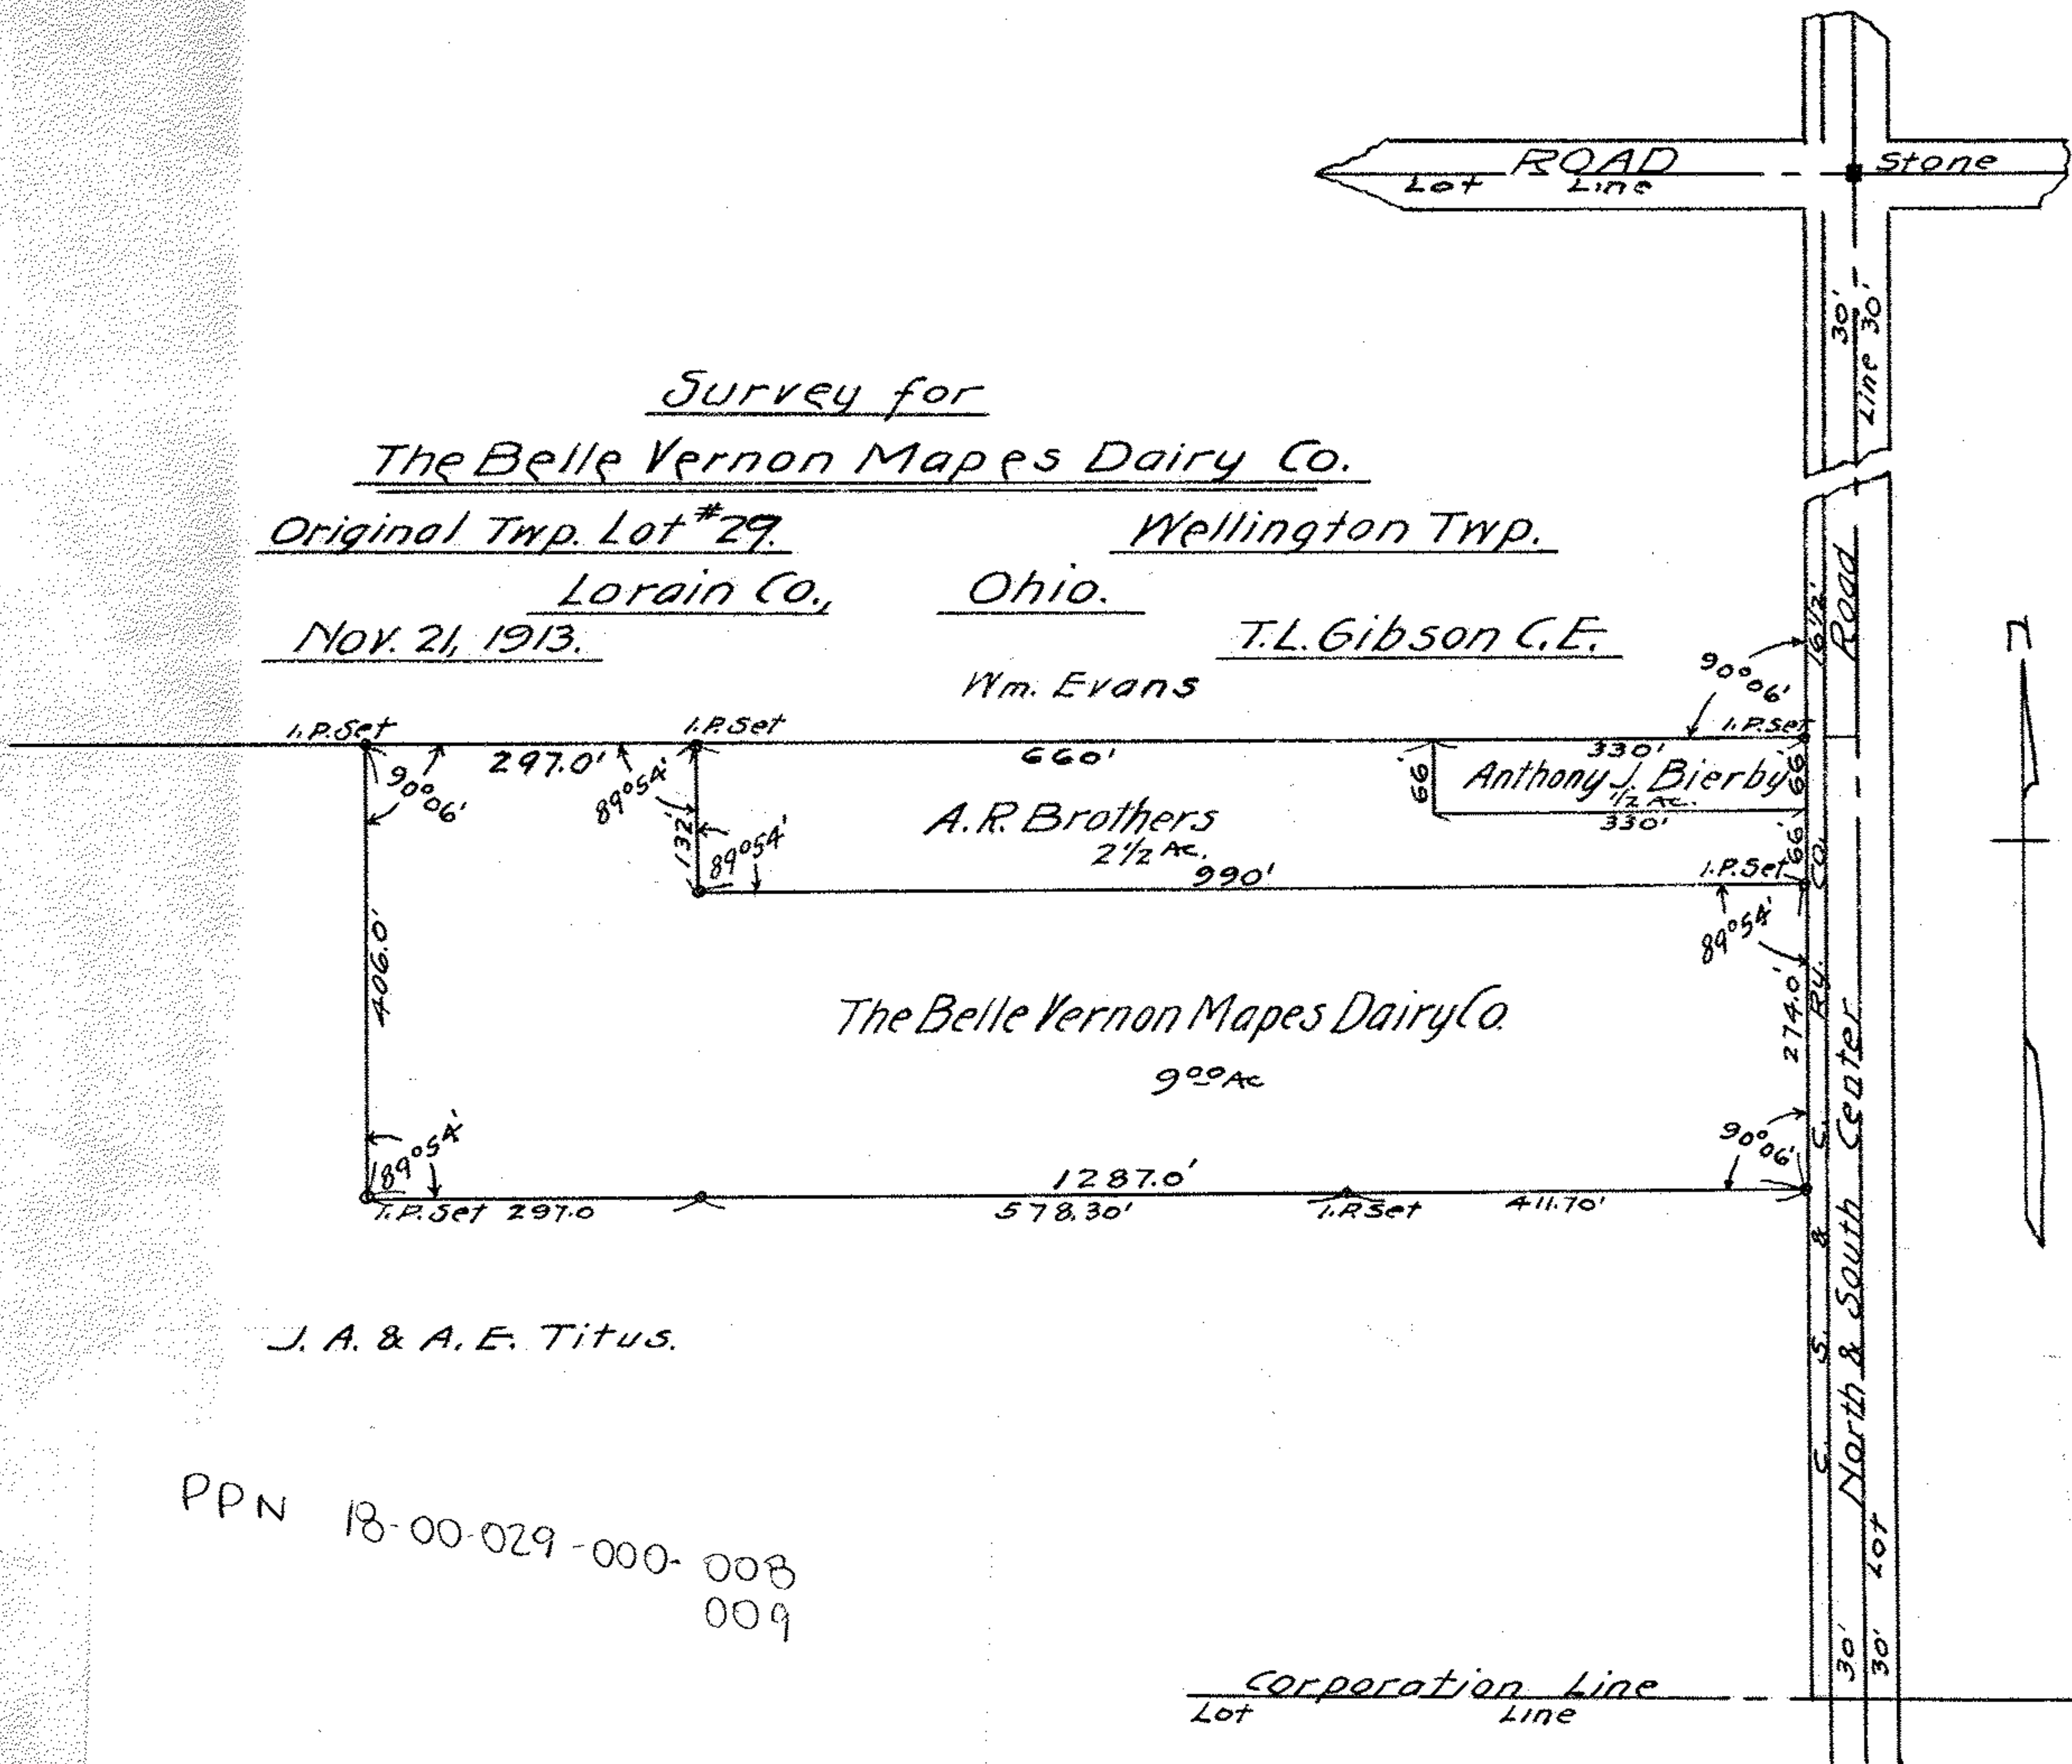

J. A. & A. E. Titus.

PPN 18-00-029-000-008
 009

MAP P9 18-00-029-D

800379