


Survey for Frank. E. Marsh
to cut off 4.50 acres from North
end of John Simms lands, by line
parallel to Russia Road.

Section 8, Carlisle Twp. Lorain, Co. Ohio.
Warden & Foundry, C. Co.

Oct 18, 19

Scale 1" = 100'

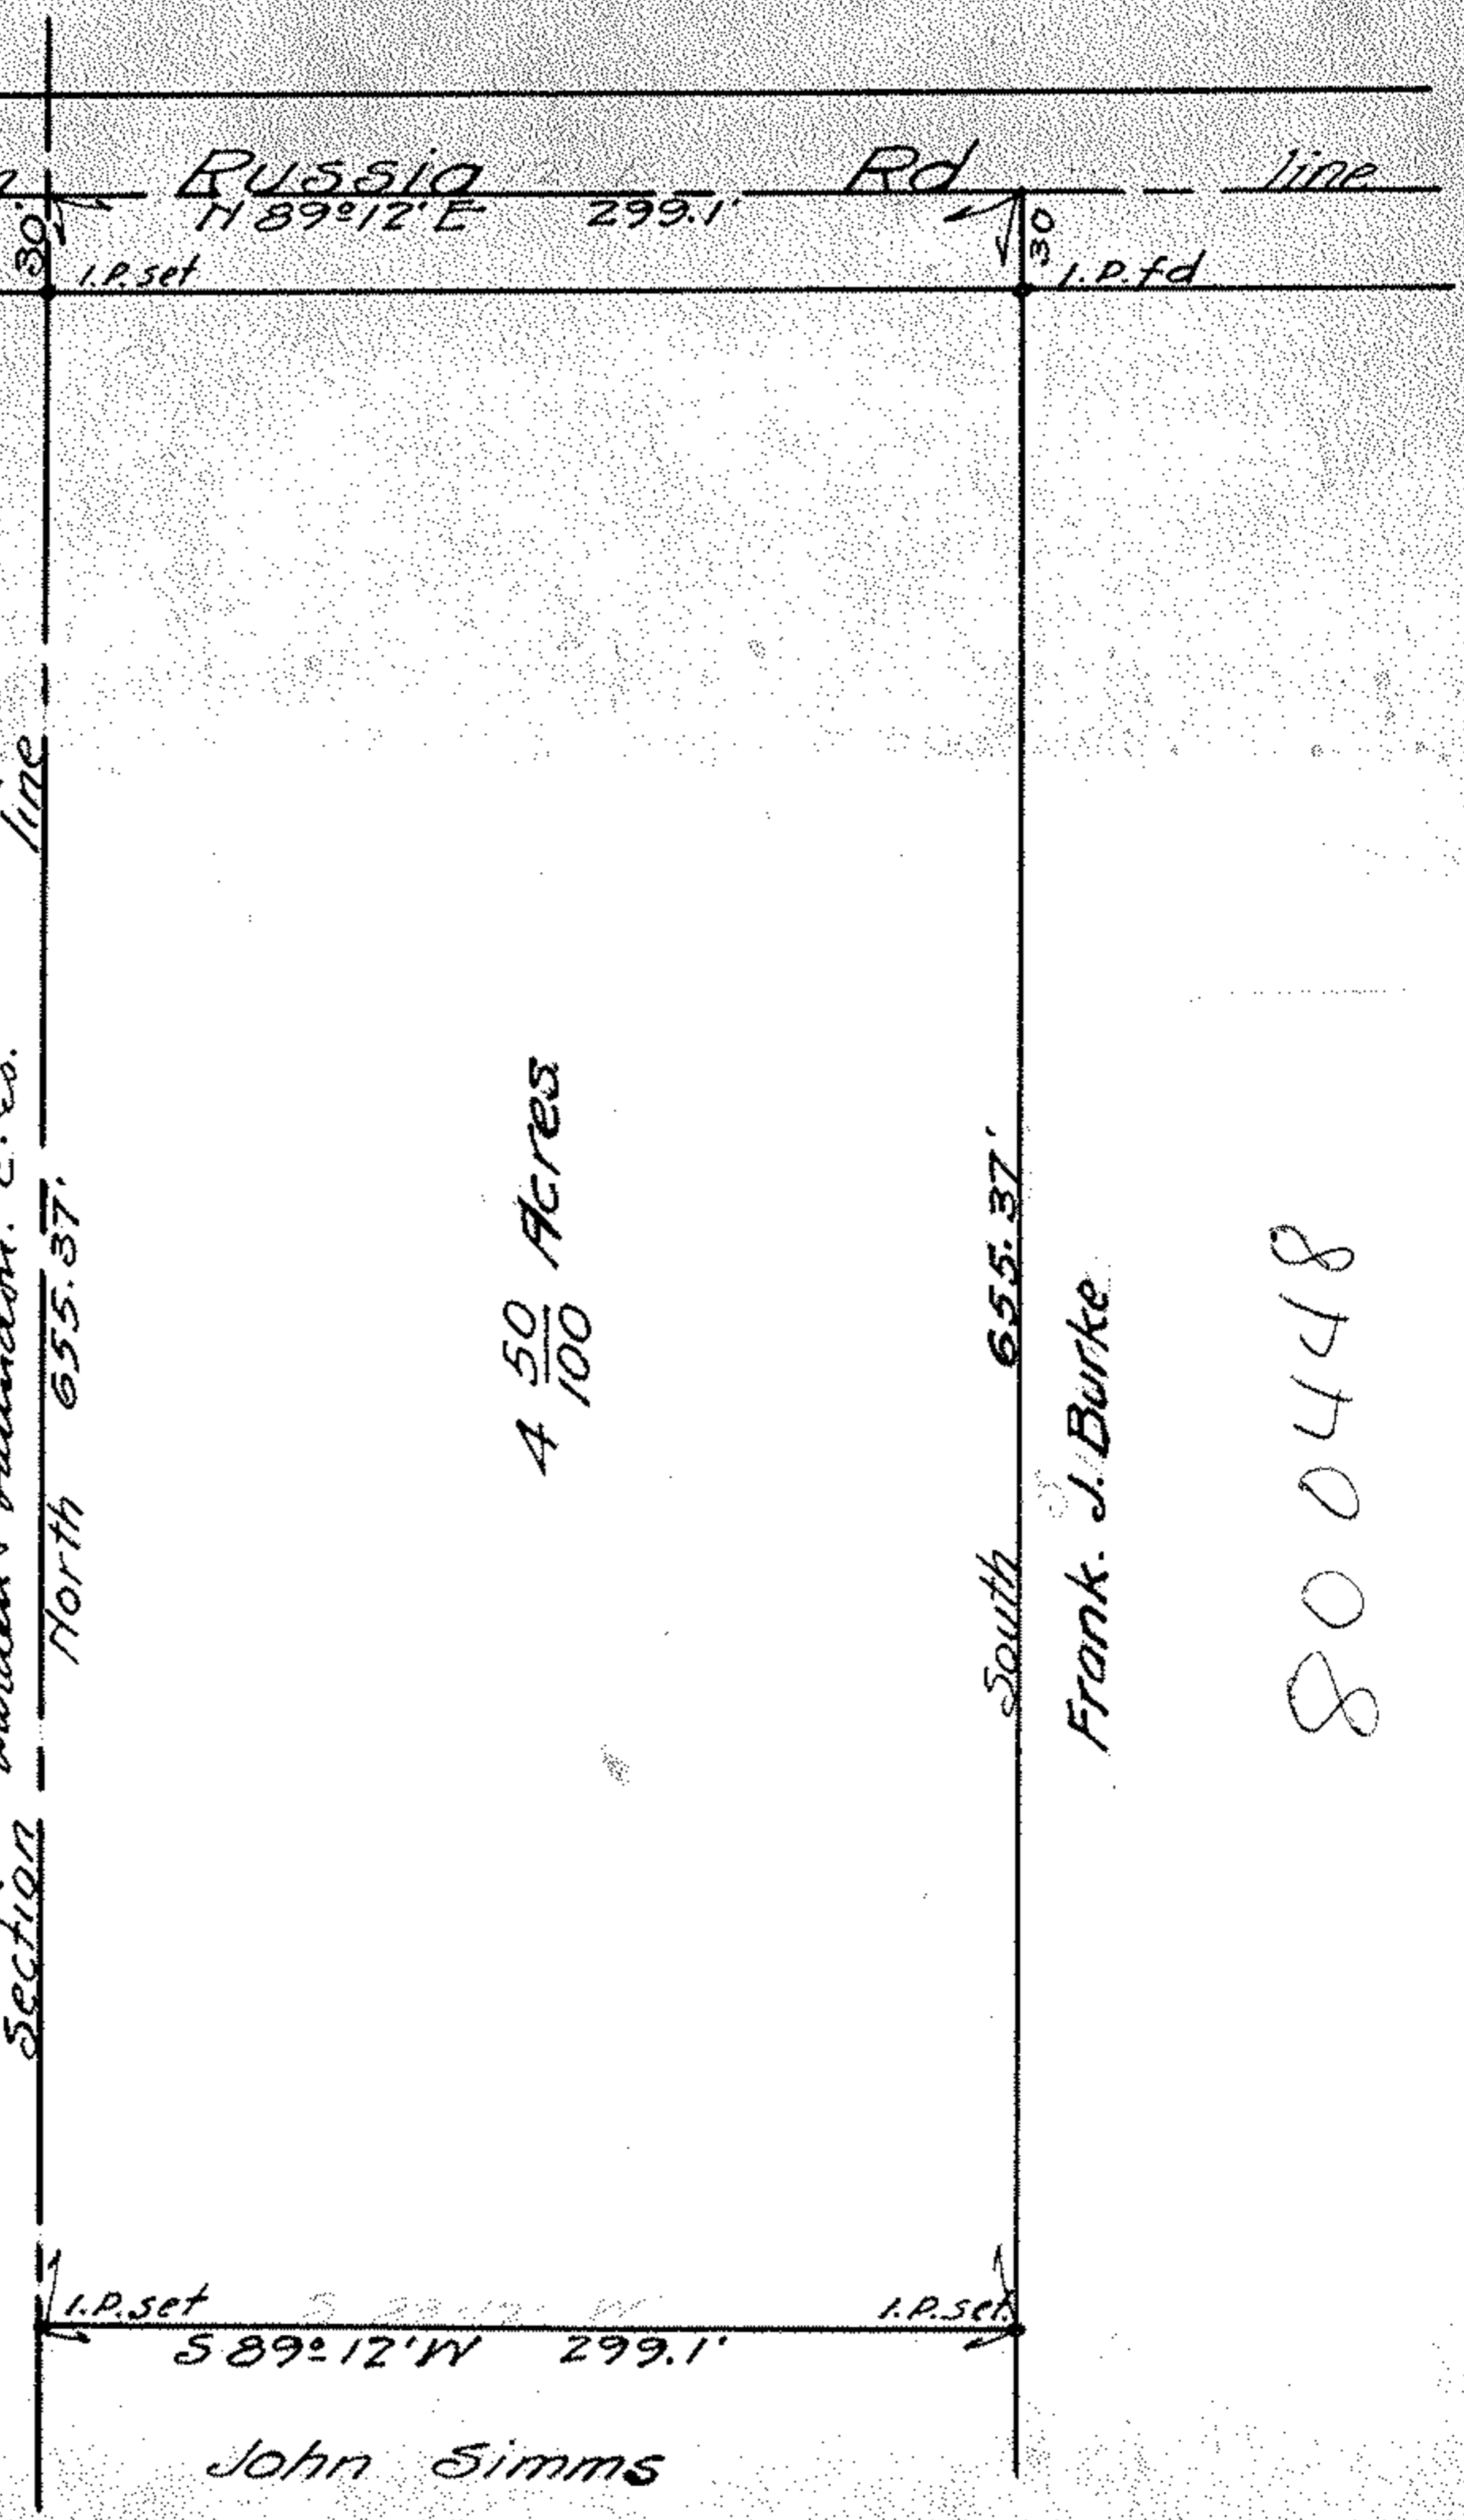

800448

8-11-8