


8-122

800155

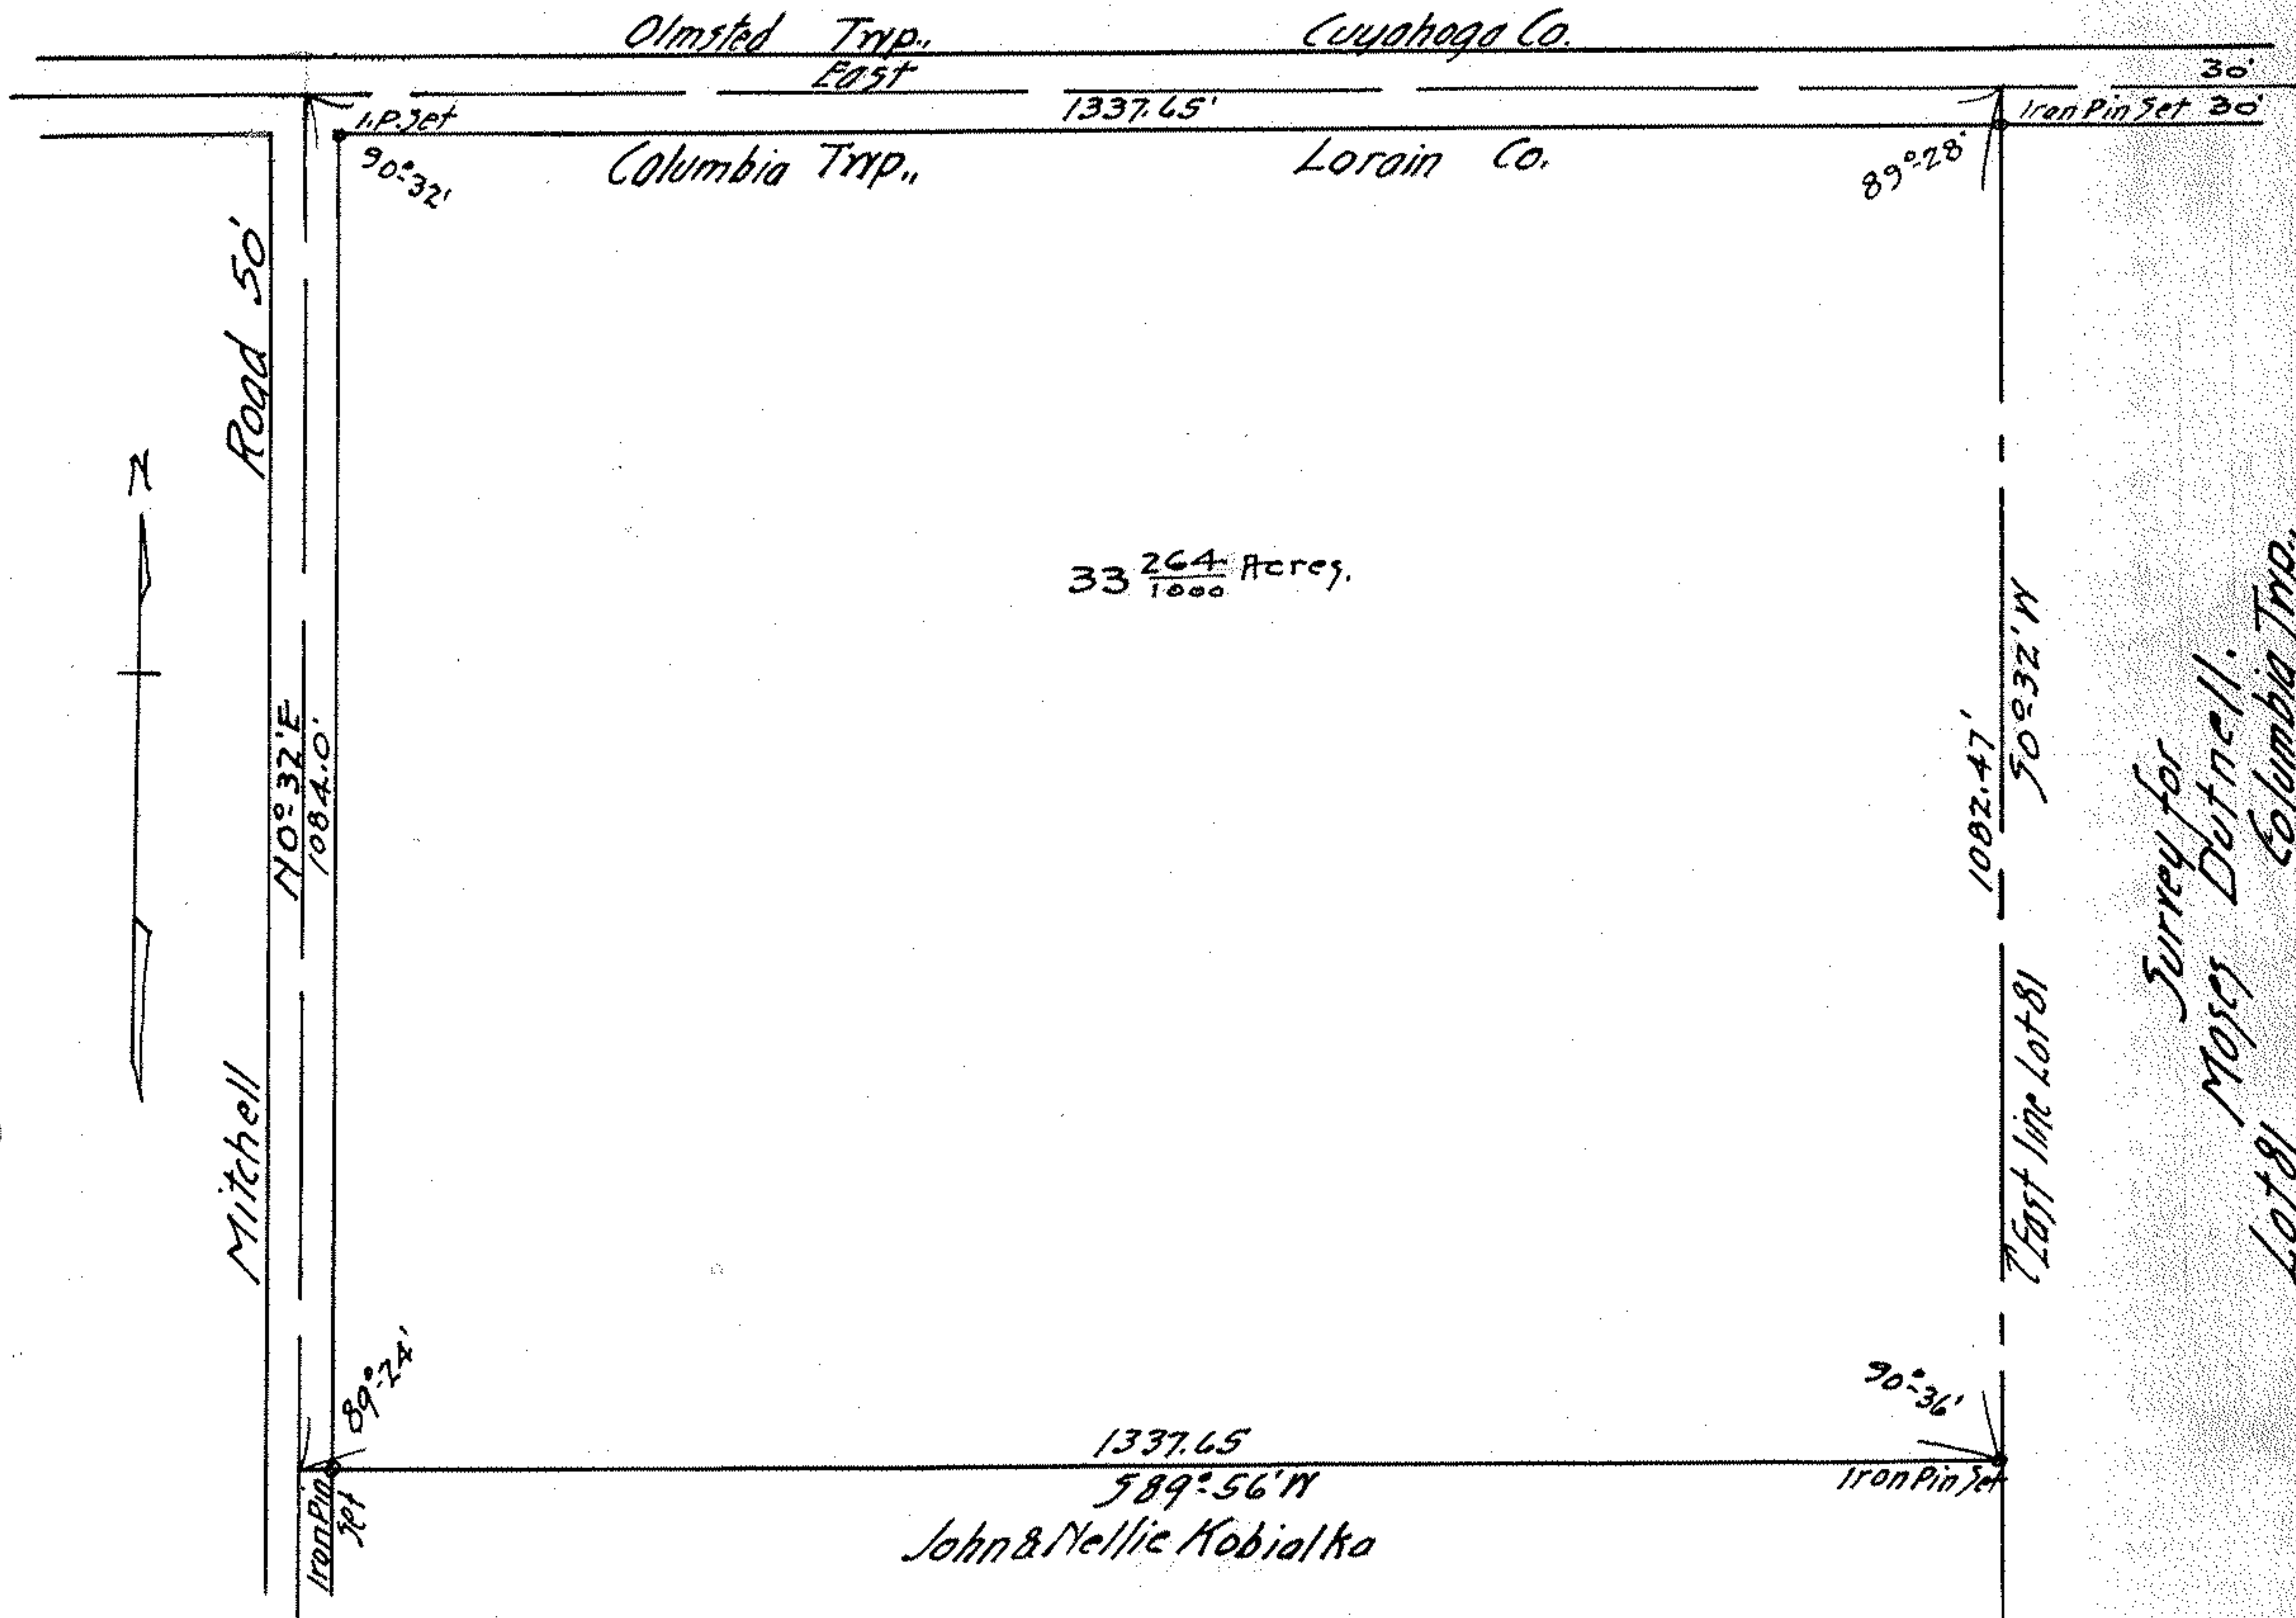

Survey for
 Moses Dutnell.
 Lot 81 Columbia Trip.,
 Lorain Co., Ohio.
 July 26, 1920.
 Warden & Landon
 Engineers
 Scale 1 inch = 200 feet