


205-2

Survey for
John E. Hand
O.L. #20-Tr #13- Henrietta Tp.,
Lorain Co., Ohio
Nov. 9, 1914. T.L. Gibson C.E.

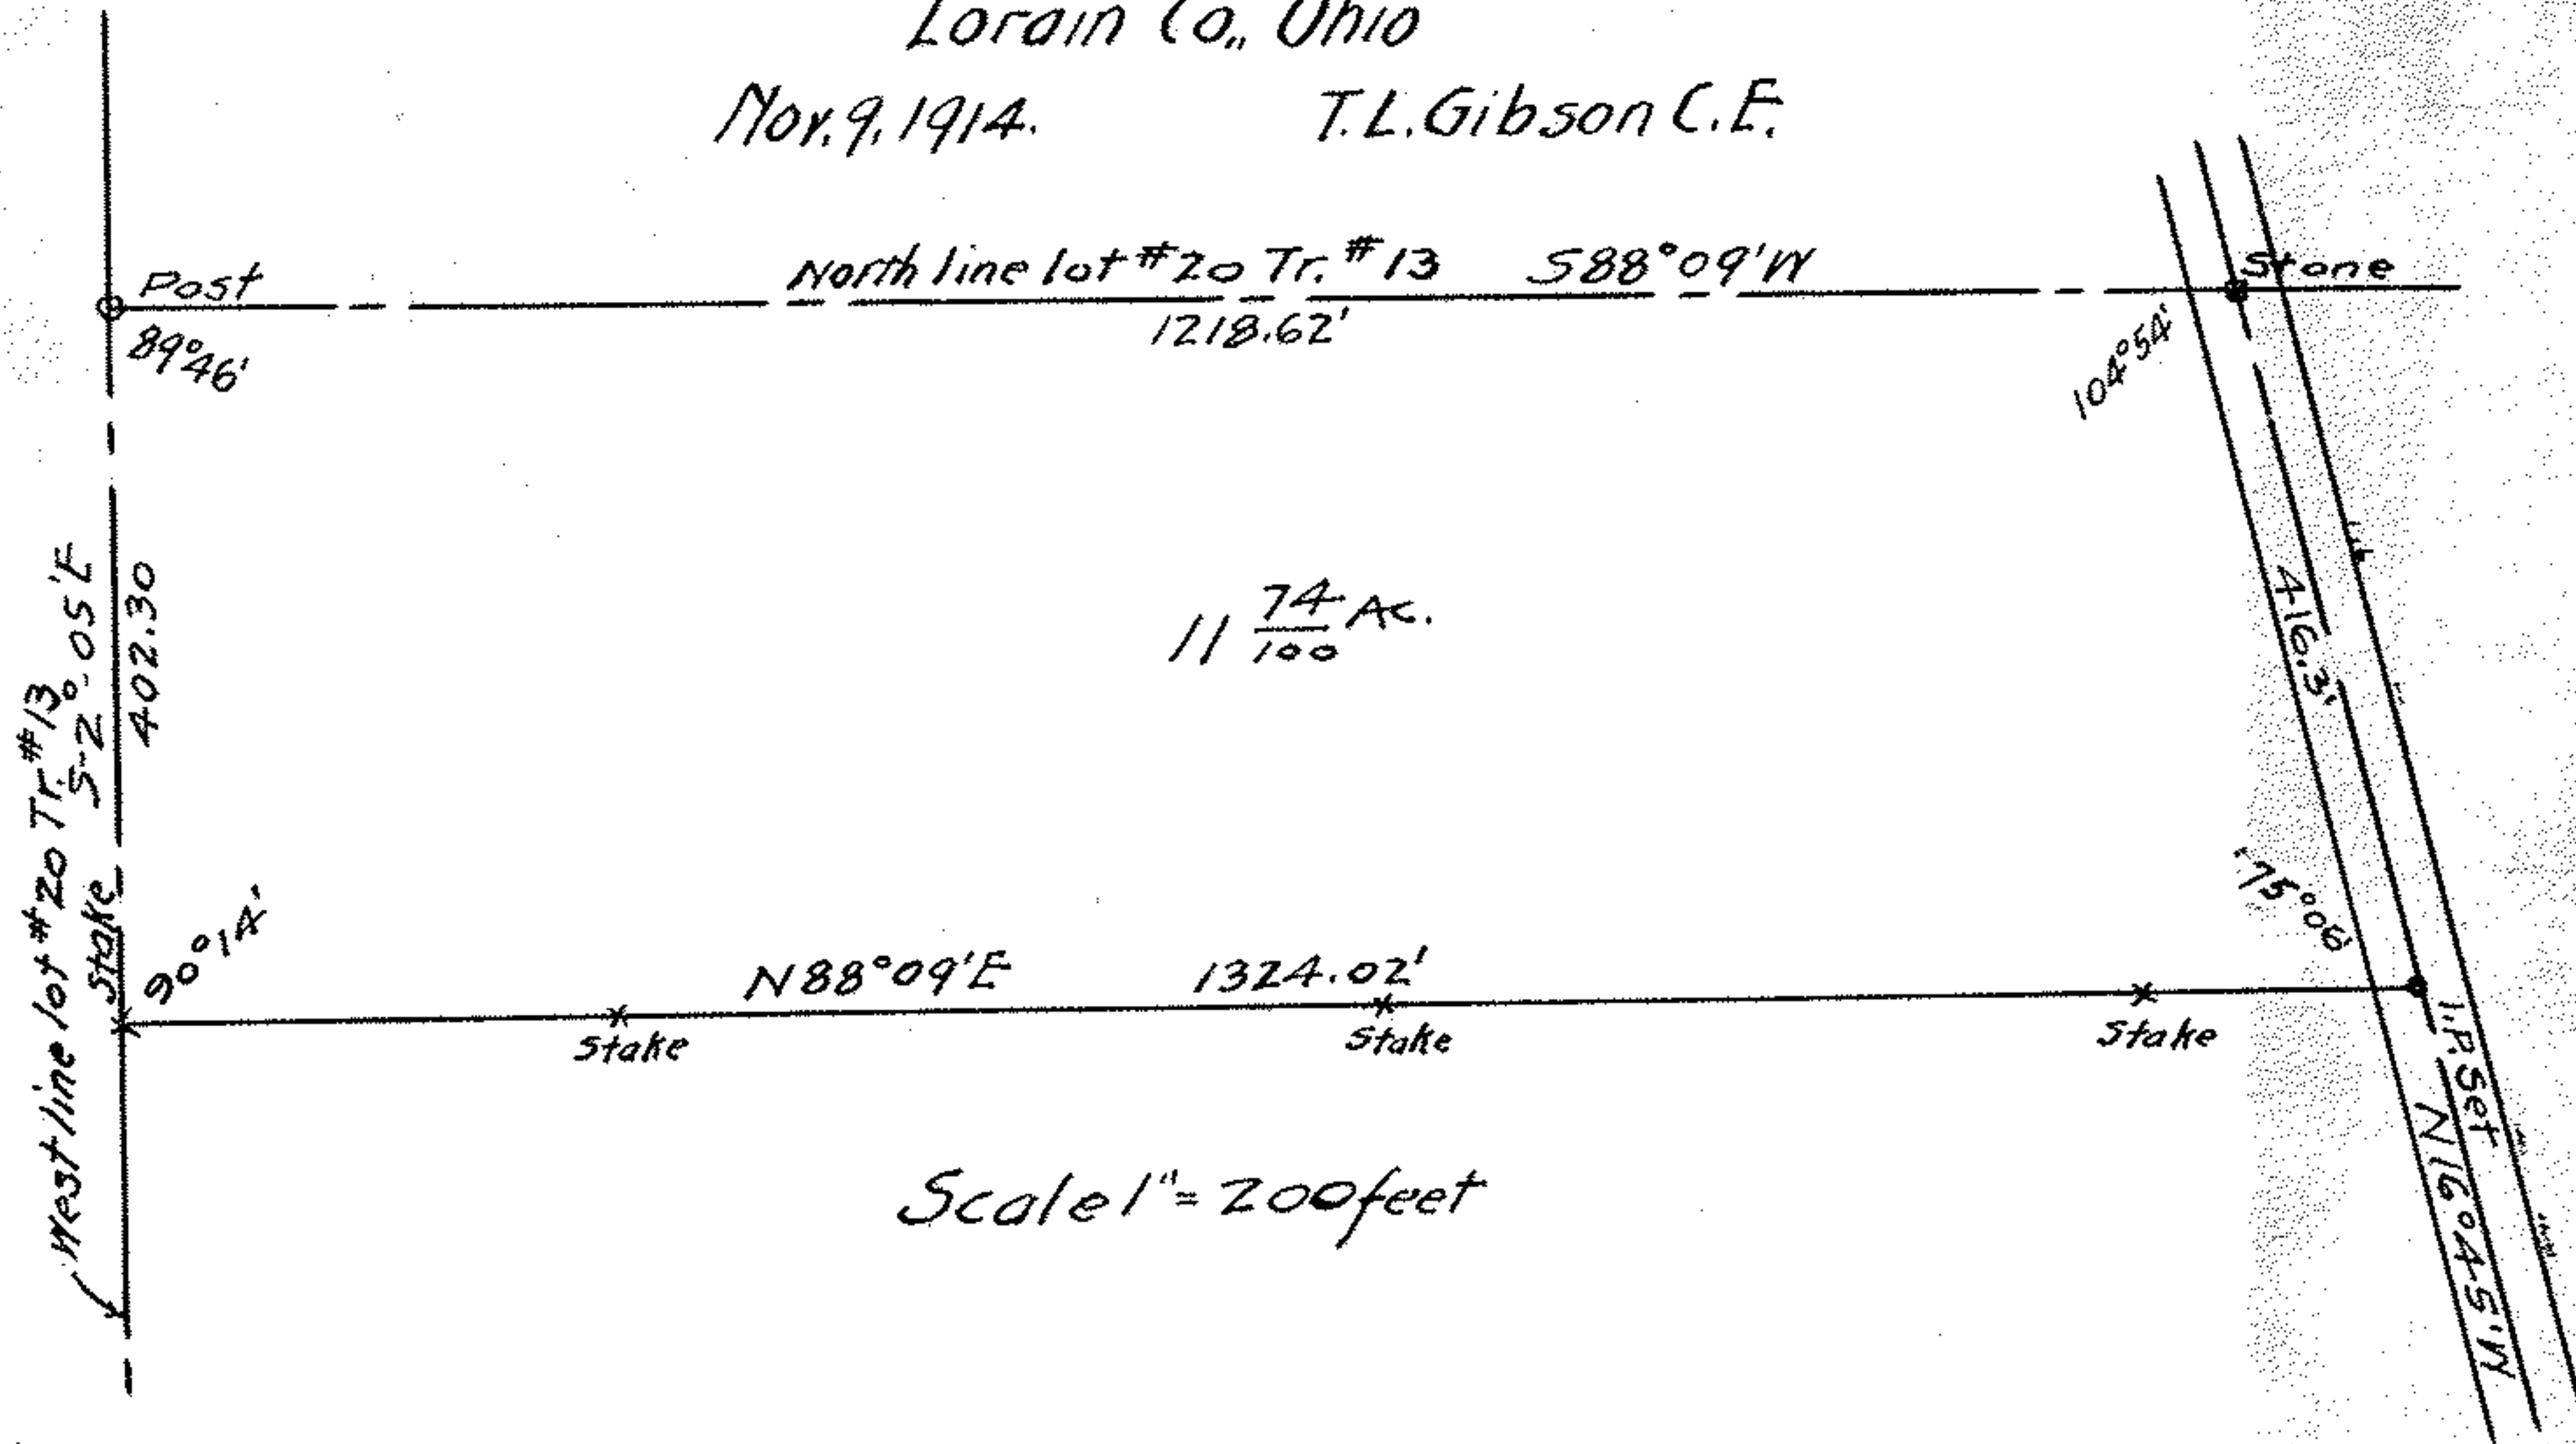

Scale 1" = 200 feet

900205