

MAP 23 6-138

PPN 06-25 003-103 025
HRC
028



SURVEY FOR
ADELIA M. HOSKINS.

Out Lot #3. City of Elyria.

Lorain Co. Ohio.

July 7, 1913.

T.L. Gibson C.E.

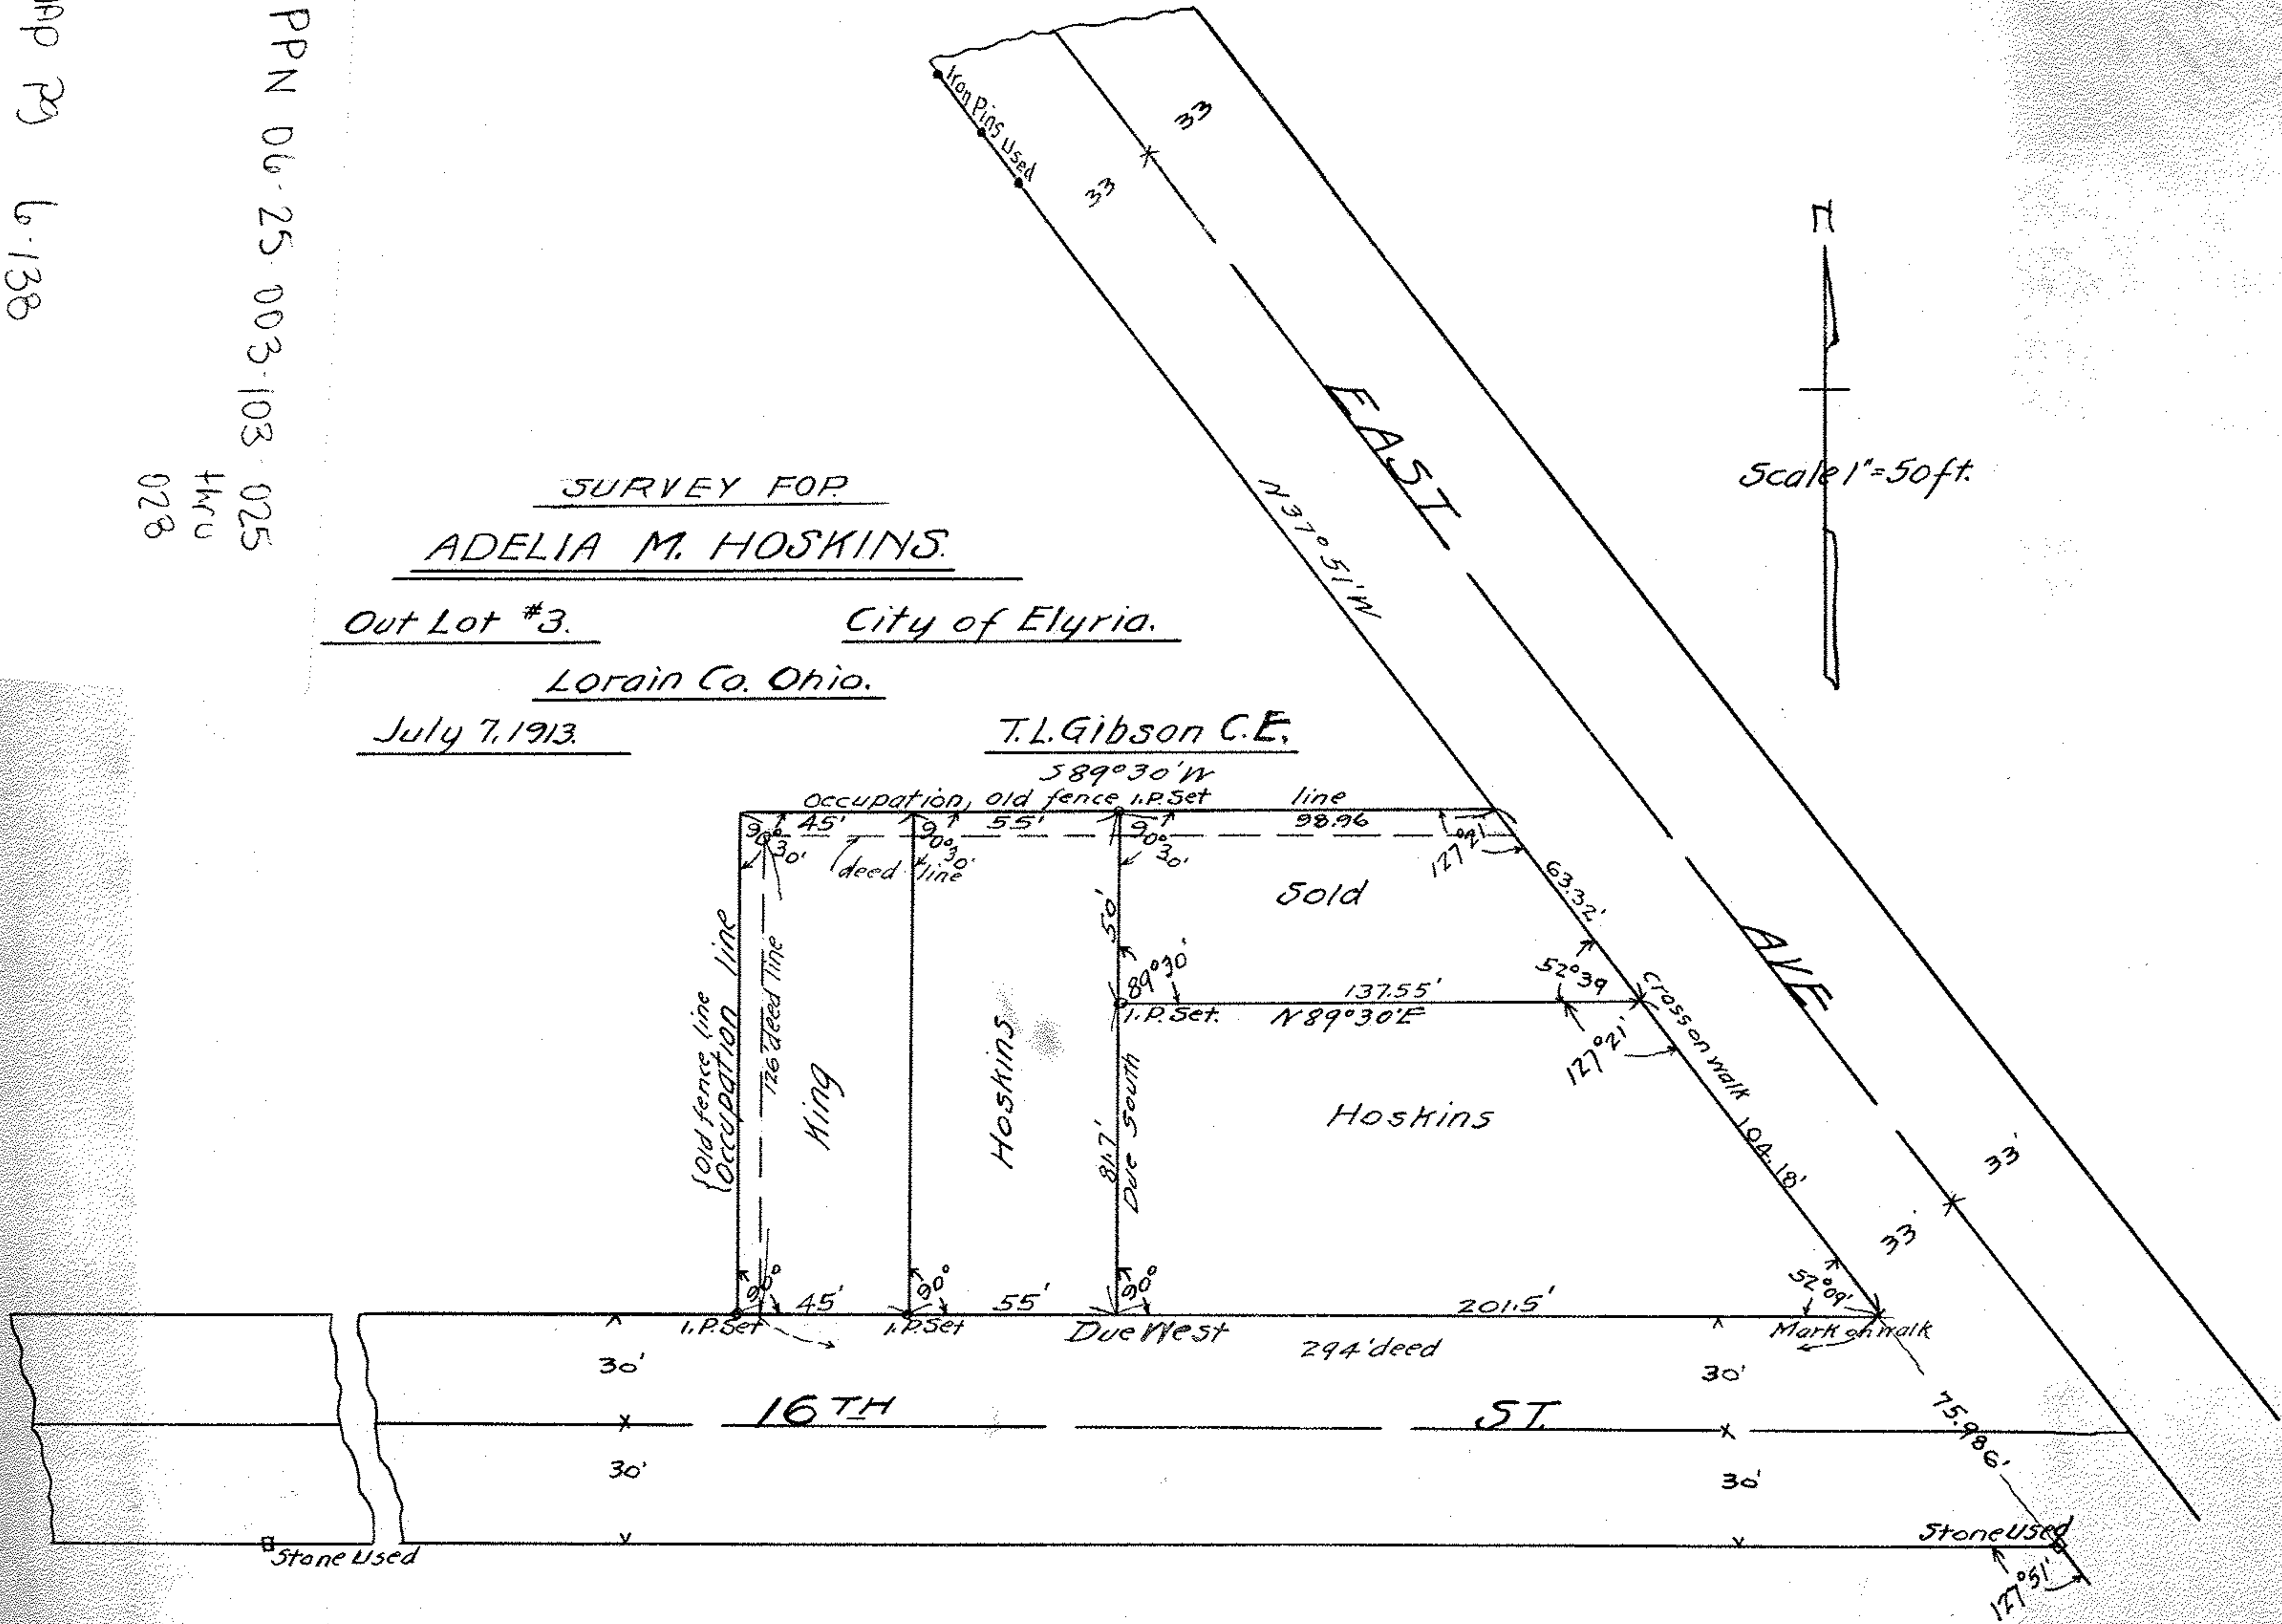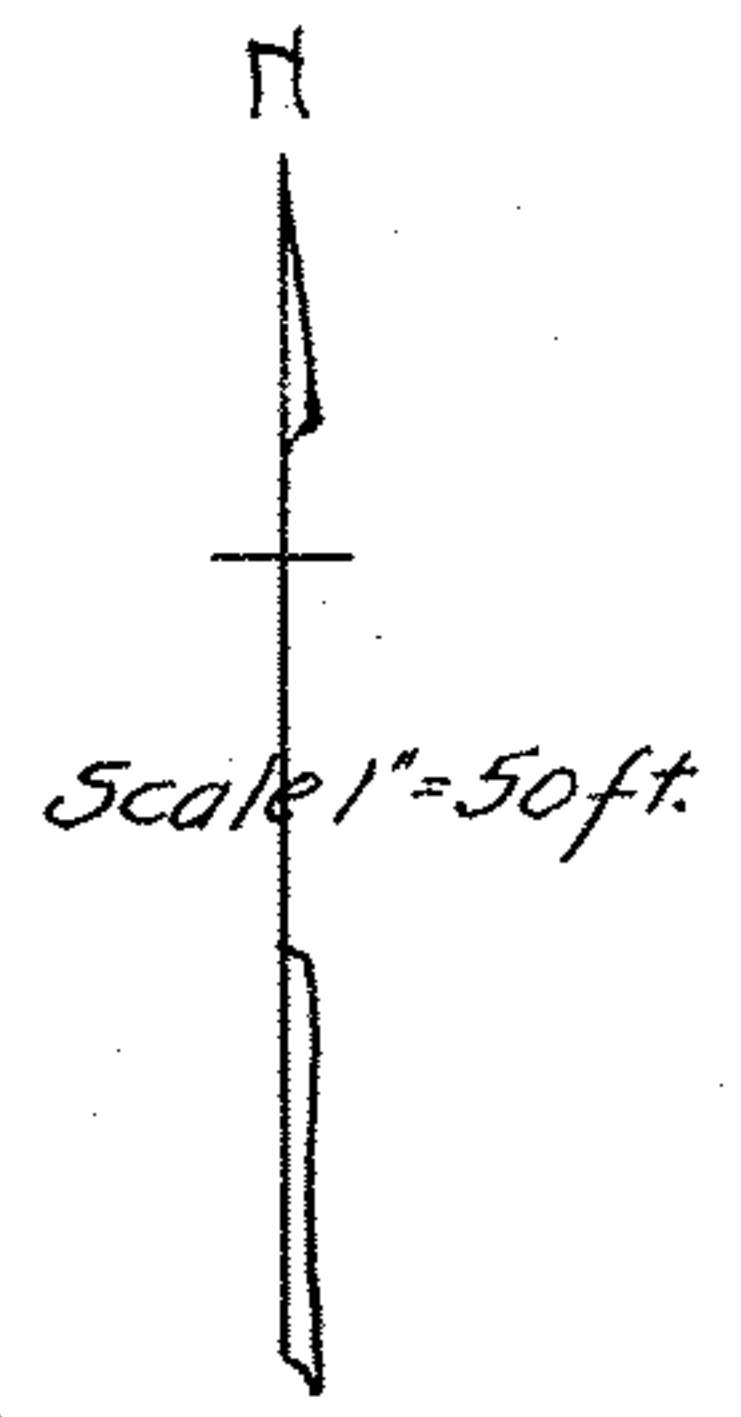

8-183