


Center Line

New York Central

Railway

PPN 05-00-018-107-011
025
026
028

MAP PG 05-00-018-A

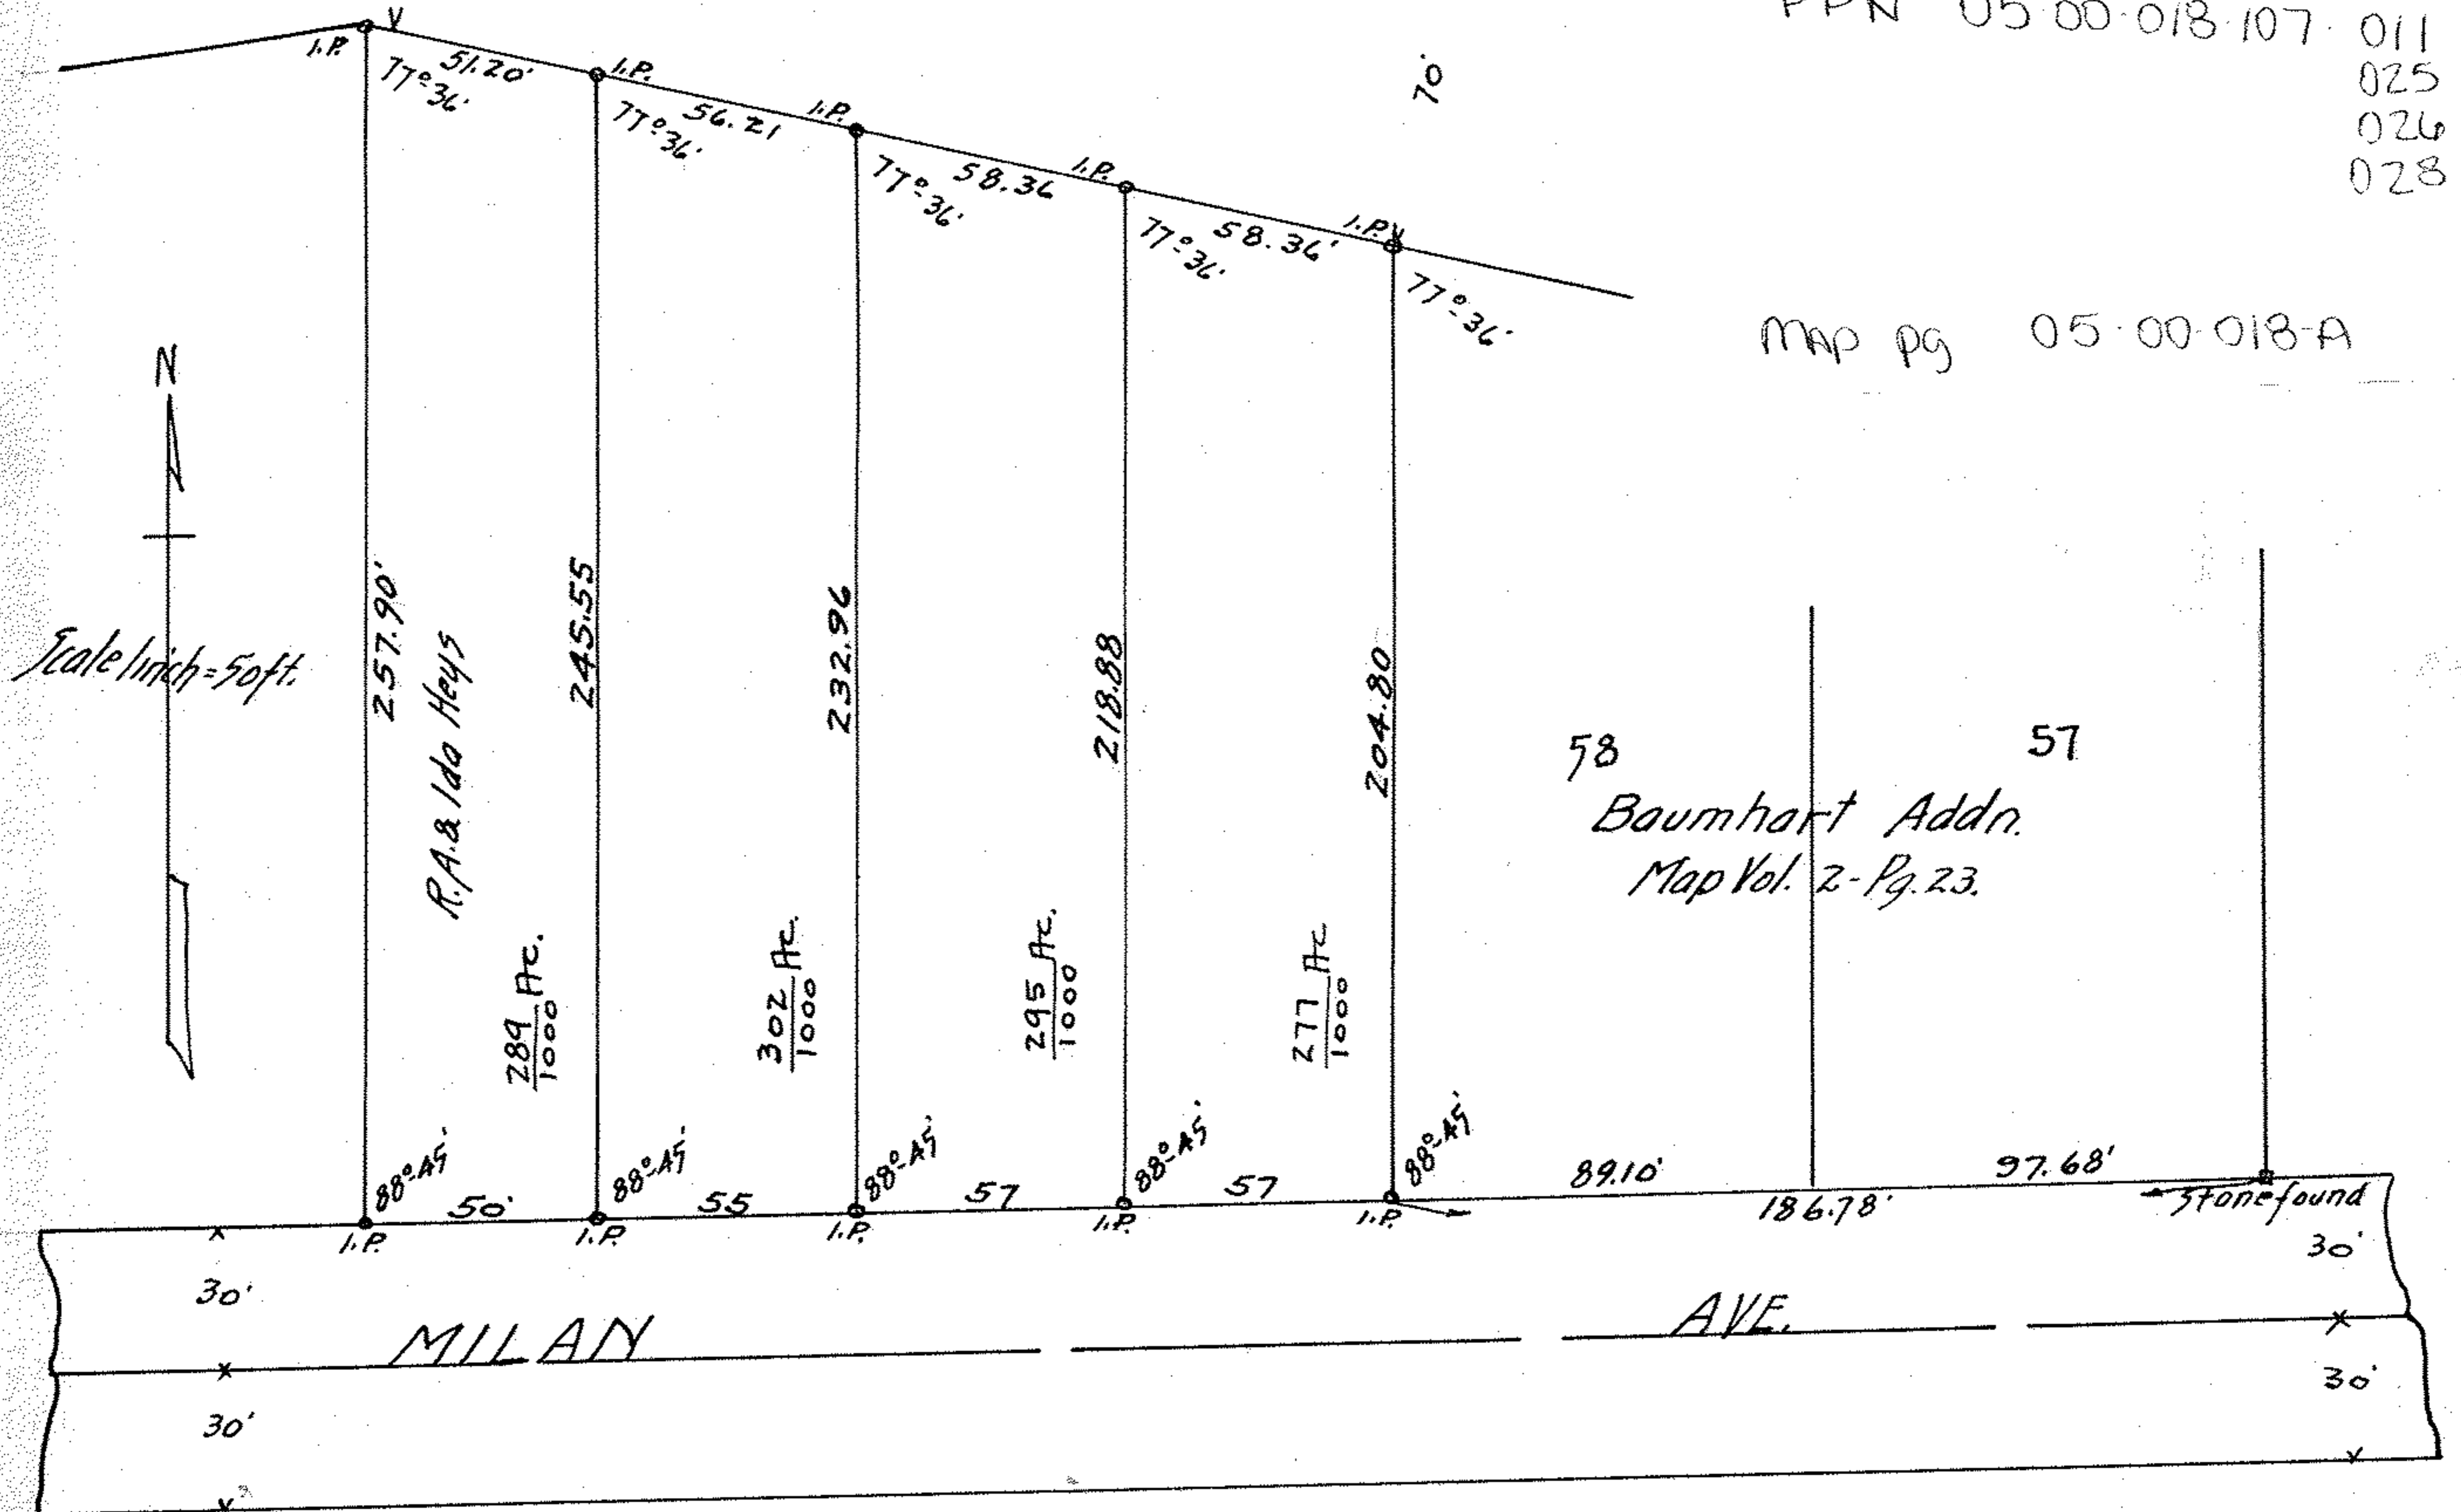

Survey for
 Paulina Winterberger
 Original Twp, Lot 18. Amherst Twp.,
 Lorain Co., Ohio.
 Amherst Village.
 July 30, 1920. Warden & Landrum
 Engineers.

711.8