

Survey for
 John & Mary C. Wiegand
 Original Twp. Lot #17. Amherst Village
 Lorain Co., Ohio.
 May 8-1914. T.L. Gibson C.E.

Total Acreage	= 8.30 Ac
Road	" = .17 Ac
P. Sabiers	" = .178 Ac
J. "	" = .167 Ac
Remaining	" = 7.785 Ac


800109

Emma E. English

Anton Stinwald

PPN 05-00-017-000-7??

MAP PG 05-00-017-A

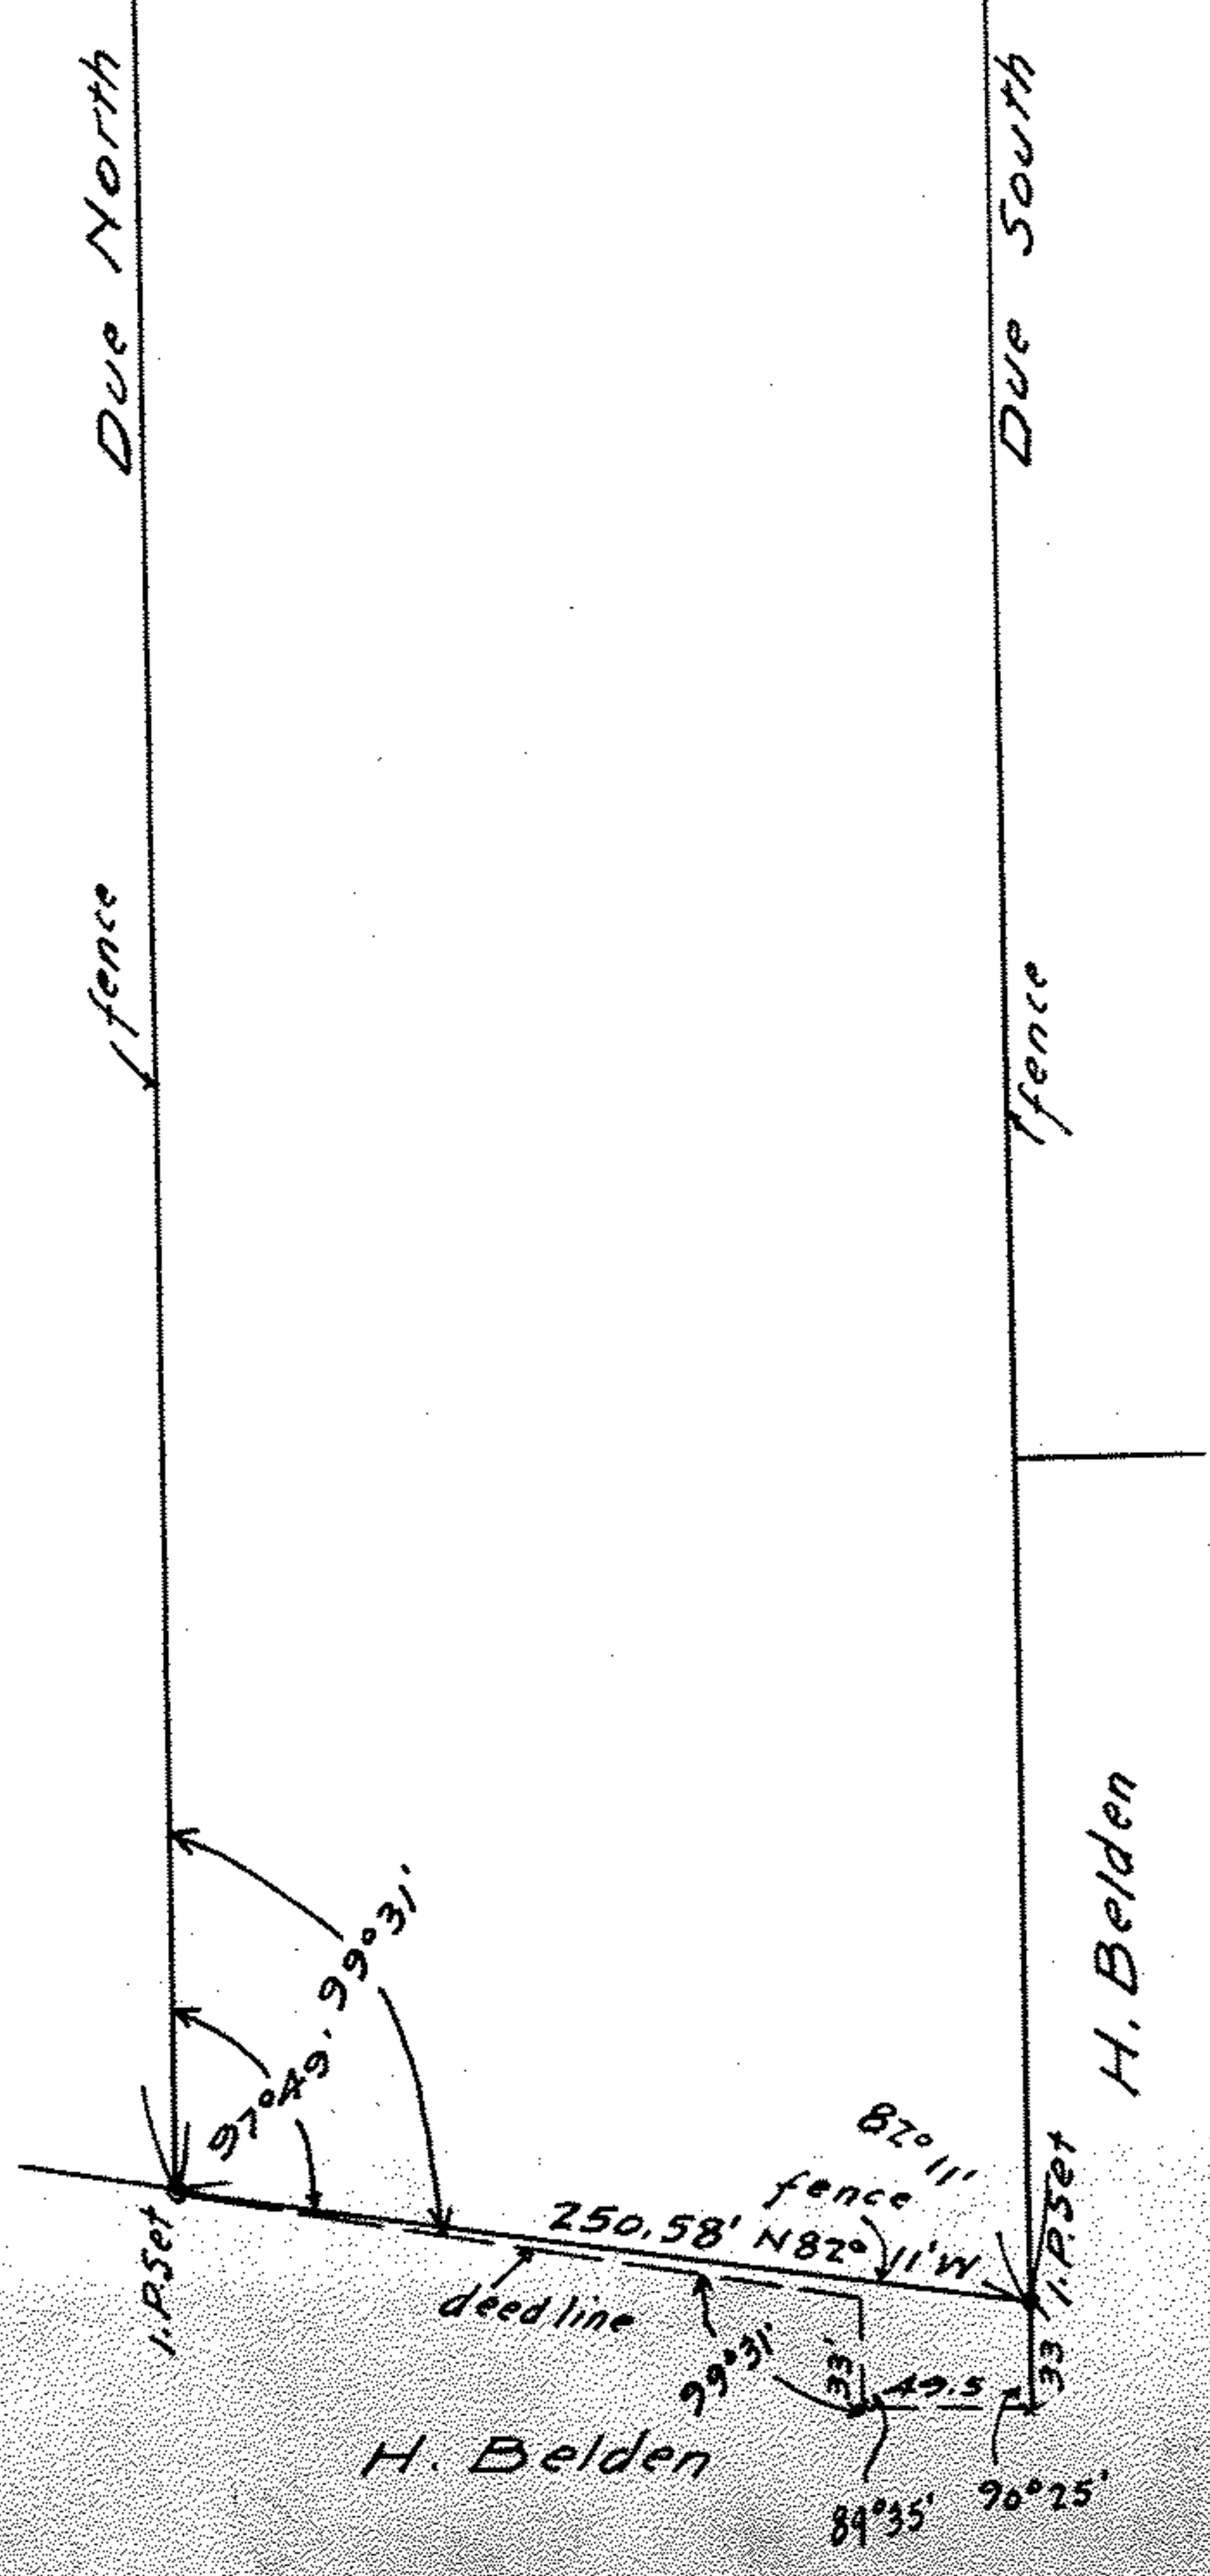

H. Belden