


8-137

Survey for Wm Damm  
Part of Lot 40 Day's Add'n  
Elyria, Lorain Co. Ohio. Apr. 12, 18. Scale 1"=20'  
Warden & Laundon - Engineers

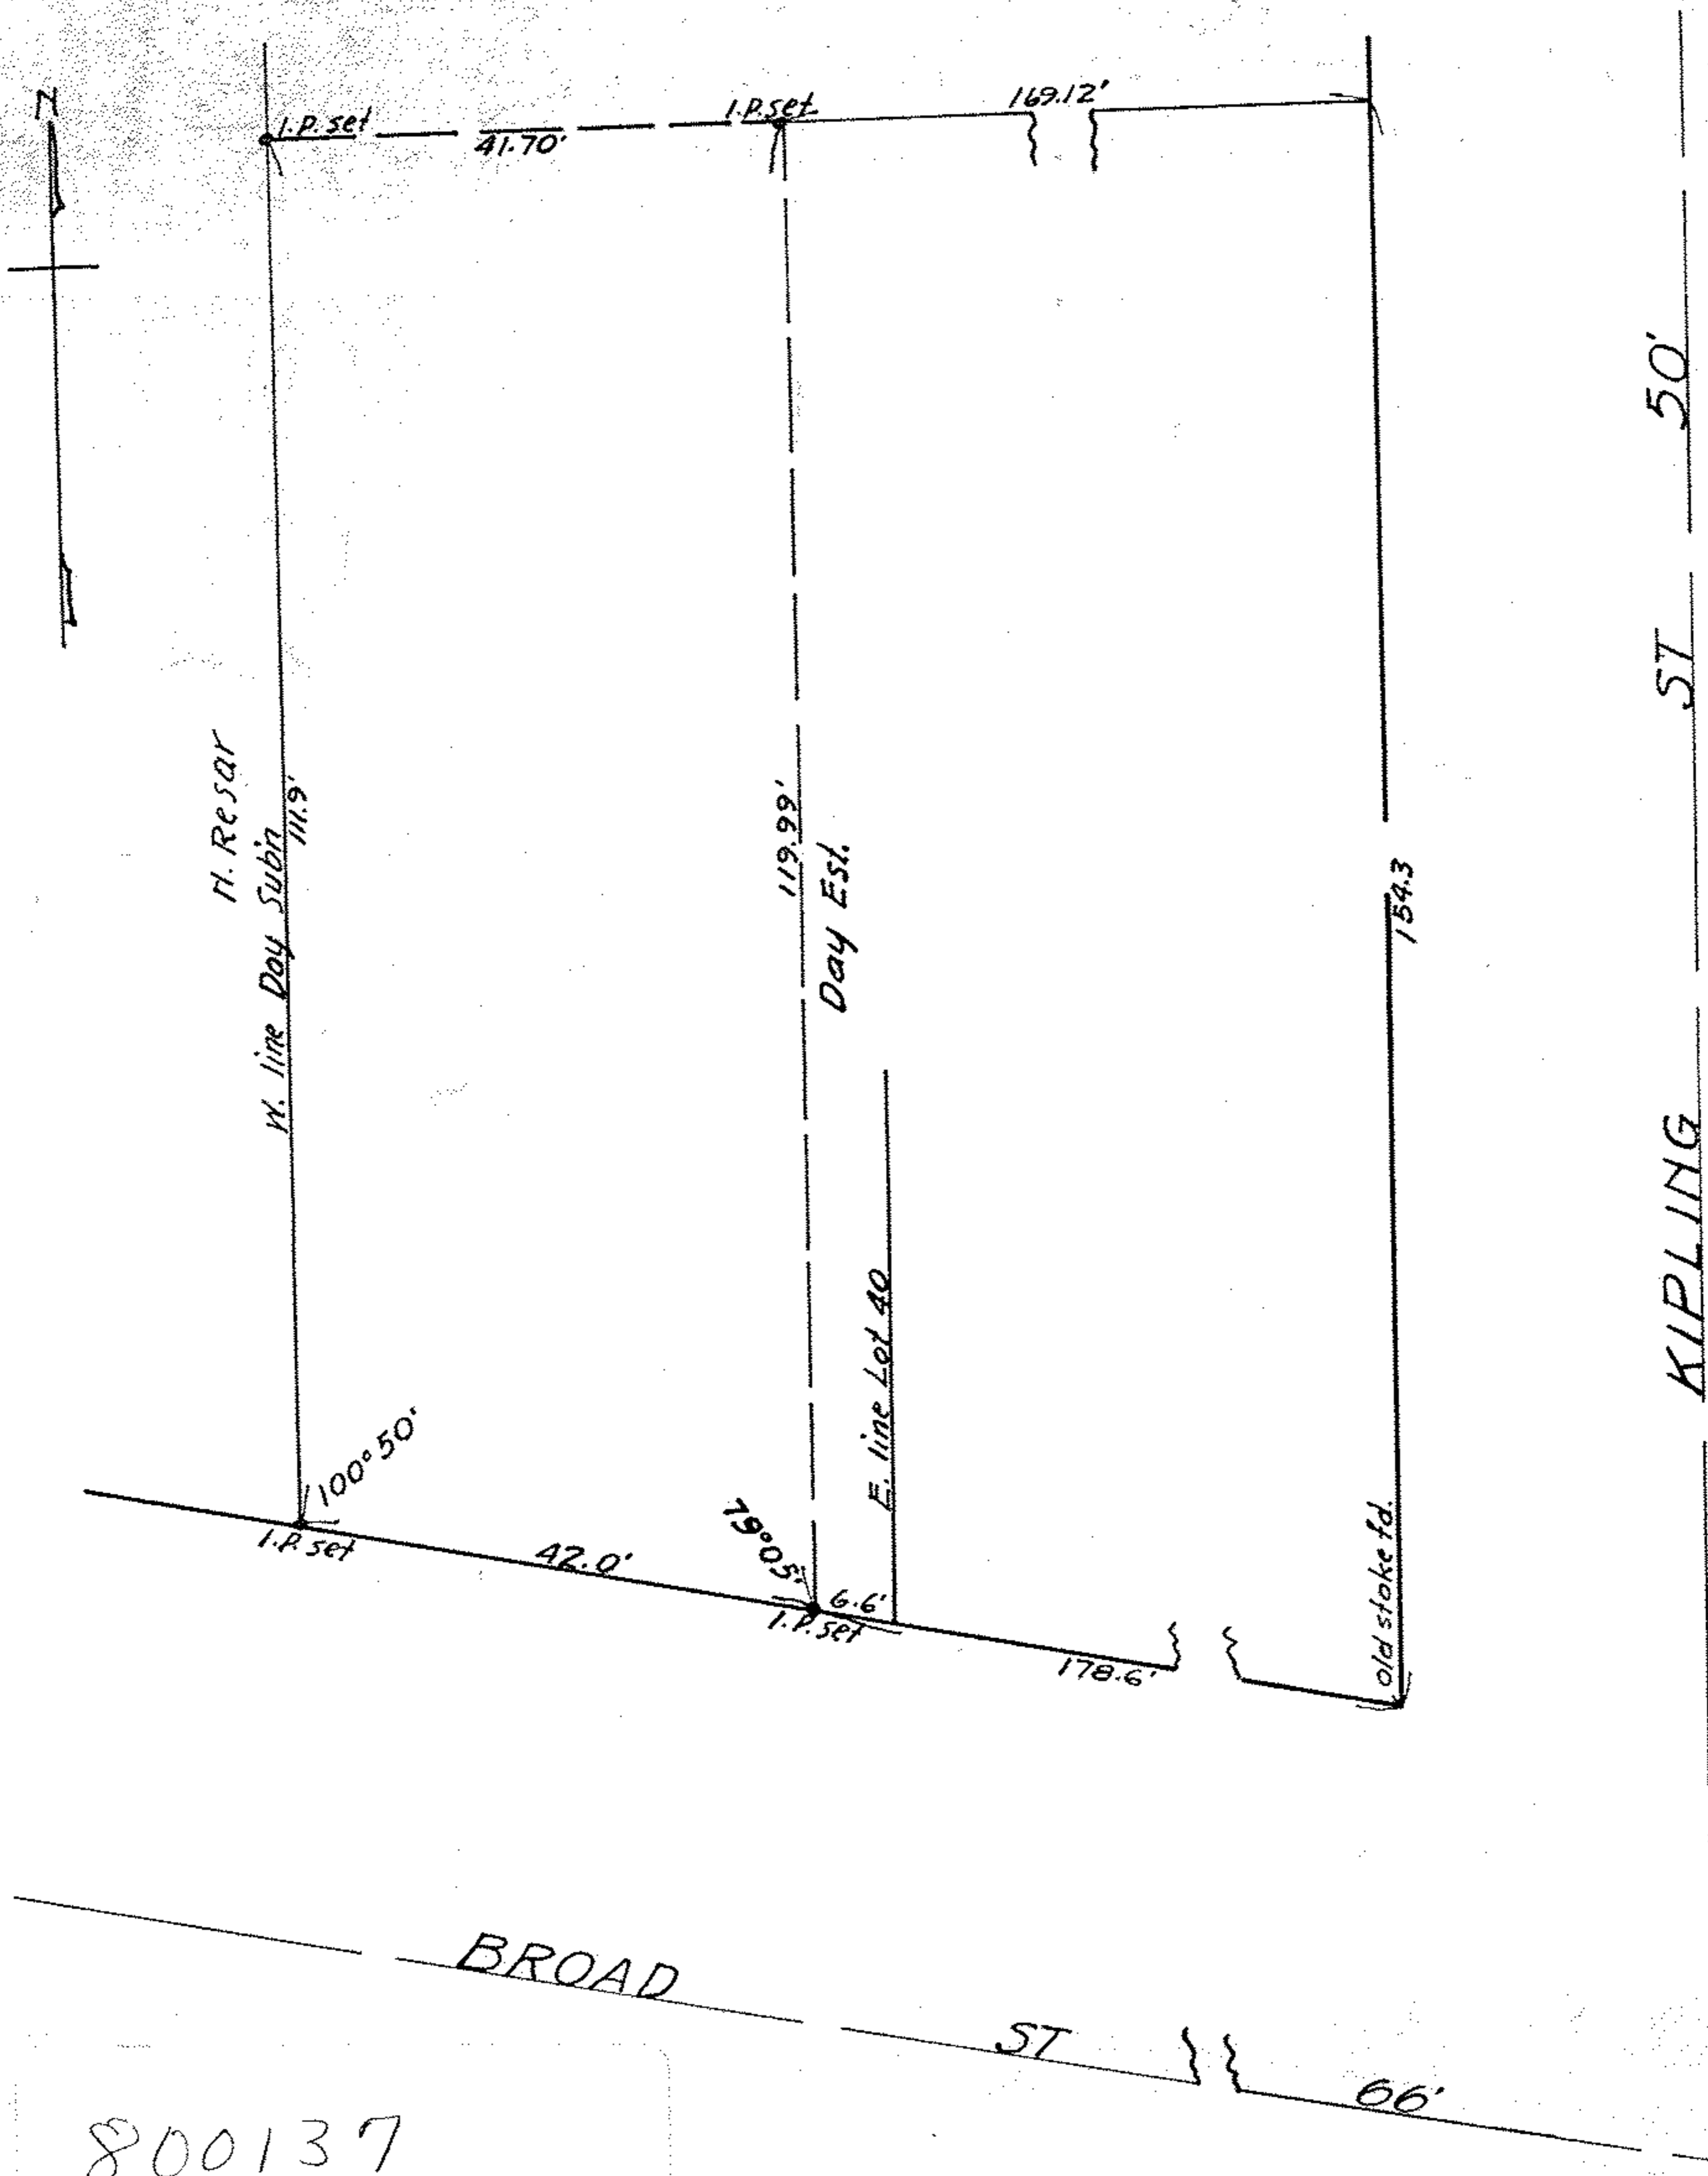

800137