


10118

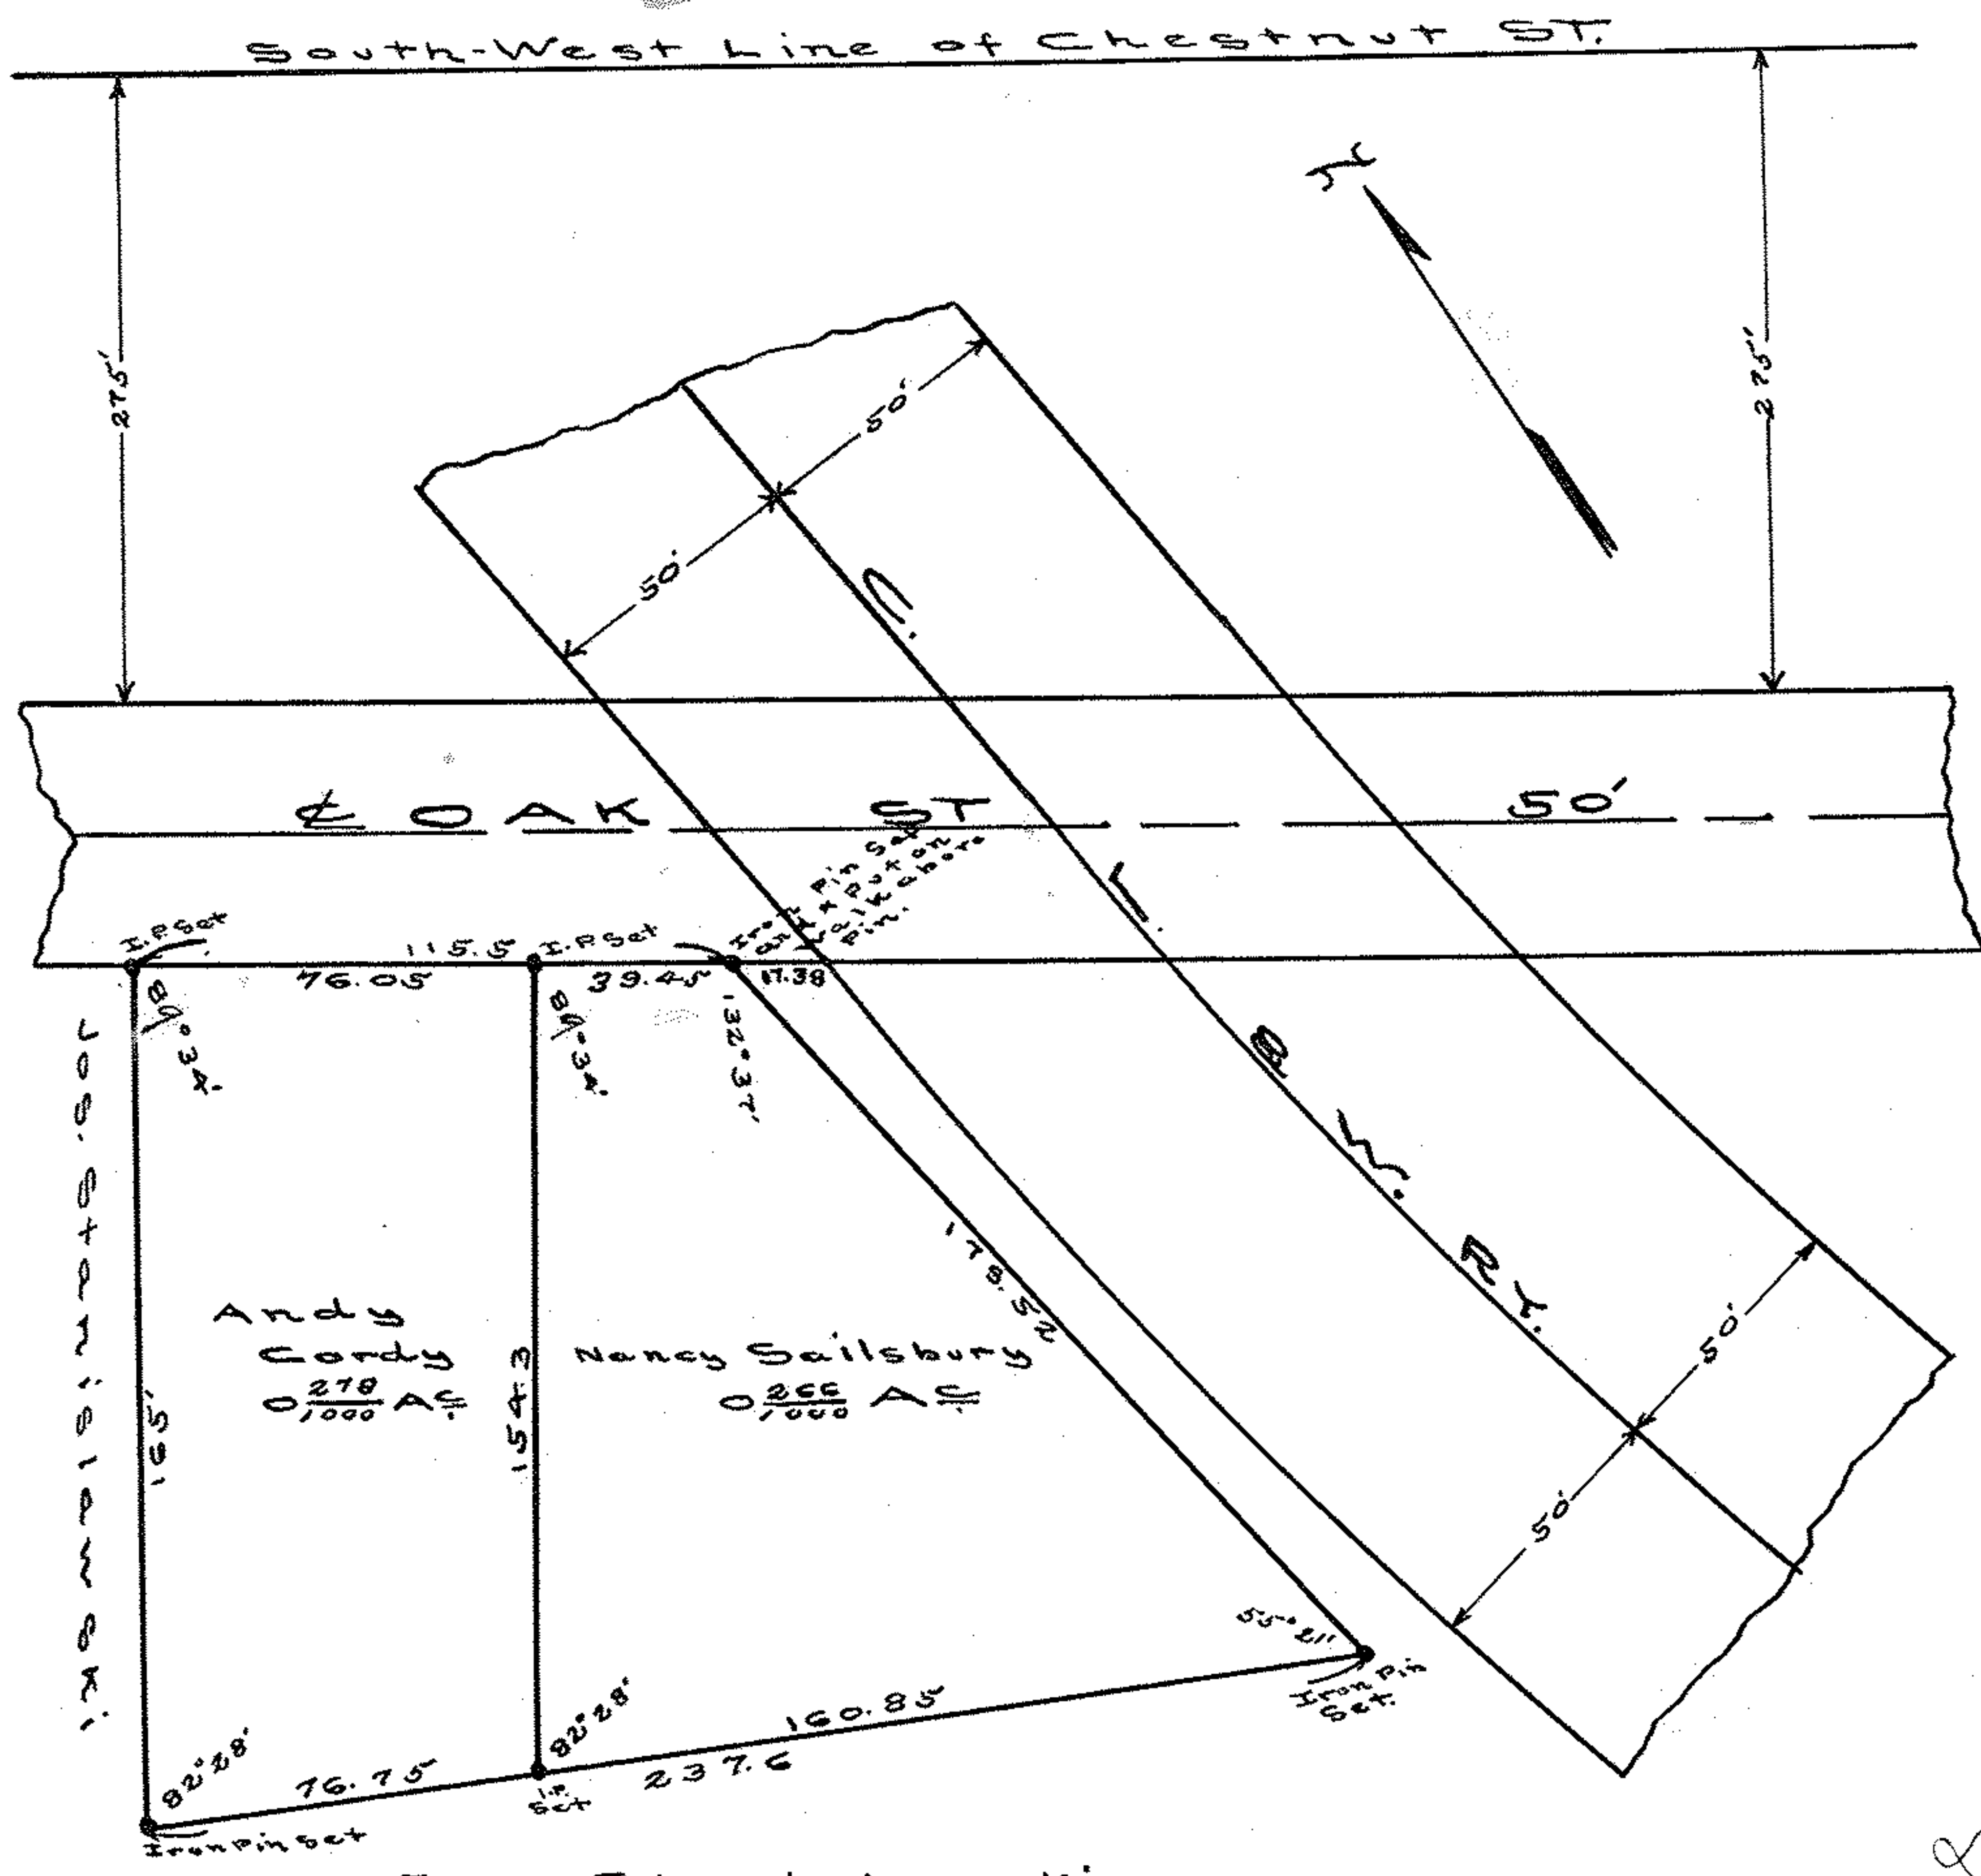

SURVEY
for
Andy Cordy & Nancy Sailsbury
in
Twp. Lot # 1.

GRAFTON OHIO.

T.L. Gibson C.E. Elyria, O., June, 14, 1913.

Scale 1"=50'

800161