


8-383

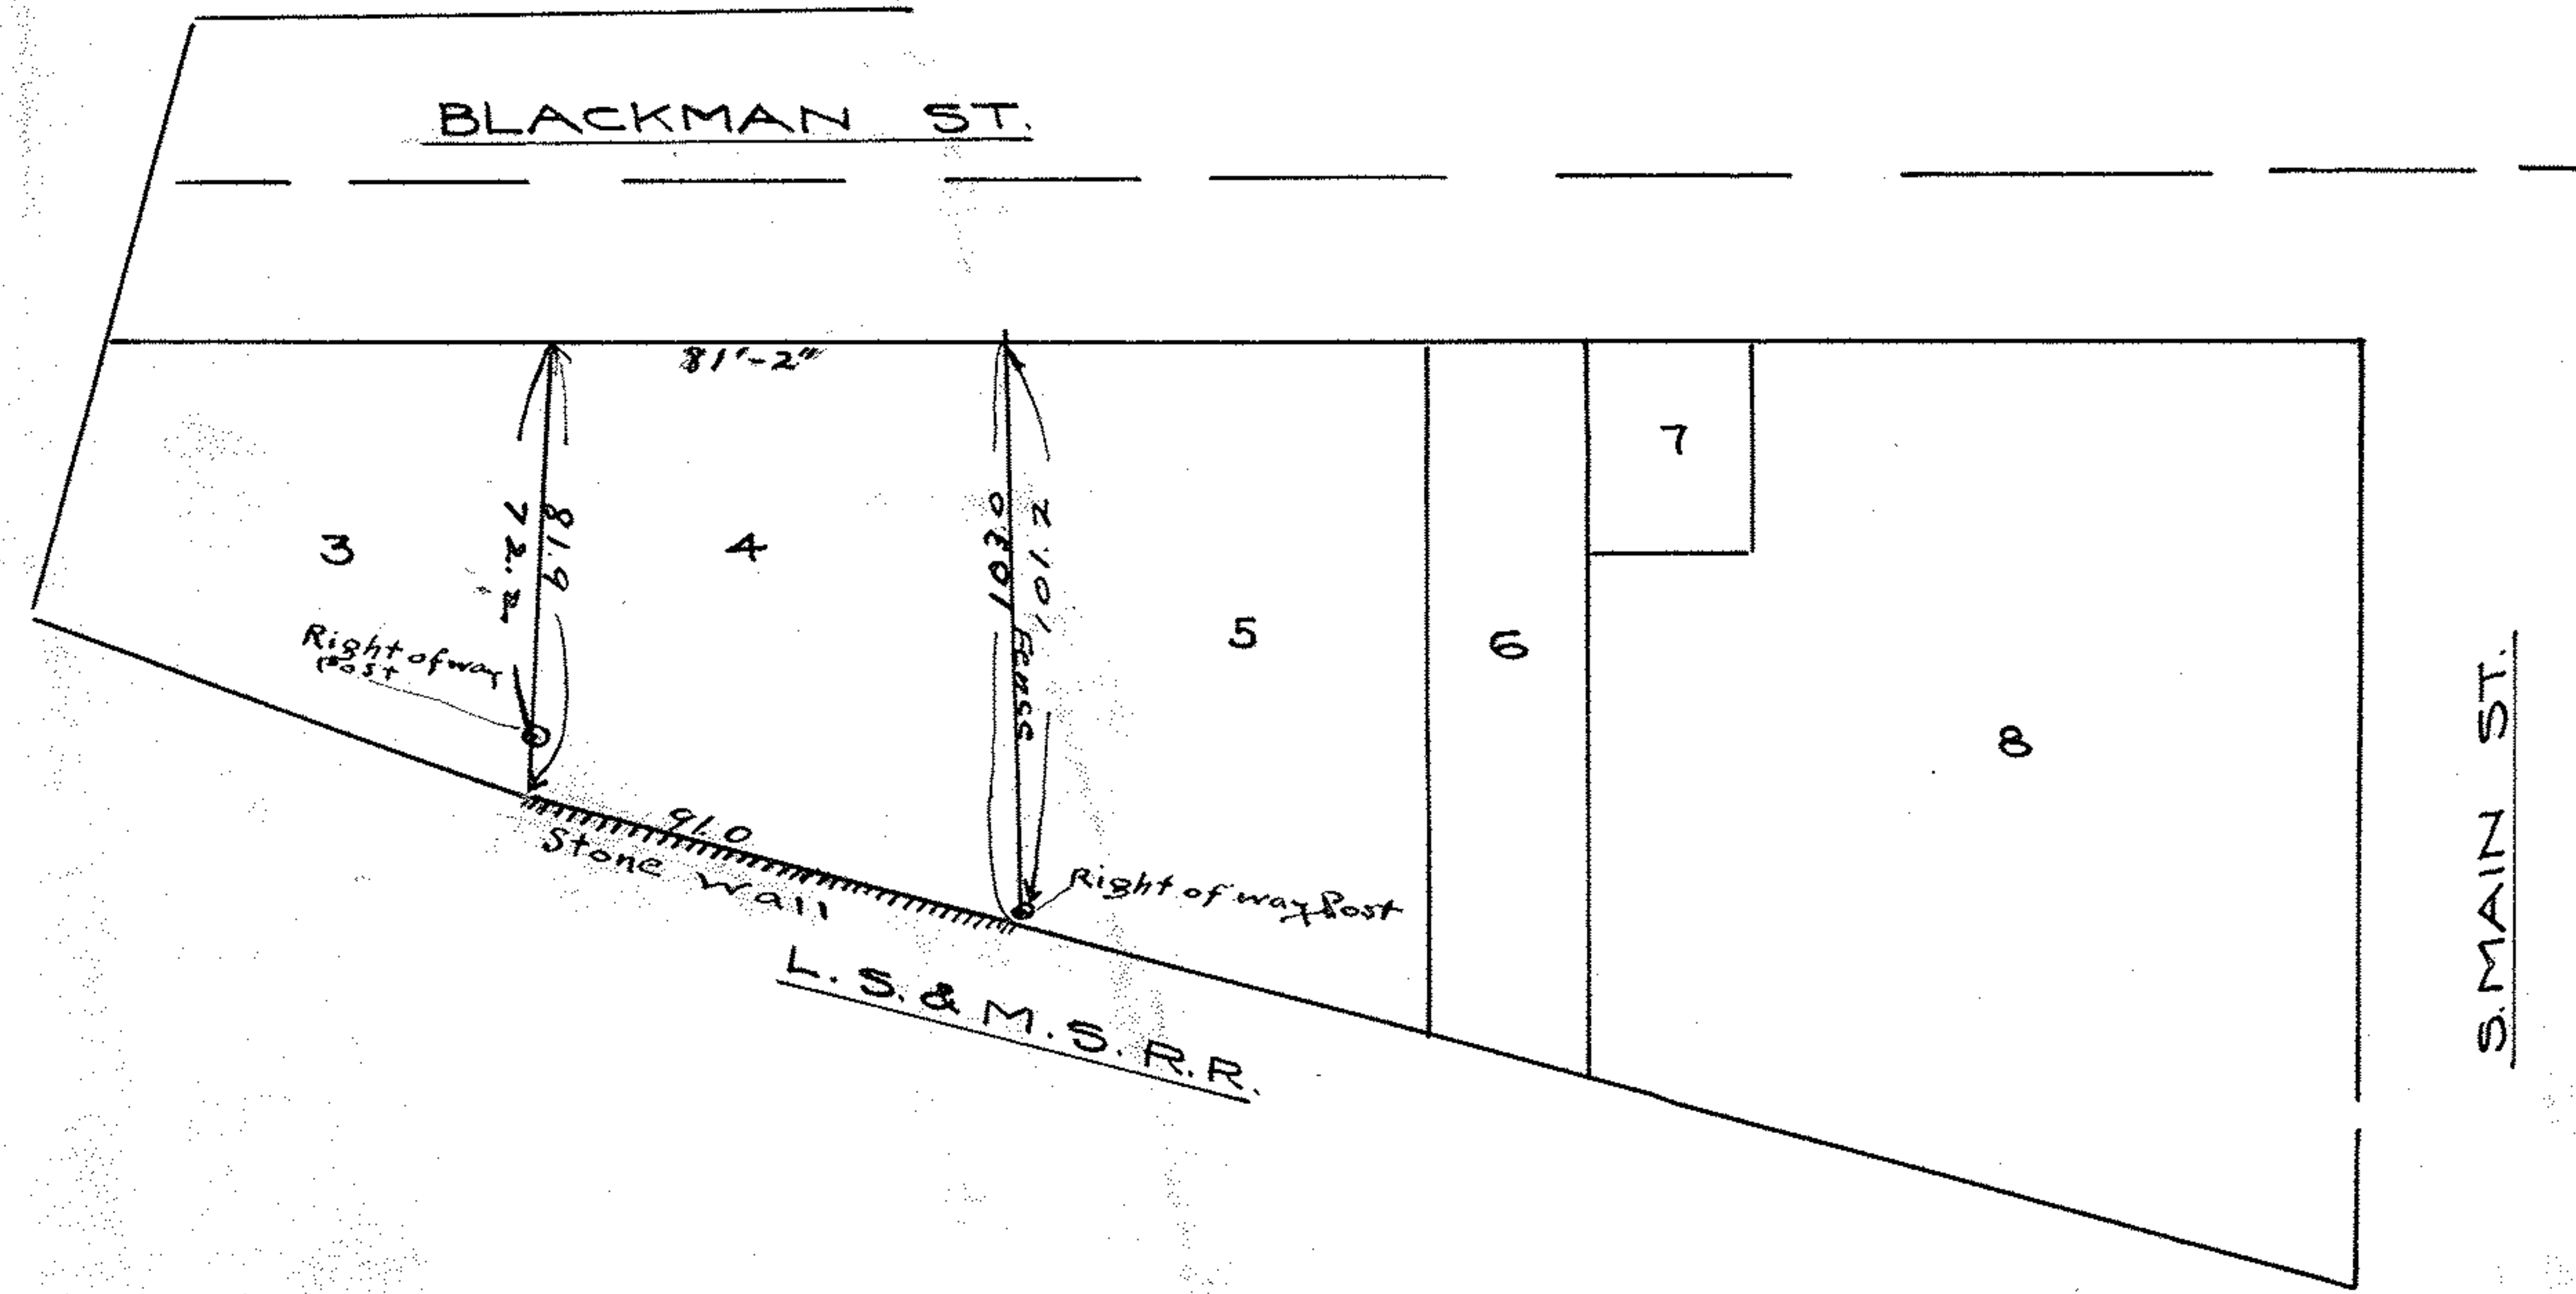

PPN 05-00-024-106-???

map pg 05-00-024-B

MEASUREMENTS ON LOT 4.
Original Village Plat.
AMHERST, OHIO.
for
H.G. Reddington.
Scale 1" = 50'. May 1, 1912.
M. Wilcox - Surveyor.