


MAP PG 6-120

PPN 06 25 082 000 222

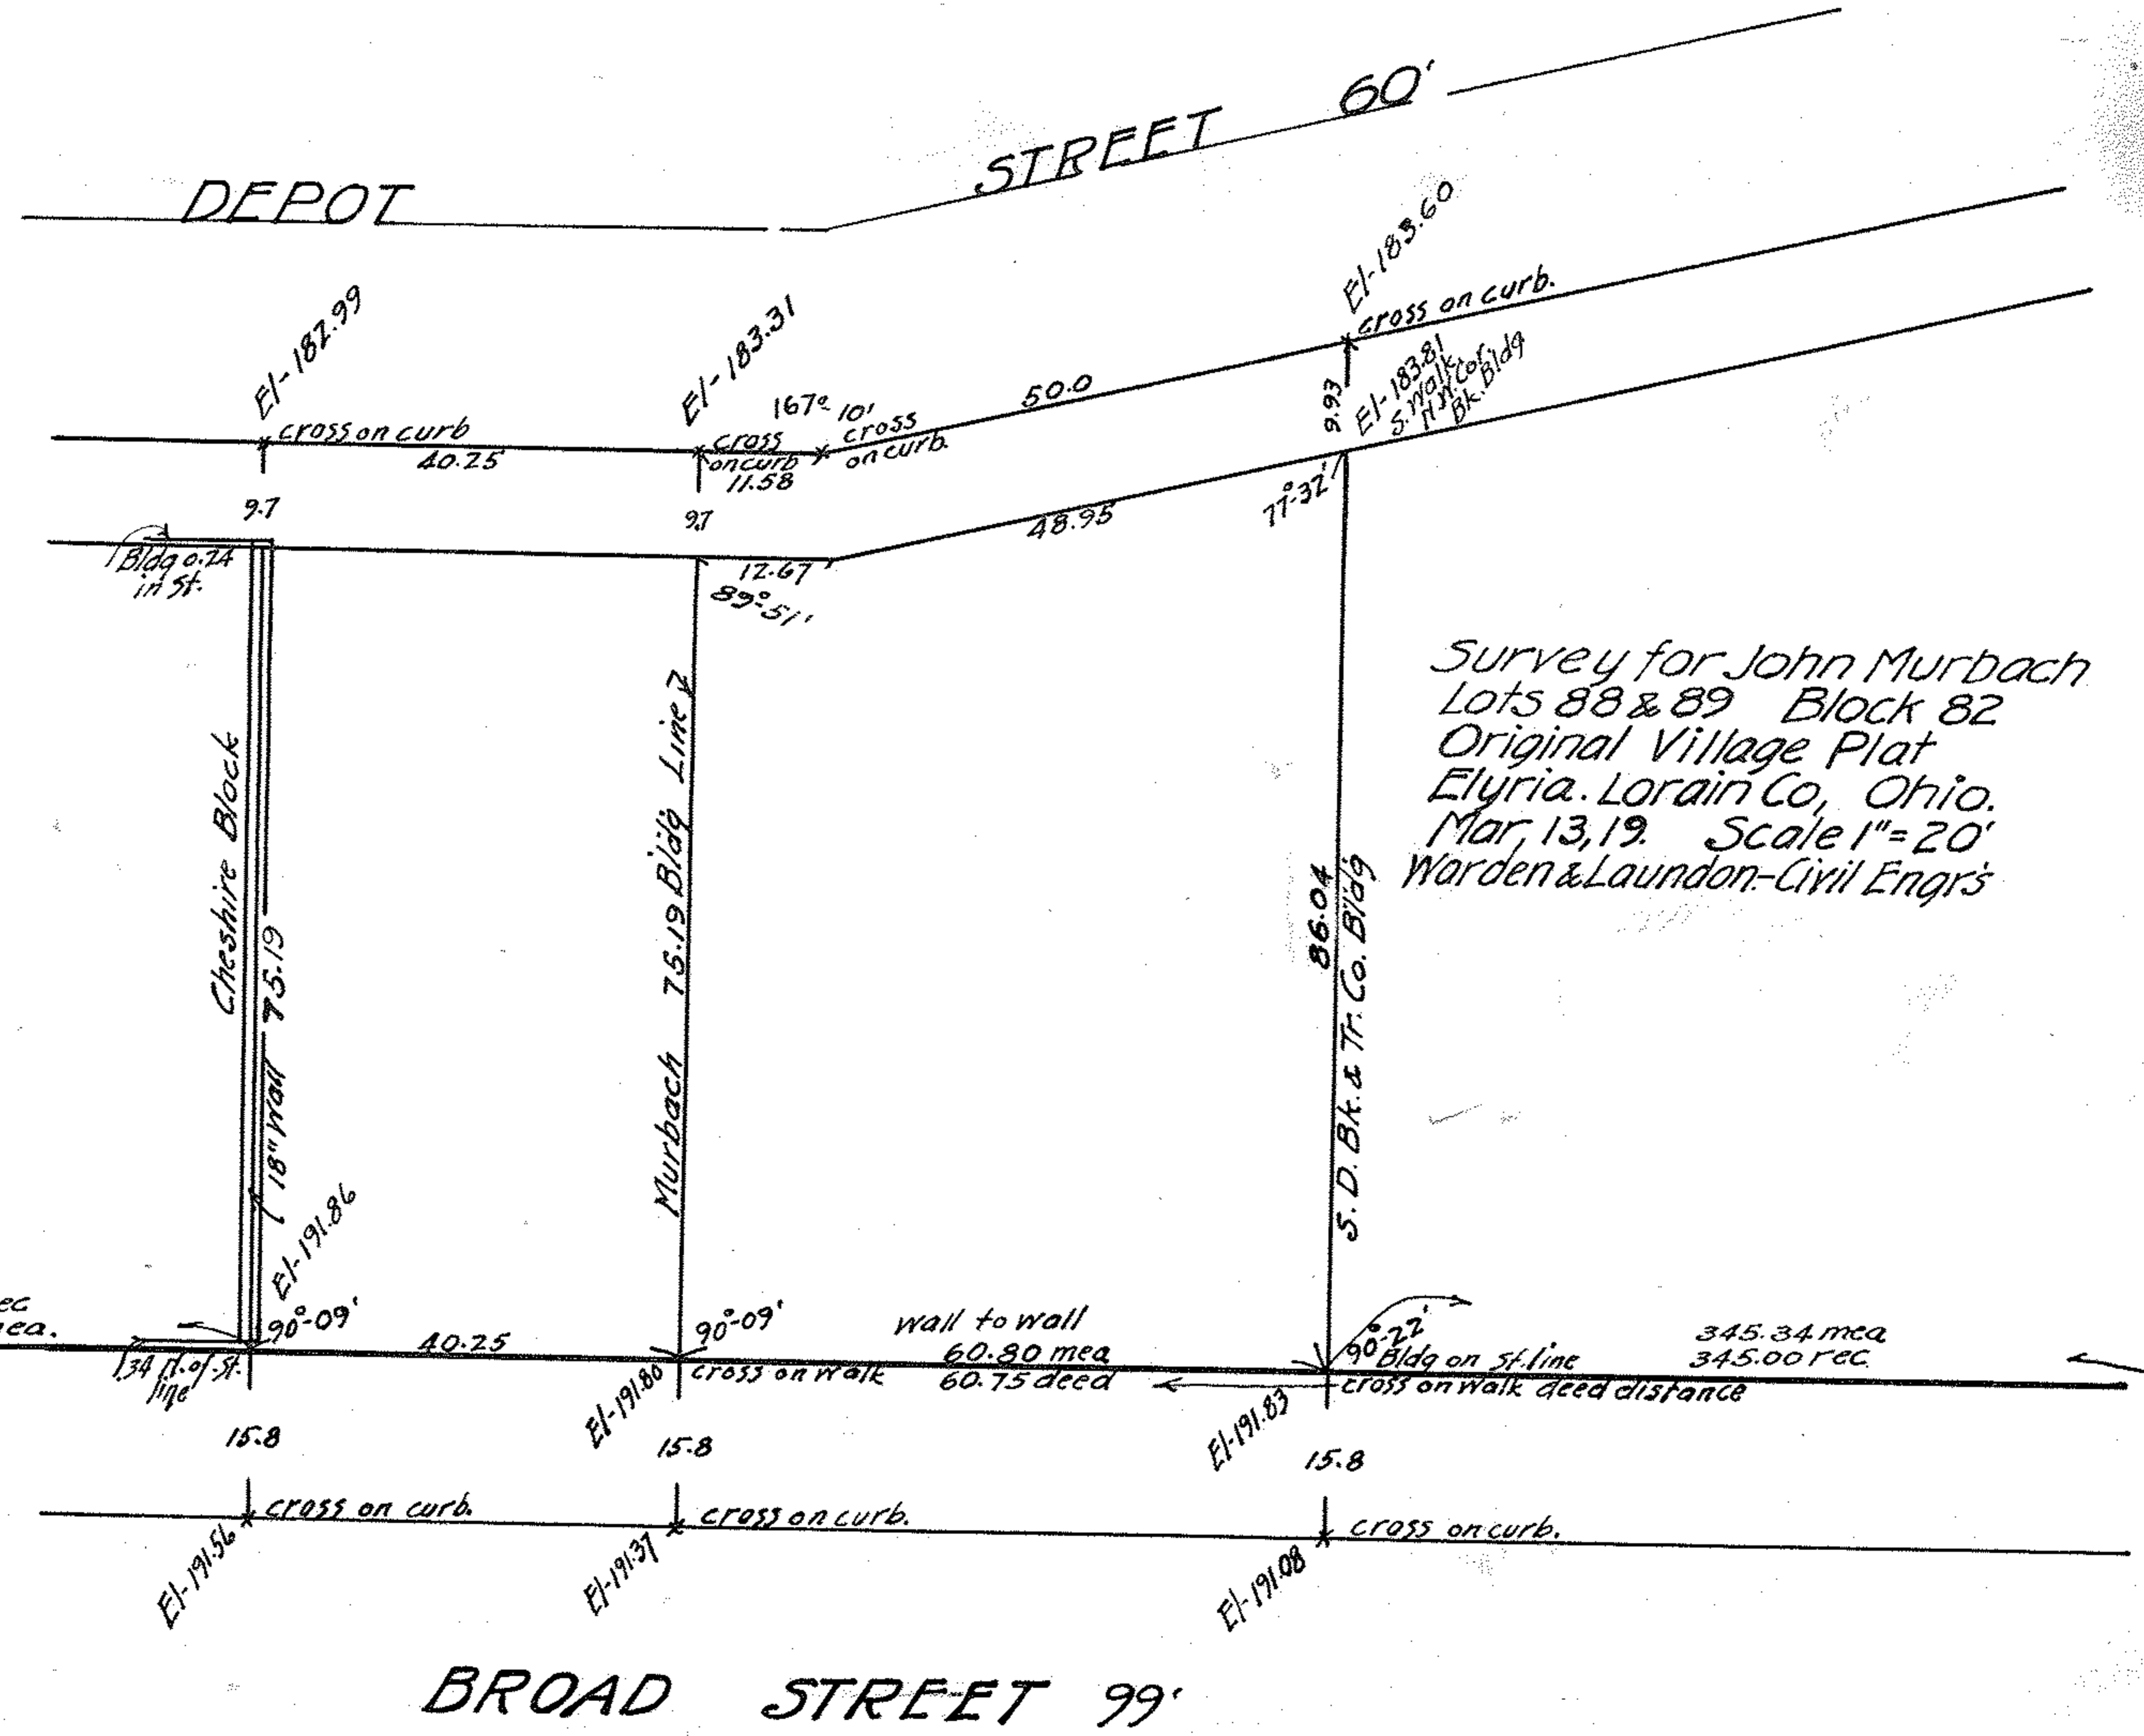

Survey for John Murbach
 Lots 88 & 89 Block 82
 Original Village Plat
 Elyria, Lorain Co, Ohio.
 Mar, 13, 19. Scale 1"=20'
 Warden & Laundon - Civil Engrs

BROAD STREET 99'