


West View Park Allot. Map Vol. 13-Pg. 1.

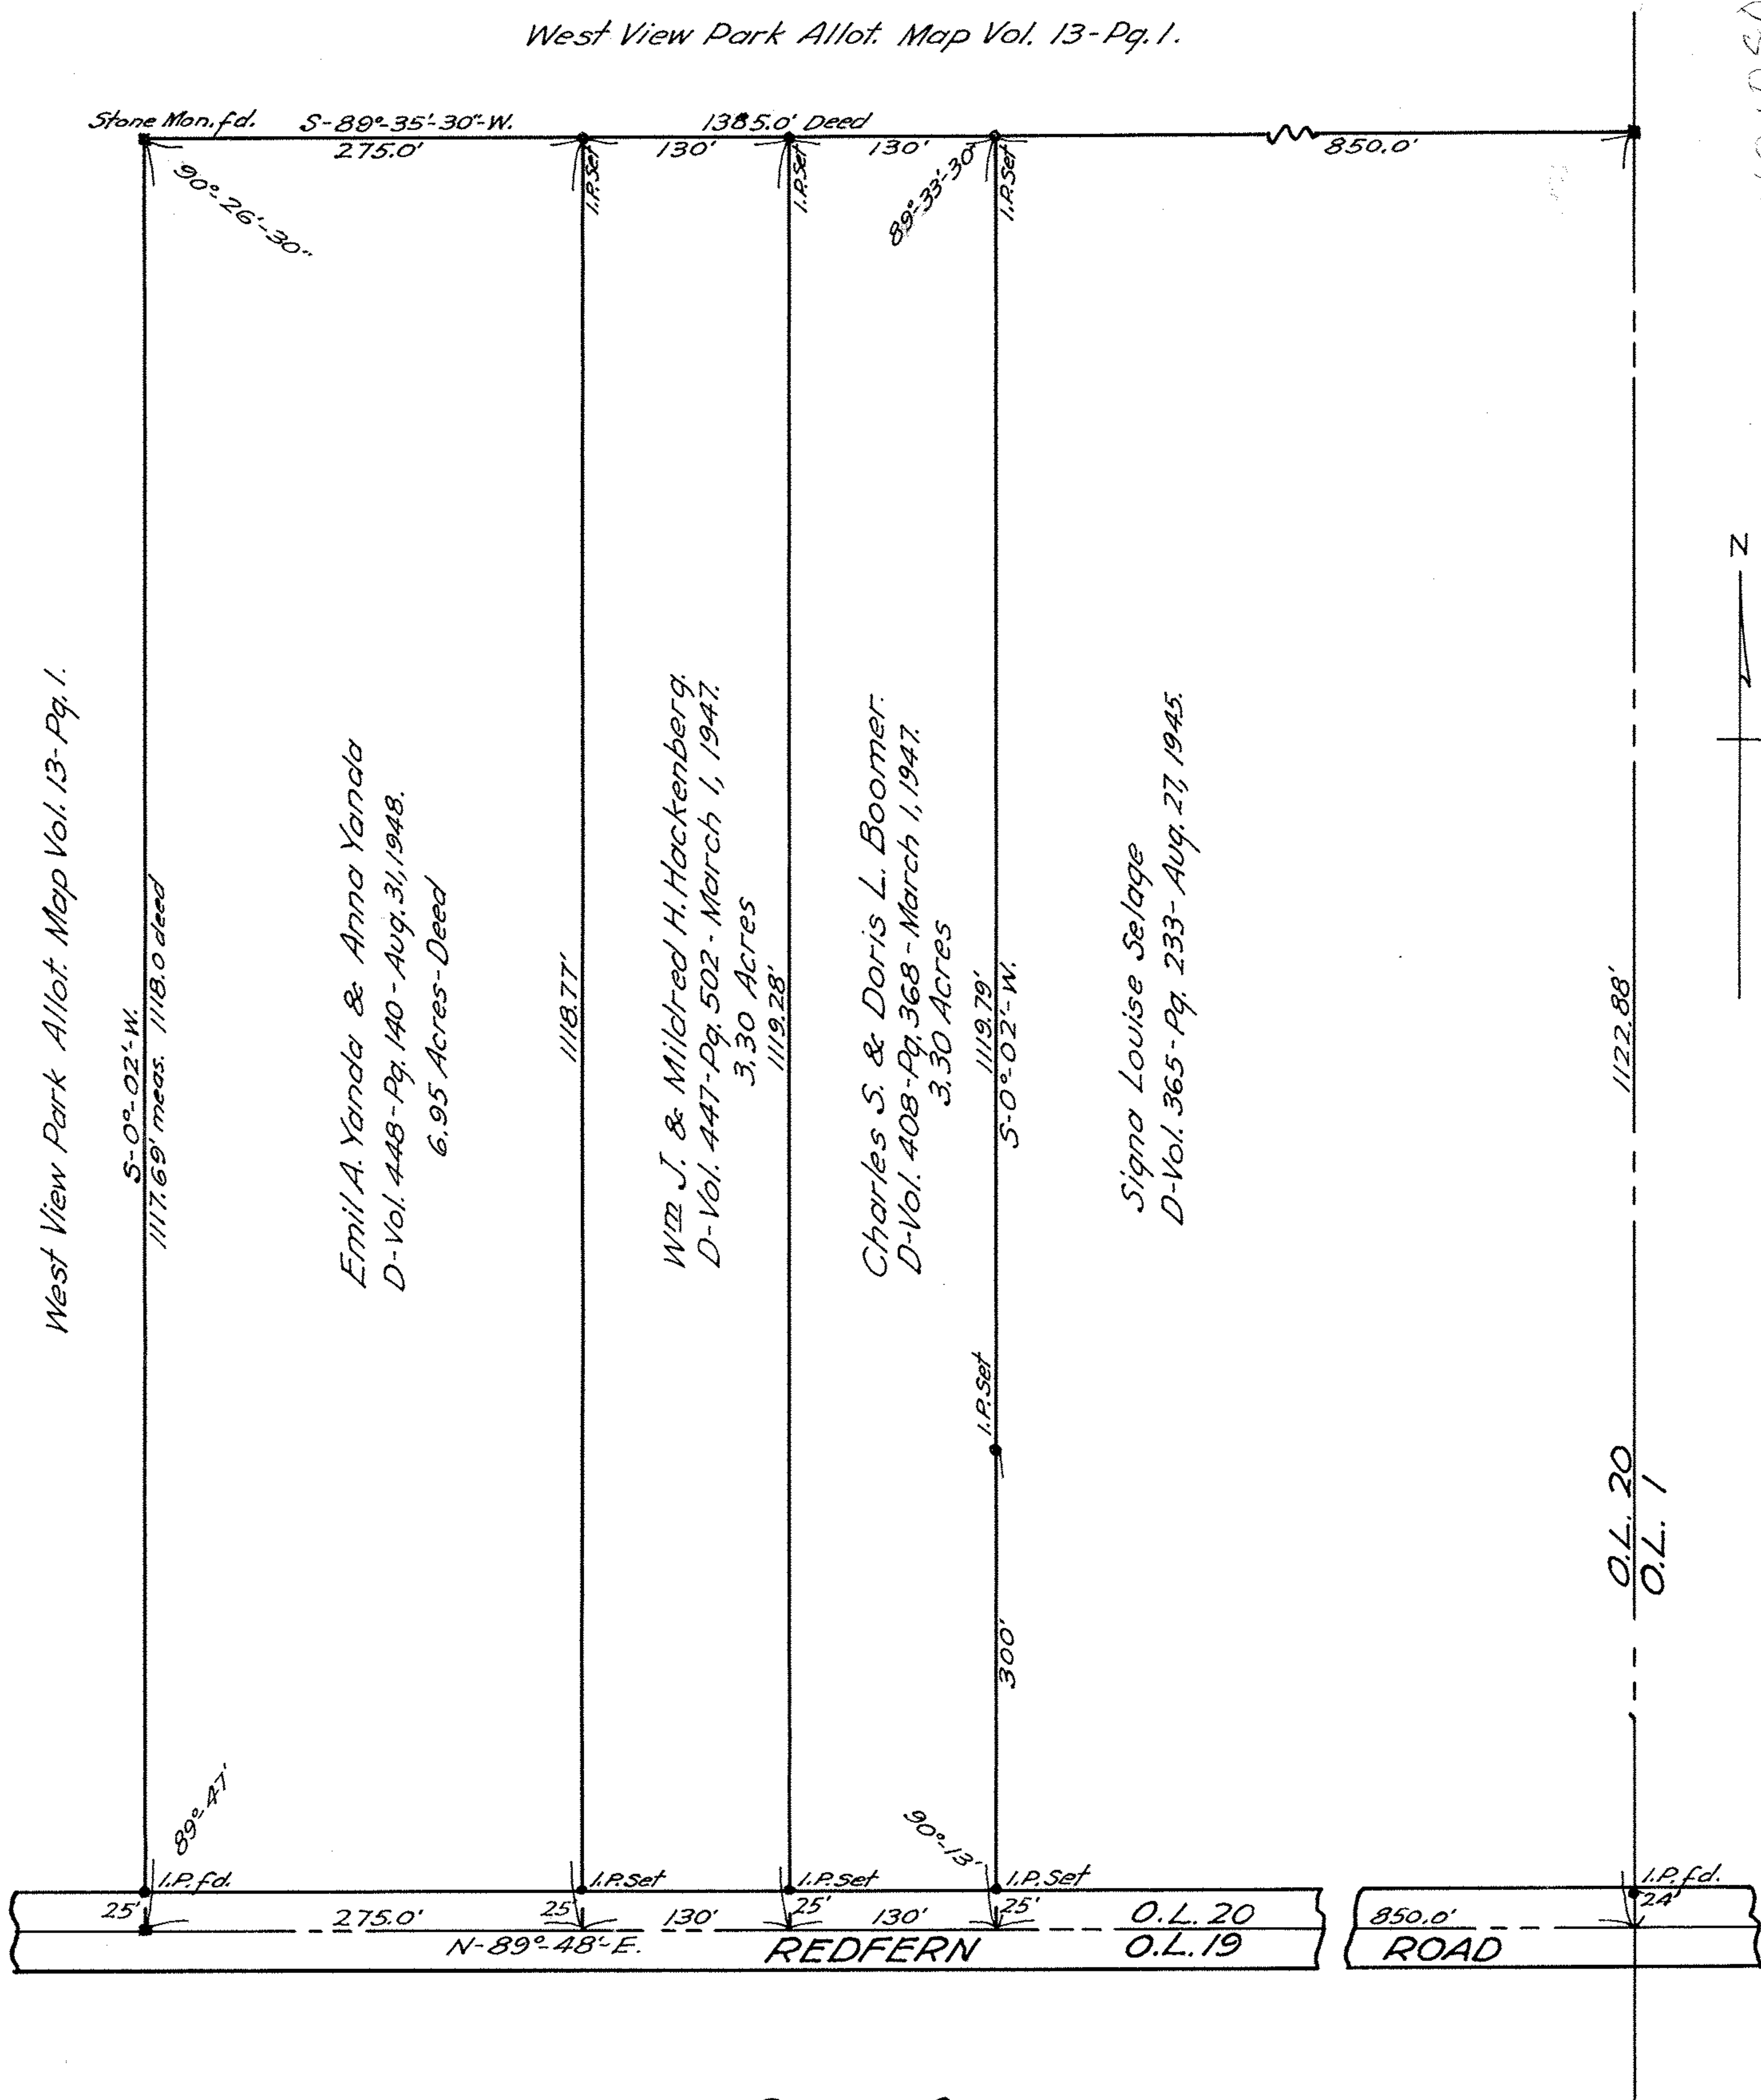

Survey for  
**YANDA - HACKENBERG - BOOMER**  
 O.L. 20 - Columbia Twp.  
 Lorain County, Ohio.  
 Scale - 1" = 100' Nov. 3, 1948.  
 J.W. Warden, Registered Surveyor.

PPN 12-00-020-000-???

MAP PG 12-00-020-A