

Iron pin Corner Fourth & Middle used, N.E. Corner-used

*Survey for  
John & Julia Murbach  
Lots 403-404. Block 43.  
Original Village Plat of Elyria  
Elyria- Lorain Co., Ohio.  
March 5, 1918. Warden & Laundon-Surveyors.  
Revised April 5 1951 D.A.*

Cross used

Iron pin 1.0 in Street each way. Gone 4/5/51

FIFTH

ST 66'


+ on 5th St Line & 1.0' in Middle Ave 4-5-51

{ Middle to East Record = 765.74 - Measured 768.28'  
Surplus 2.54 ft. = .00332 per foot

Cross on East line Middle 1.0 in Fifth - made Gone

Gone  
Iron Pin 1.0 in Street each way used

Iron Pin 1.0 in Street each way used. Gone

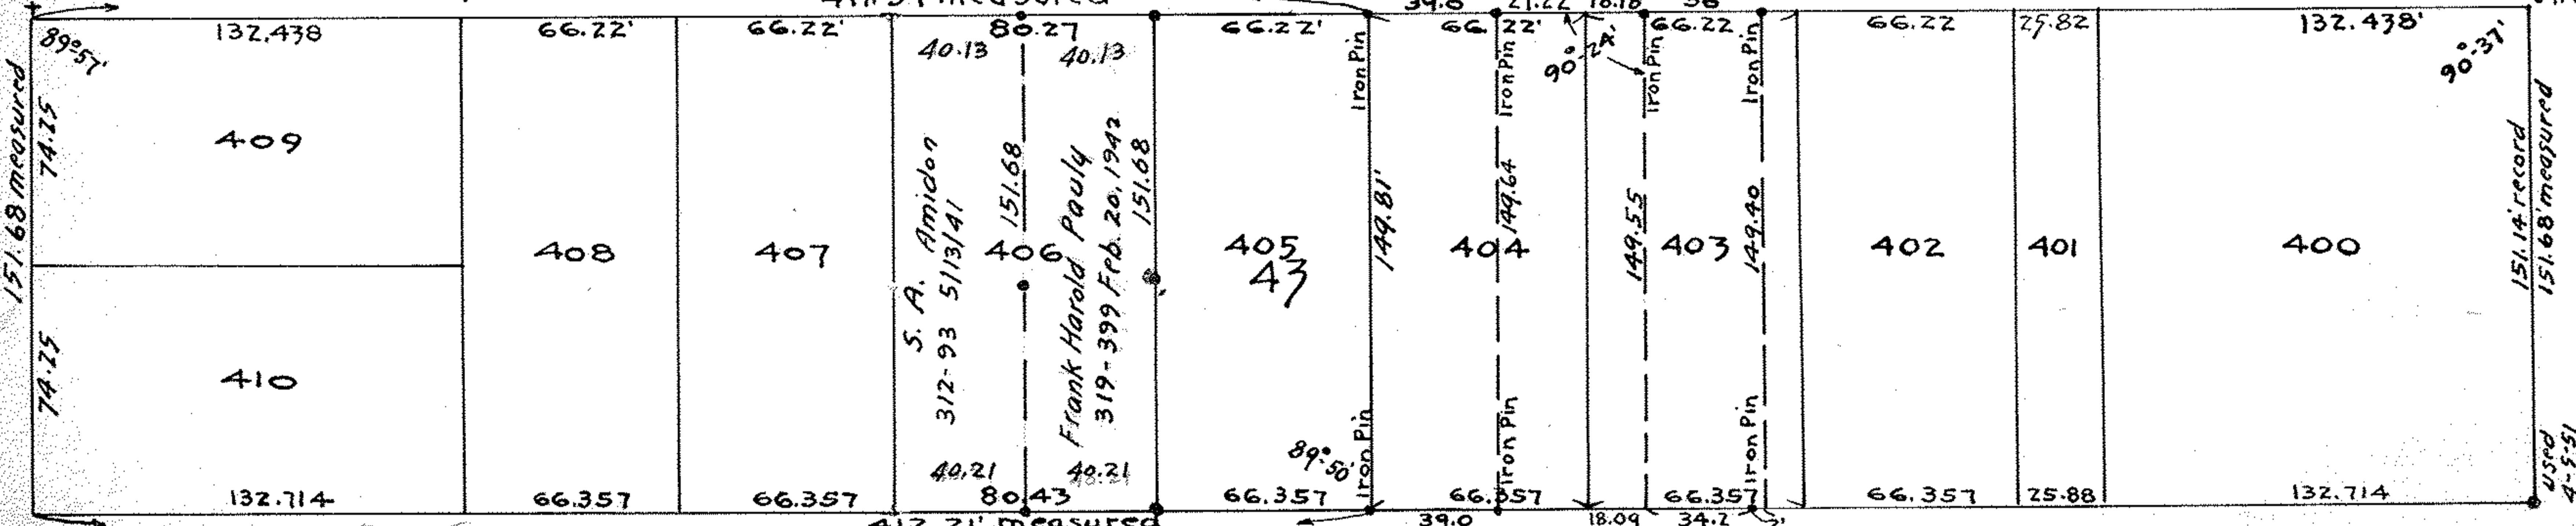


Ave 99'

Ave 66'

305.65 Alley

{ Middle to East Record 765.74 - Measured 769.88'  
Surplus 4.14 ft. = .00541 per foot.

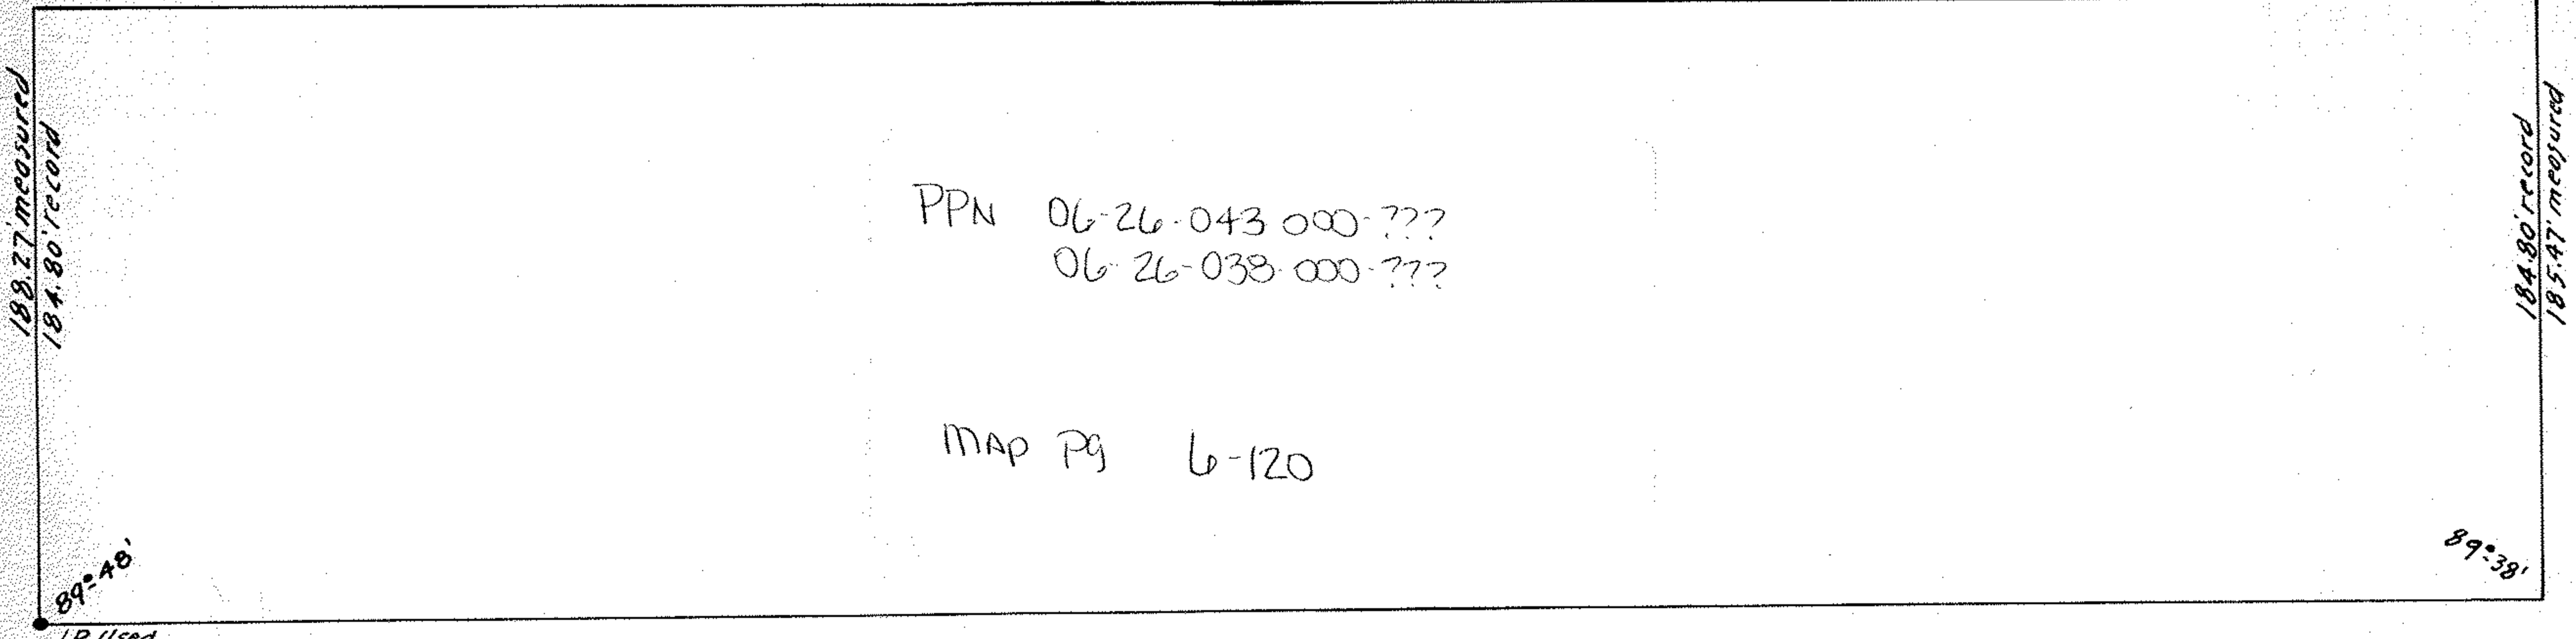

I.P. Used

SIXTH

ST 66'

Cross on walk used

772.73' measured

Cross on walk Southline 7th 1.0 in East - made

400 321 B