


5115-4

Survey for  
George B. Roice  
 of  
The George E. & Mabel L. Hawk Farm.  
 Lots #156-157 Pittsfield Twp. Lorain Co., Ohio.  
 APR 25 1914. T.L. Gibson C.E.

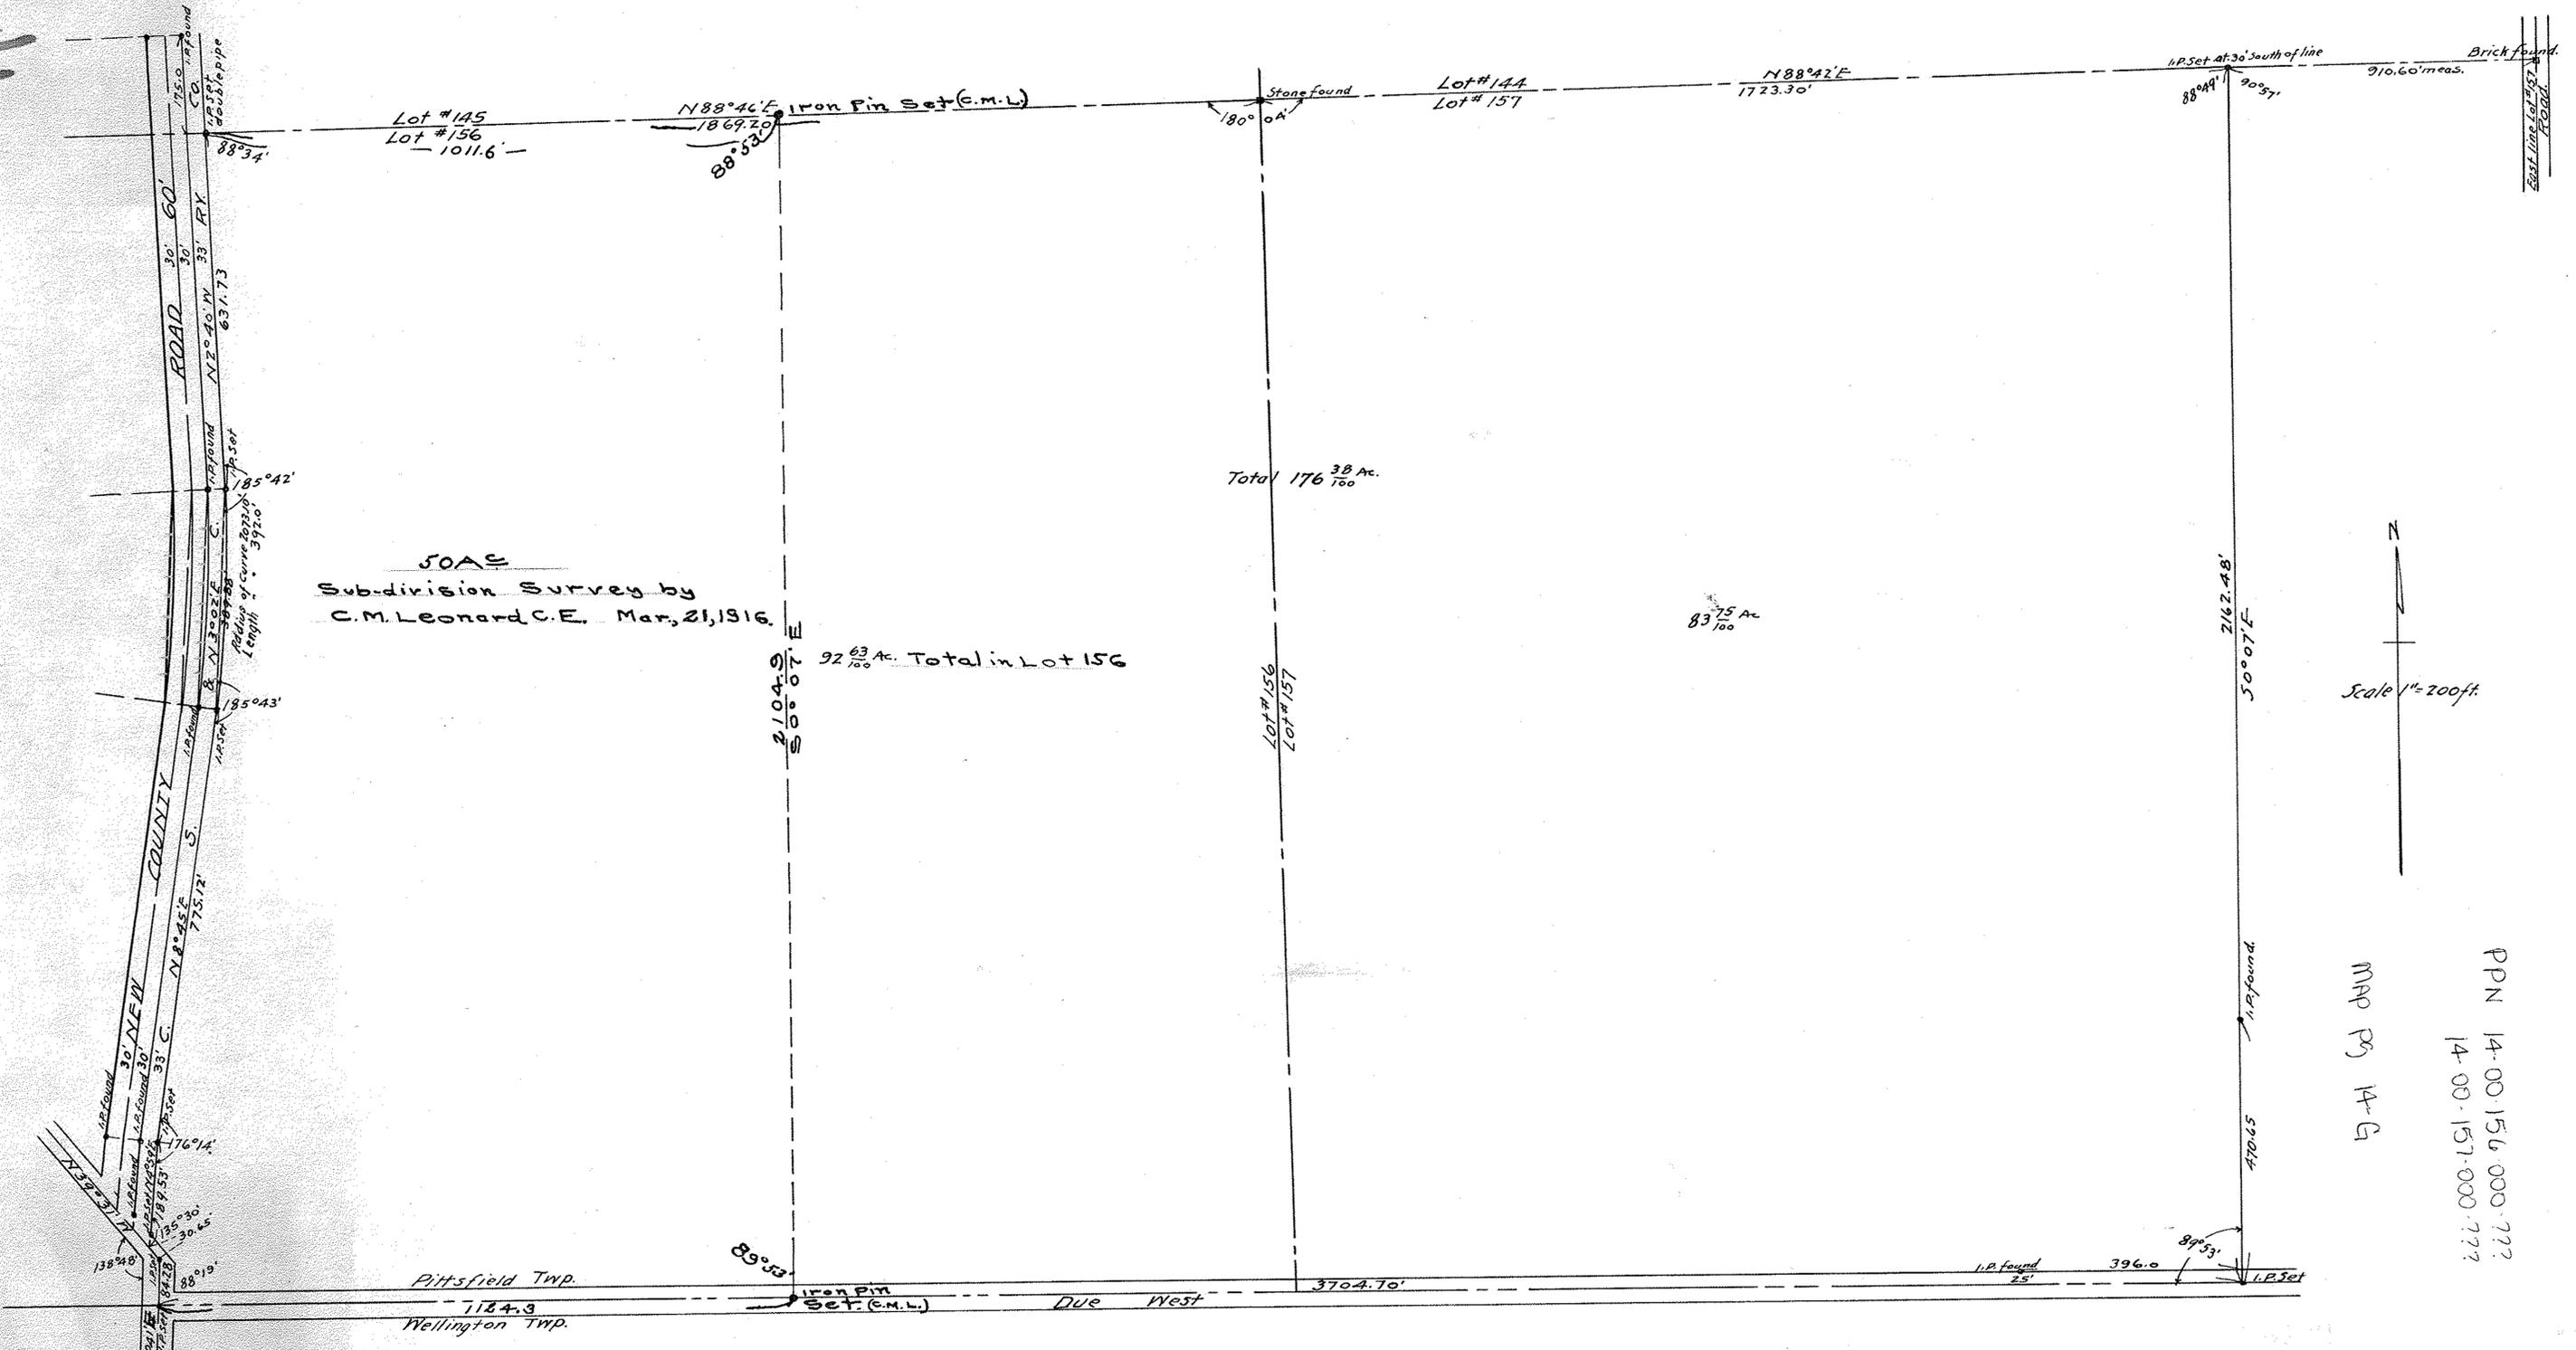

SOAS  
 Sub-division Survey by  
 C.M. Leonard C.E. Mar, 21, 1916.

PPN 14-00-156-000-772  
 14-00-157-000-772  
 MAP PG 14-G

400442