


CORPORATION LINE VILLAGE OF OBERLIN

Samuel & Mary Mungeon
D. Vol. 233 Pg. 310 Jan. 20-1928

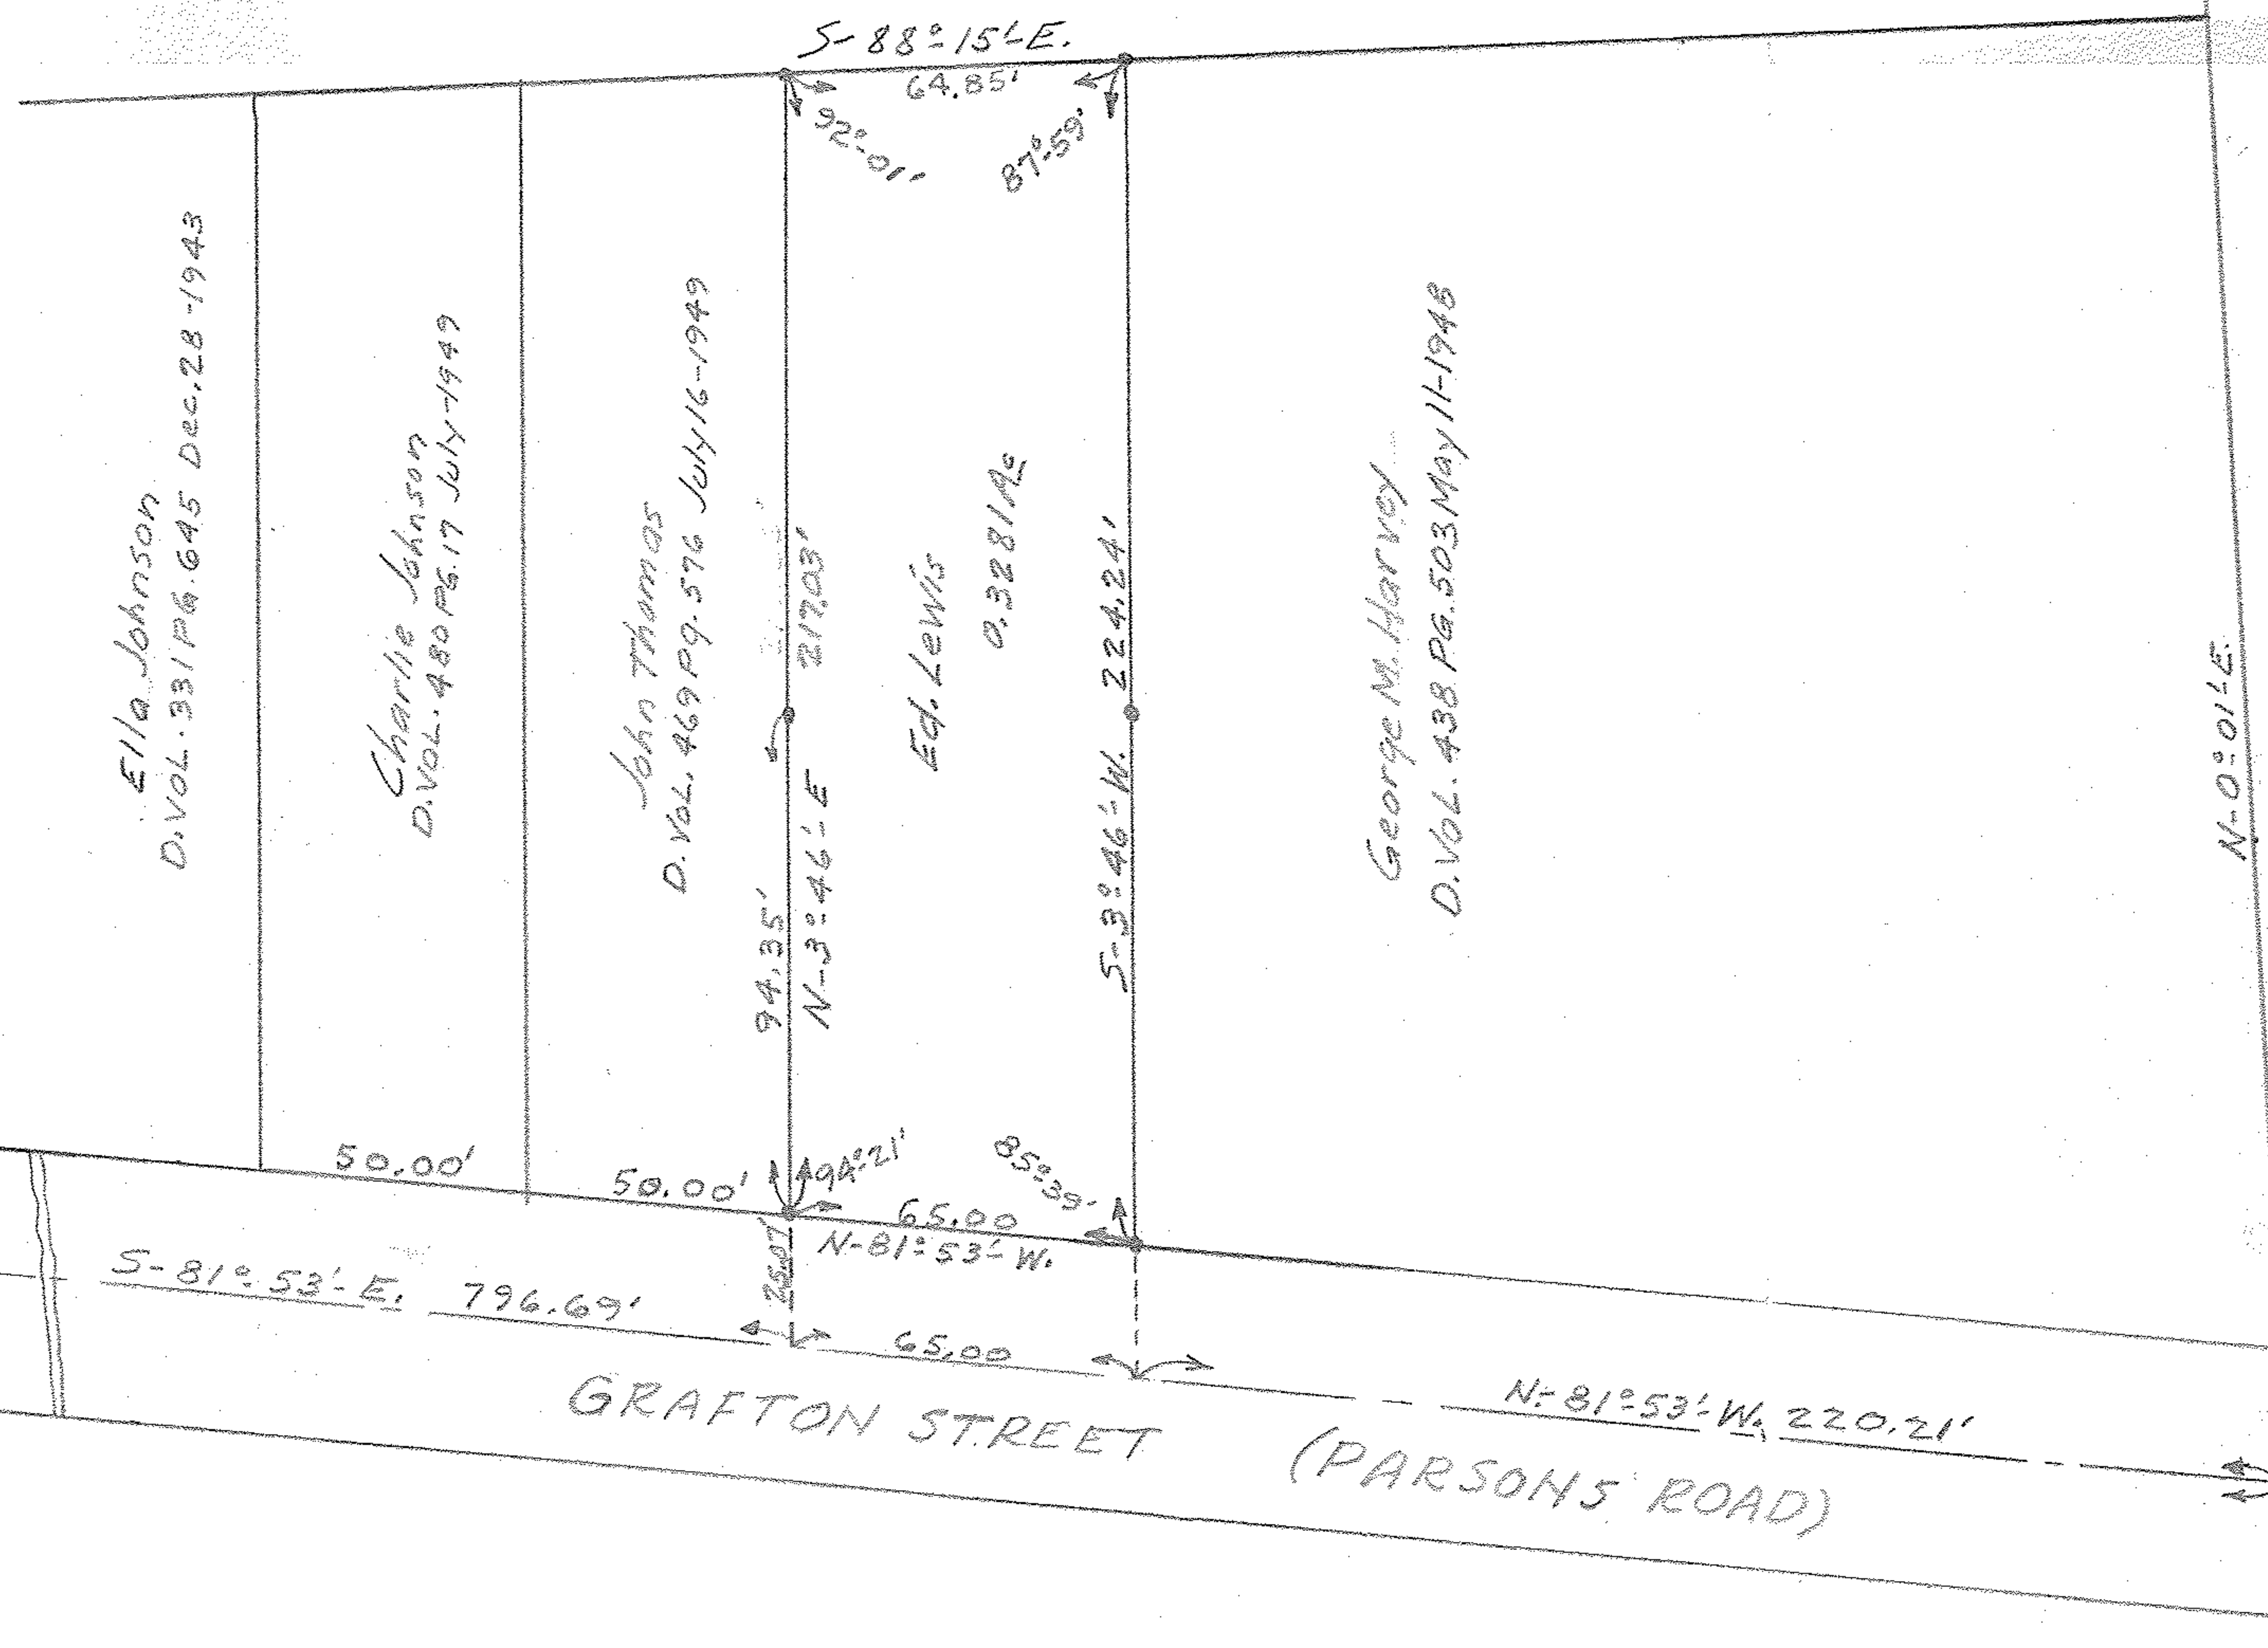

Ella Johnson
D. Vol. 331 Pg. 645 Dec. 28-1943

Charlie Johnson
D. Vol. 480 Pg. 17 July-1949

John Thomas
D. Vol. 469 Pg. 576 July 16-1949

Ed. Lewis
0.3281 Ac

George M. Harvey
D. Vol. 438 Pg. 503 May 11-1948

Robert & Hattie S. Mynn
10000 Ac

GRAFTON STREET
(PARSONS ROAD)

MAP OF SURVEY FOR
Ed. Lewis
O.L. 97 RUSSIA TWP. LORAIN CO.
Scale 1" = 40 FT. JUNE-16-1951
C.E. Penfound Registered Surveyor.