




SOUTH PROFESSOR STREET 60 FT.  
208.29

Iron Pin found.

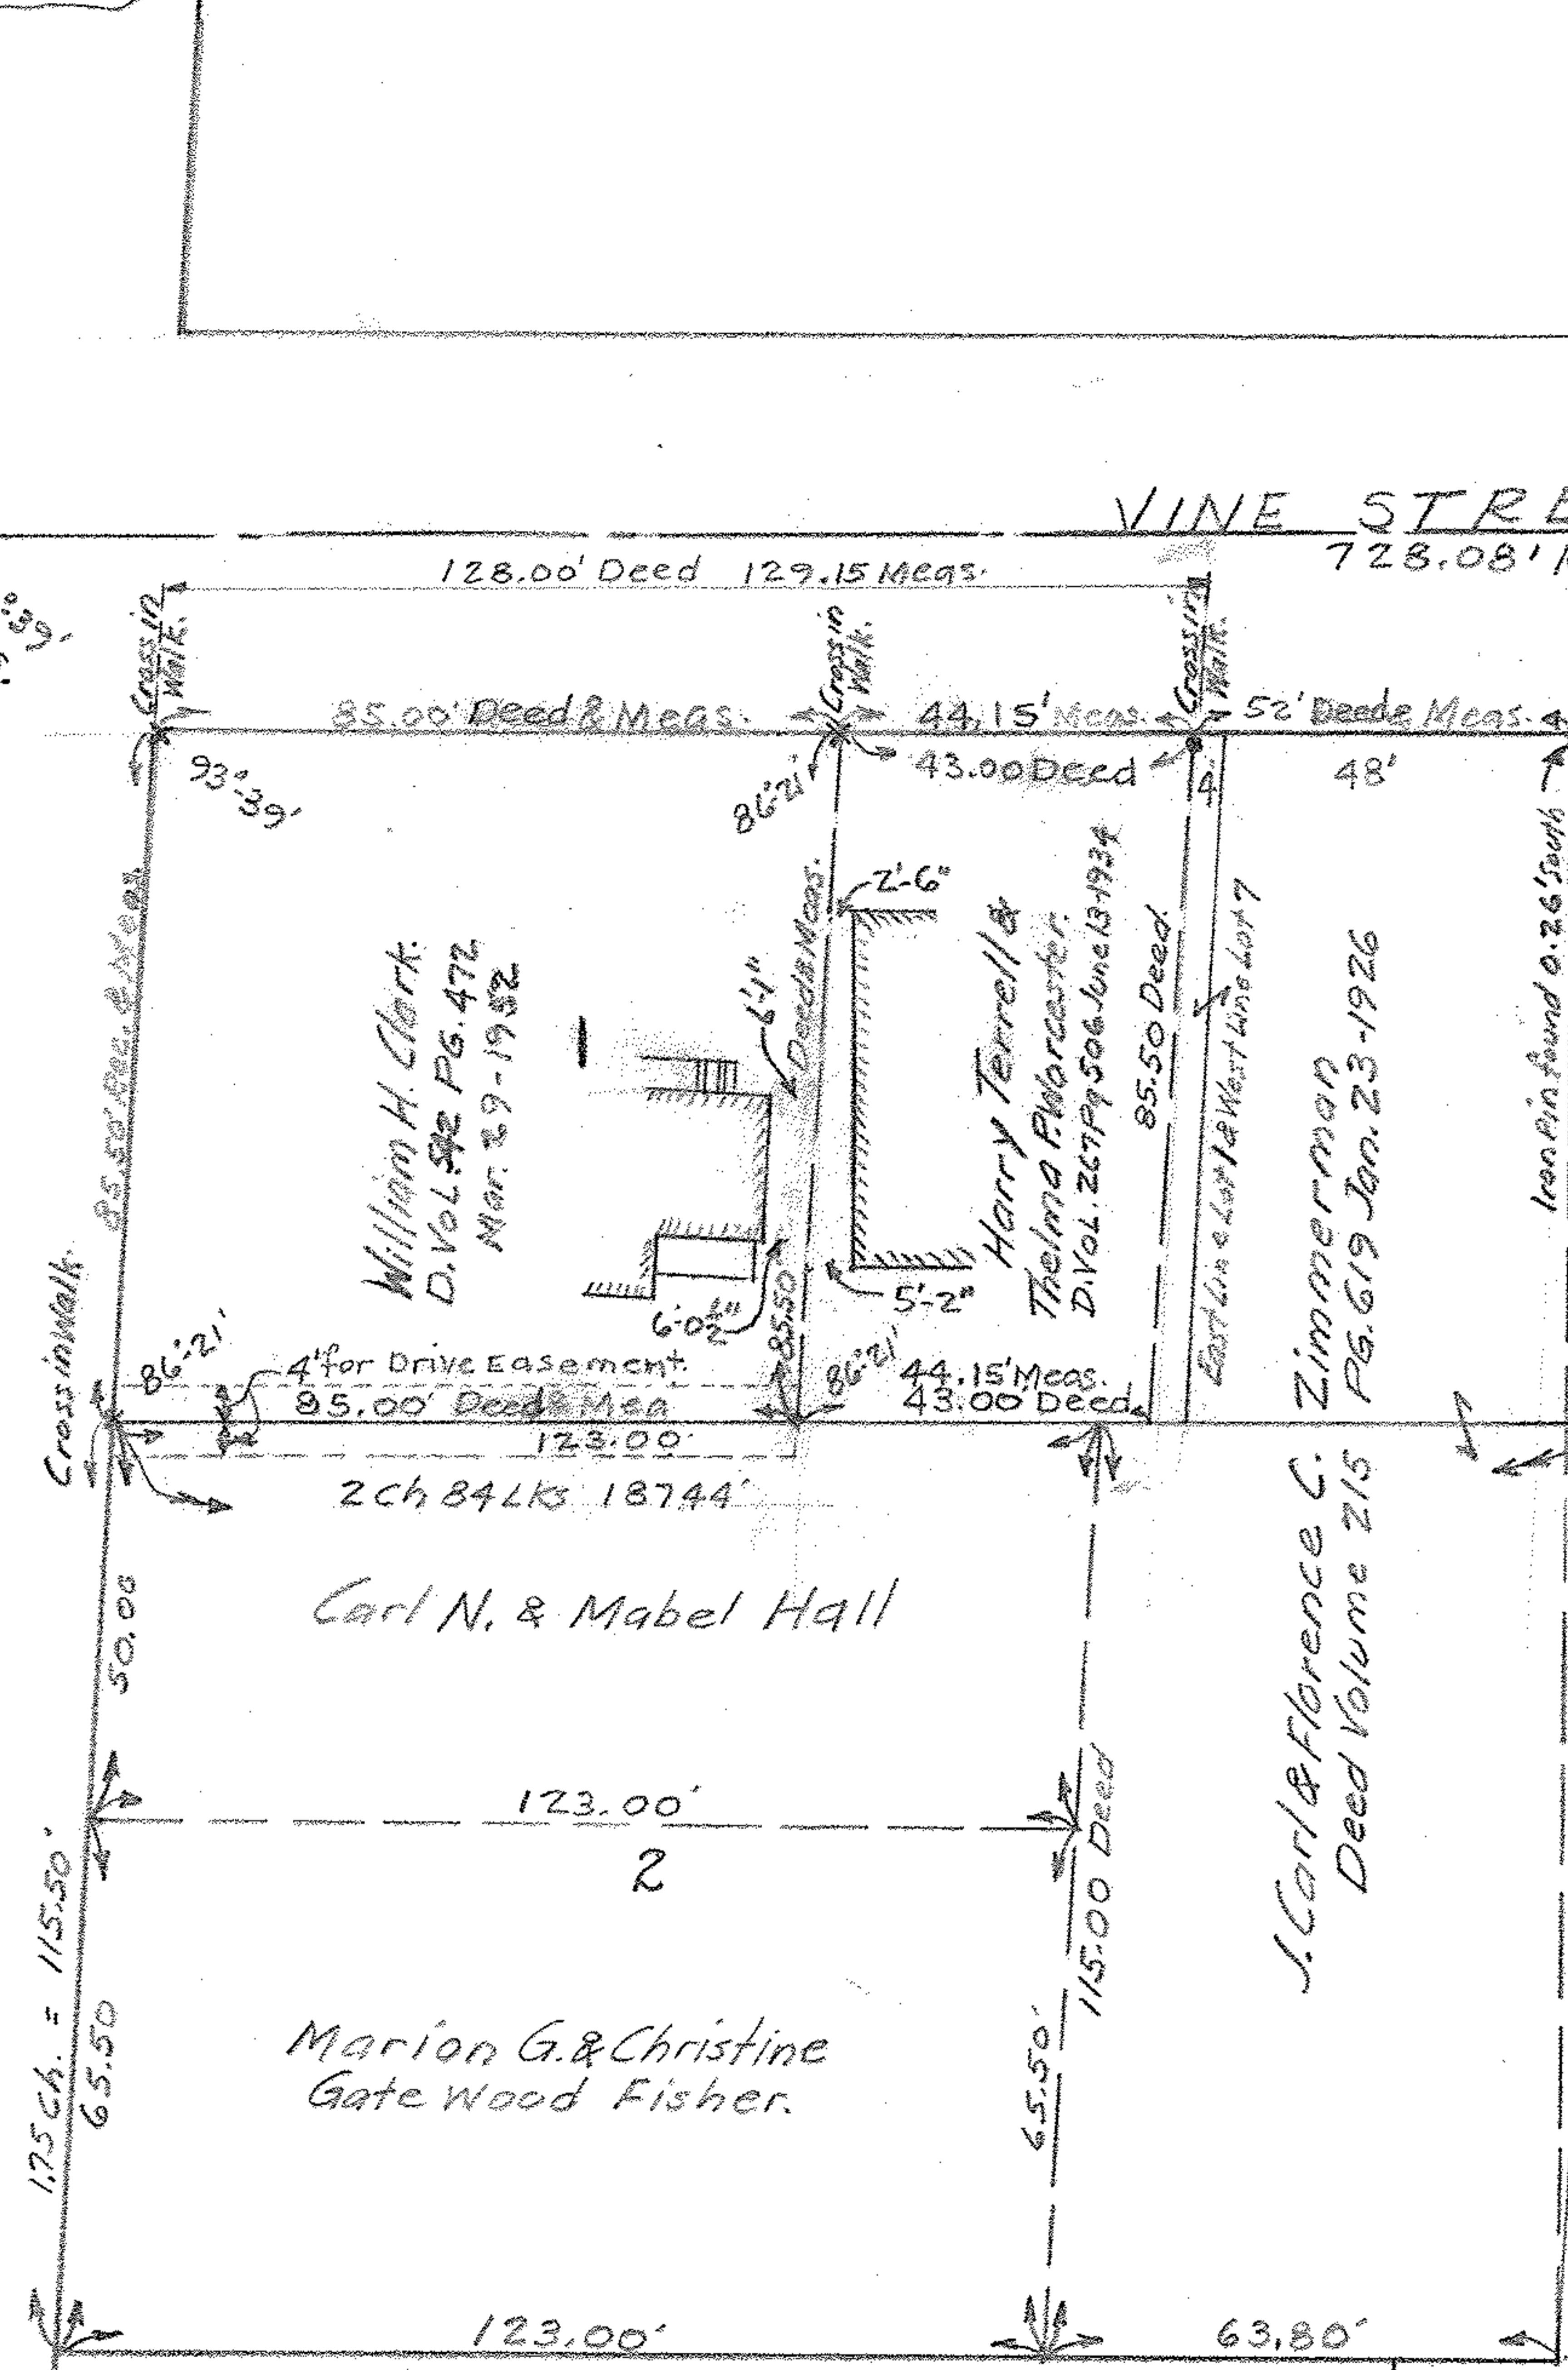

MAP OF SURVEY FOR  
 William H. Clark.  
 LOT 1-SWIFTS SUBDN. VOL 3 PG. 8  
 VILLAGE OF OBERLIN  
 O.L. 85 RUSSIA, TOWNSHIP  
 LORAIN COUNTY OHIO  
 Scale 1"=30' JULY 5-1952  
 C.E. Penfound Registered Surveyor.