

# PLAT OF SURVEY FOR JACK CUSICK AND ERNIE KOVACS

ORIGINAL LOT 12 - TRACT NO. 12

HENRIETTA TOWNSHIP


LORAIN COUNTY OHIO

SCALE: 1" = 60' APRIL-MAY 1973

Gary E. Penfound

Reg. Surveyor No. 4457

NOTES: ○ indicates iron pin found.  
● indicates iron pin set unless otherwise designated.

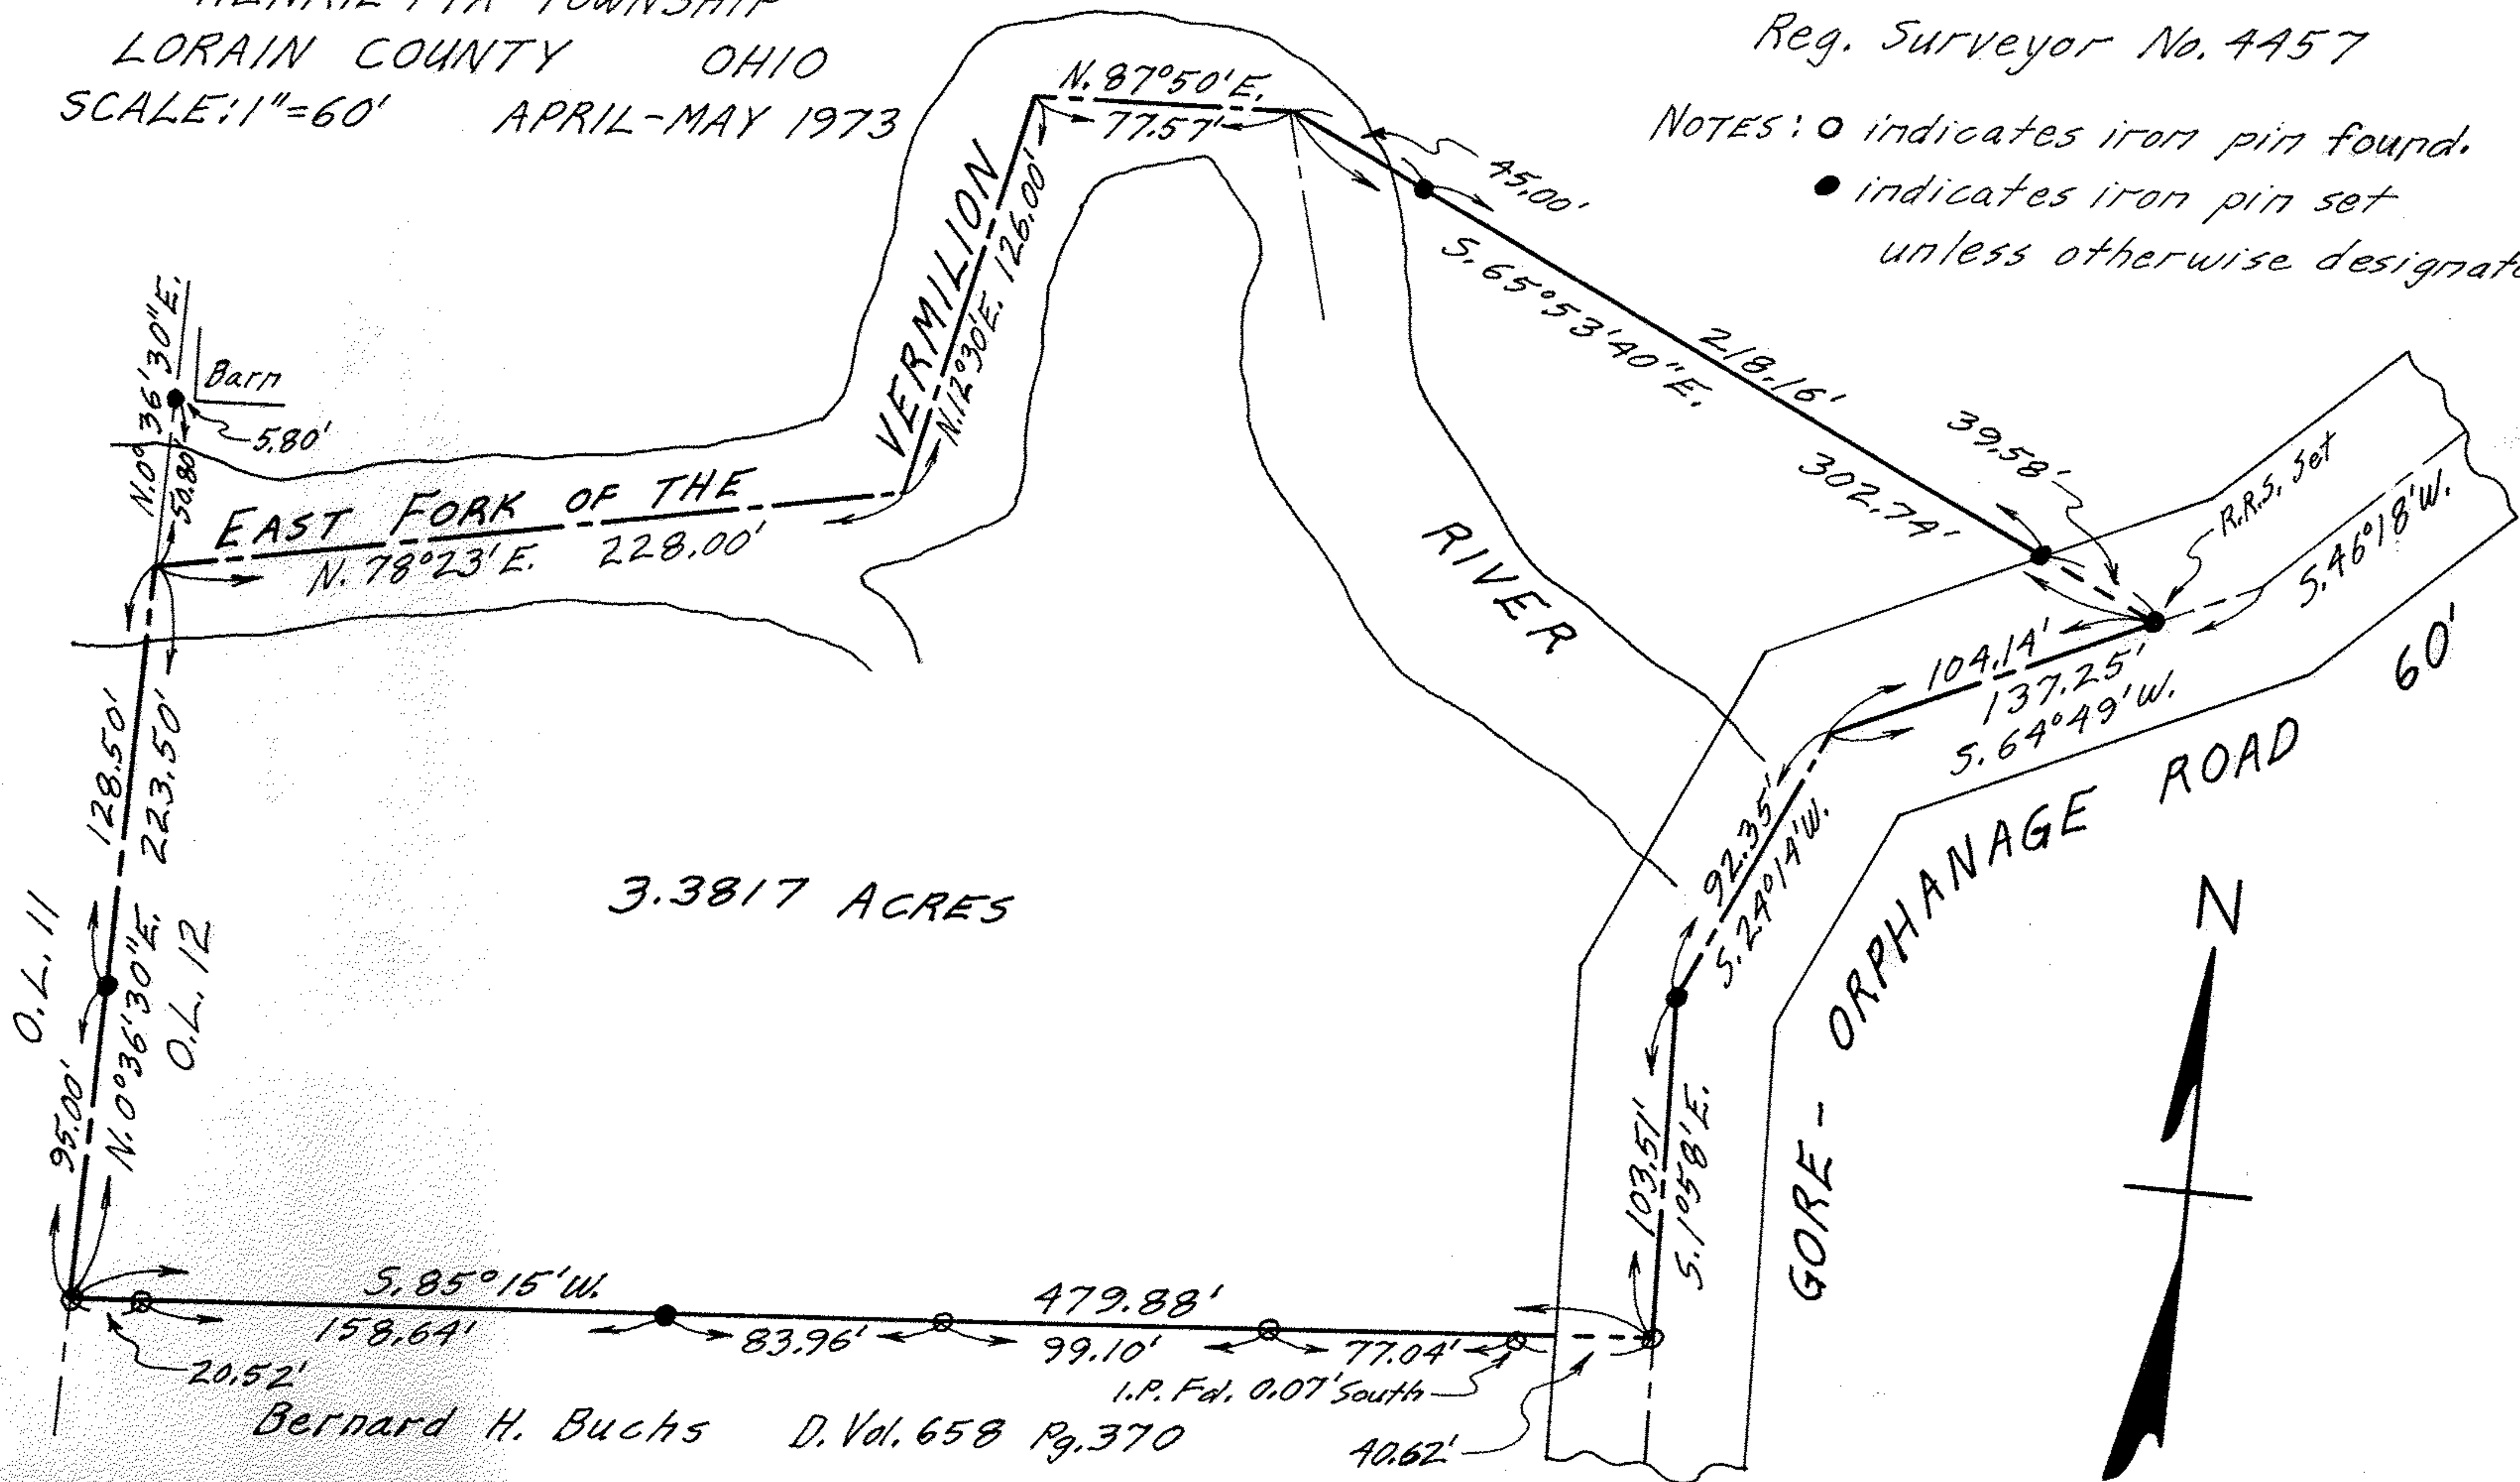

3.3817 ACRES

Bernard H. Buchs D. Vol. 658 Pg. 370