


04-00-010-114-034
04-00-010-E

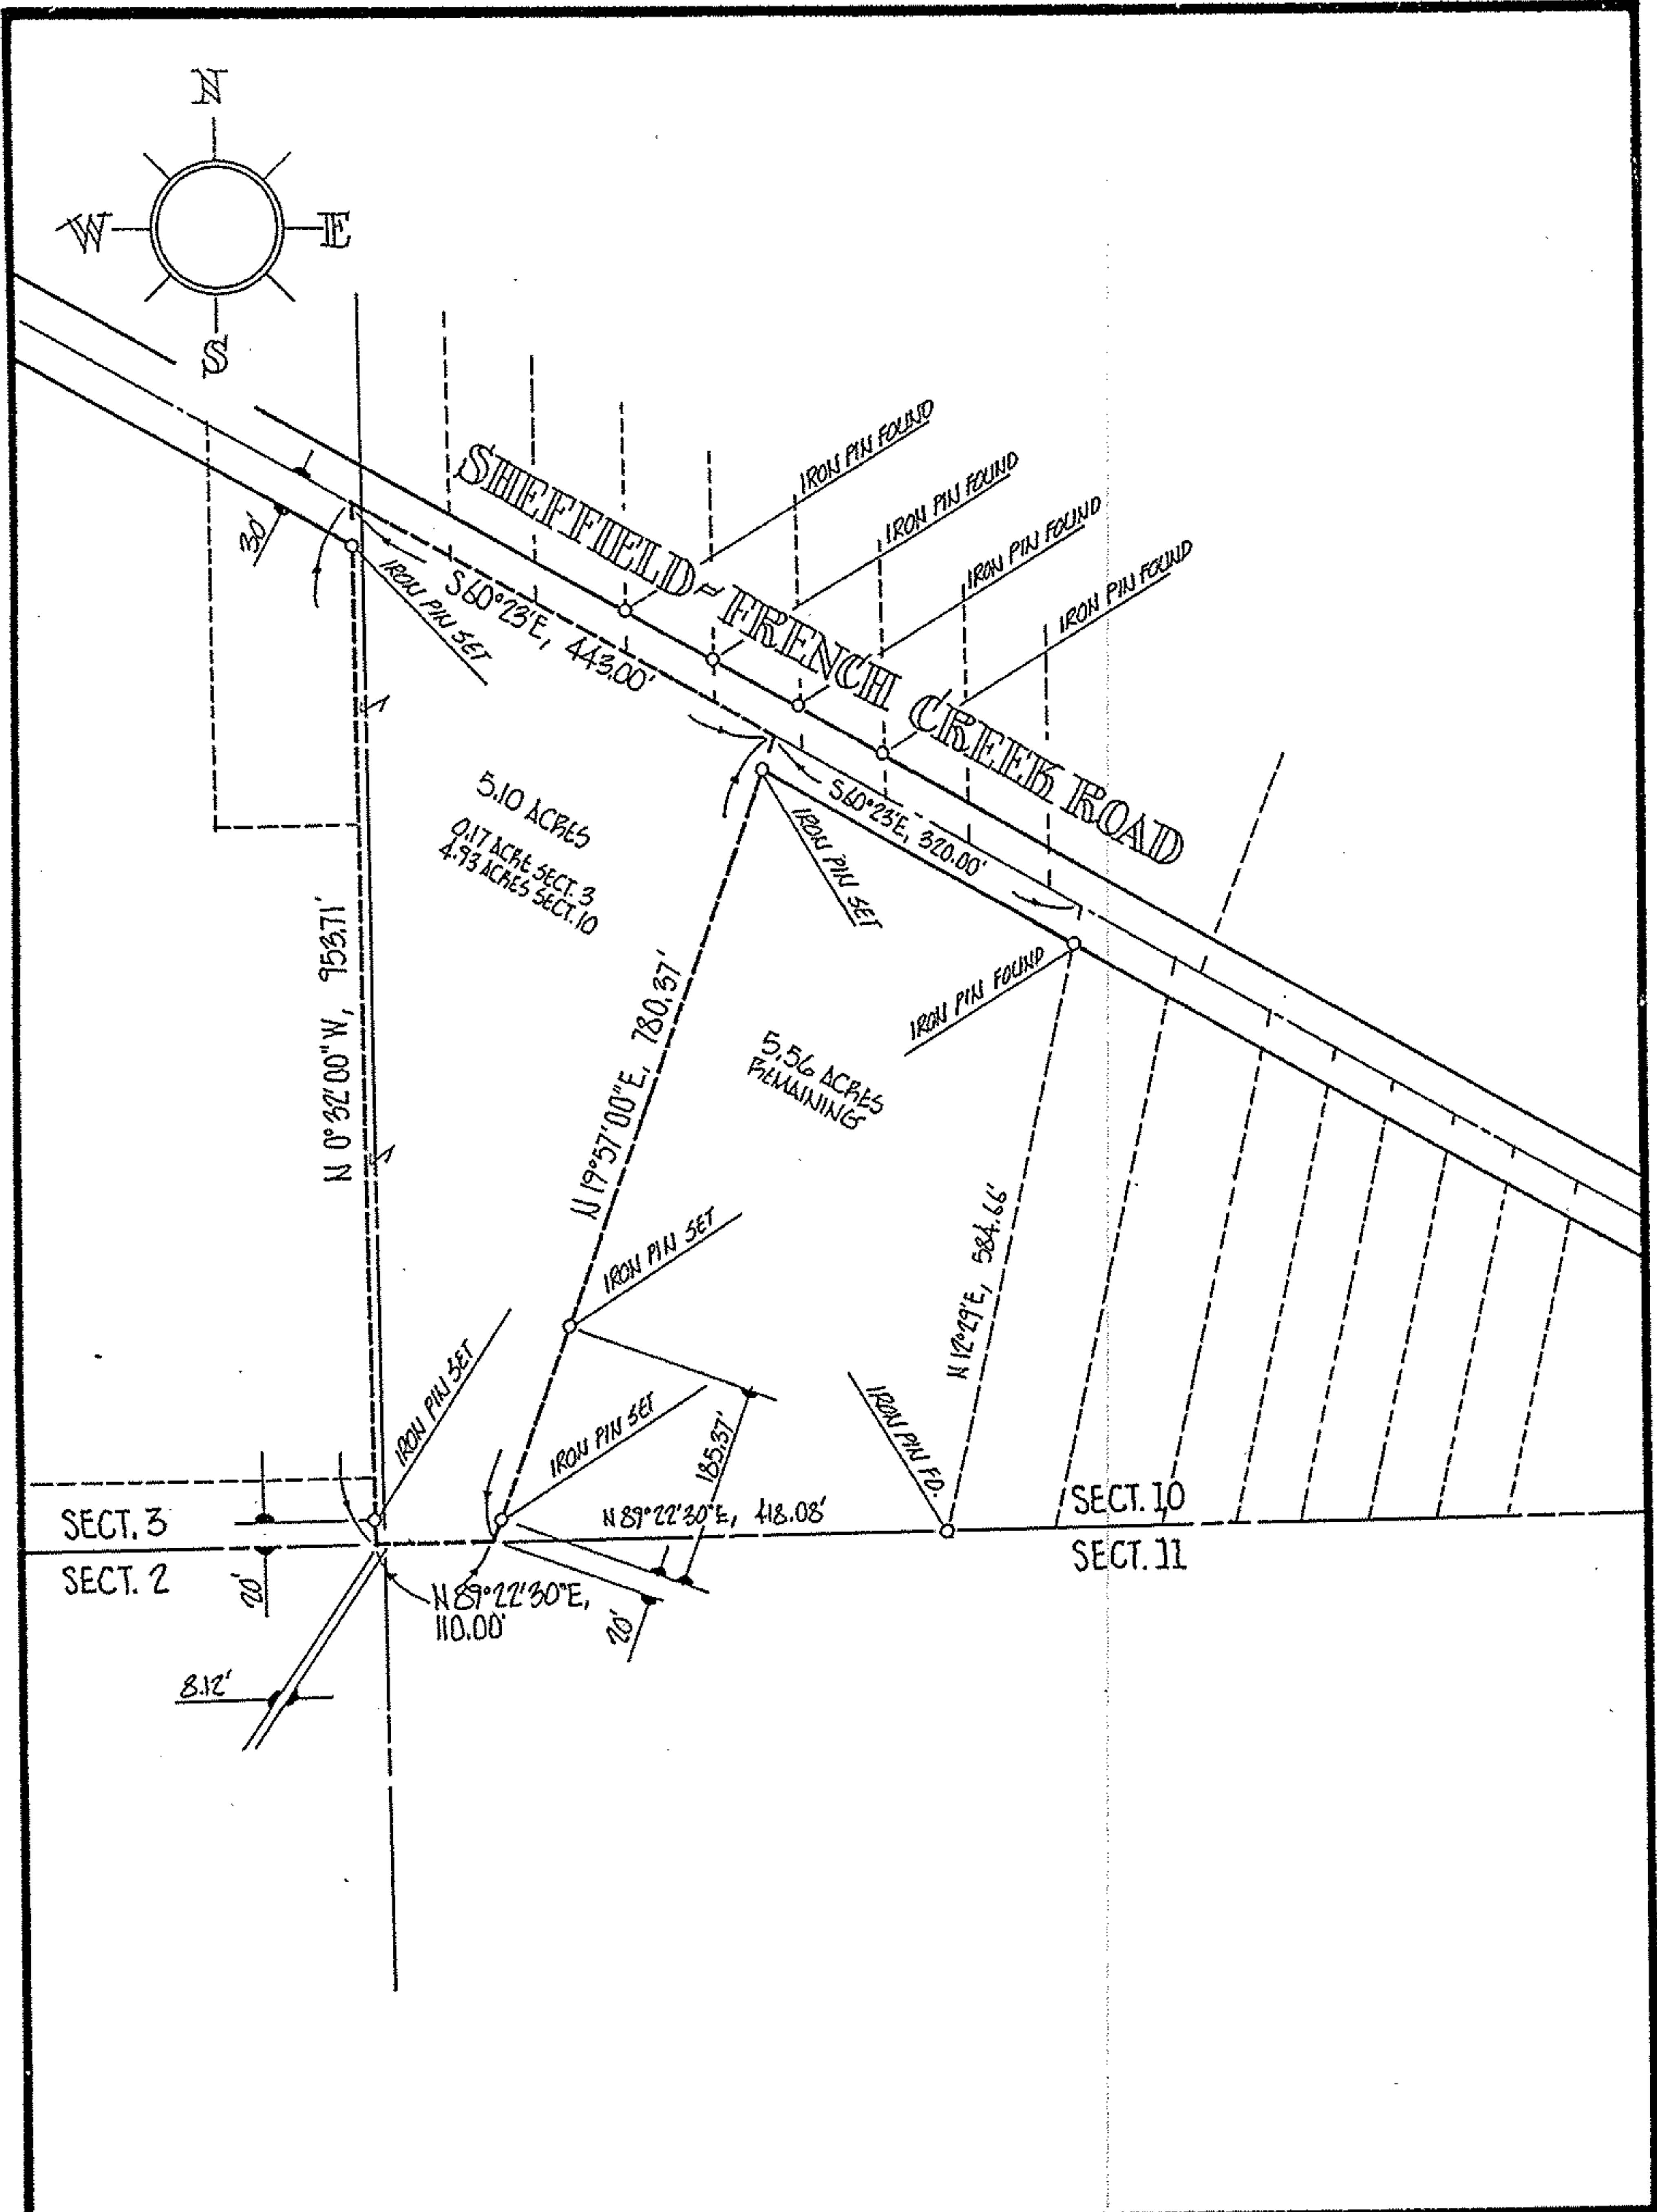

ACREAGE <u>10.66</u>	PREPARED FOR <u>MR. DON LAW</u> 934-4593
DATE <u>09-25-84</u>	<u>38017 FRENCH CREEK ROAD, AVON, O.</u>
DRAWN <u>MGH</u>	MICHAEL G. HURA, registered surveyor 12706 MASON RD., VERMILION, O., Ph (216) 965 4040
SCALE <u>1" = 200 ft.</u>	
	PERIMETER SURVEY
	SUBLOT(s) _____ of _____
	PART OF O.L. _____ TRACT _____ SECTION <u>3 & 10</u> OF _____ <u>AVON</u> TOWNSHIP <u>LORAIN</u> CO., OHIO
PERMANENT PARCEL No _____	

CITY OF AVON