


01-00-078-000

#16907

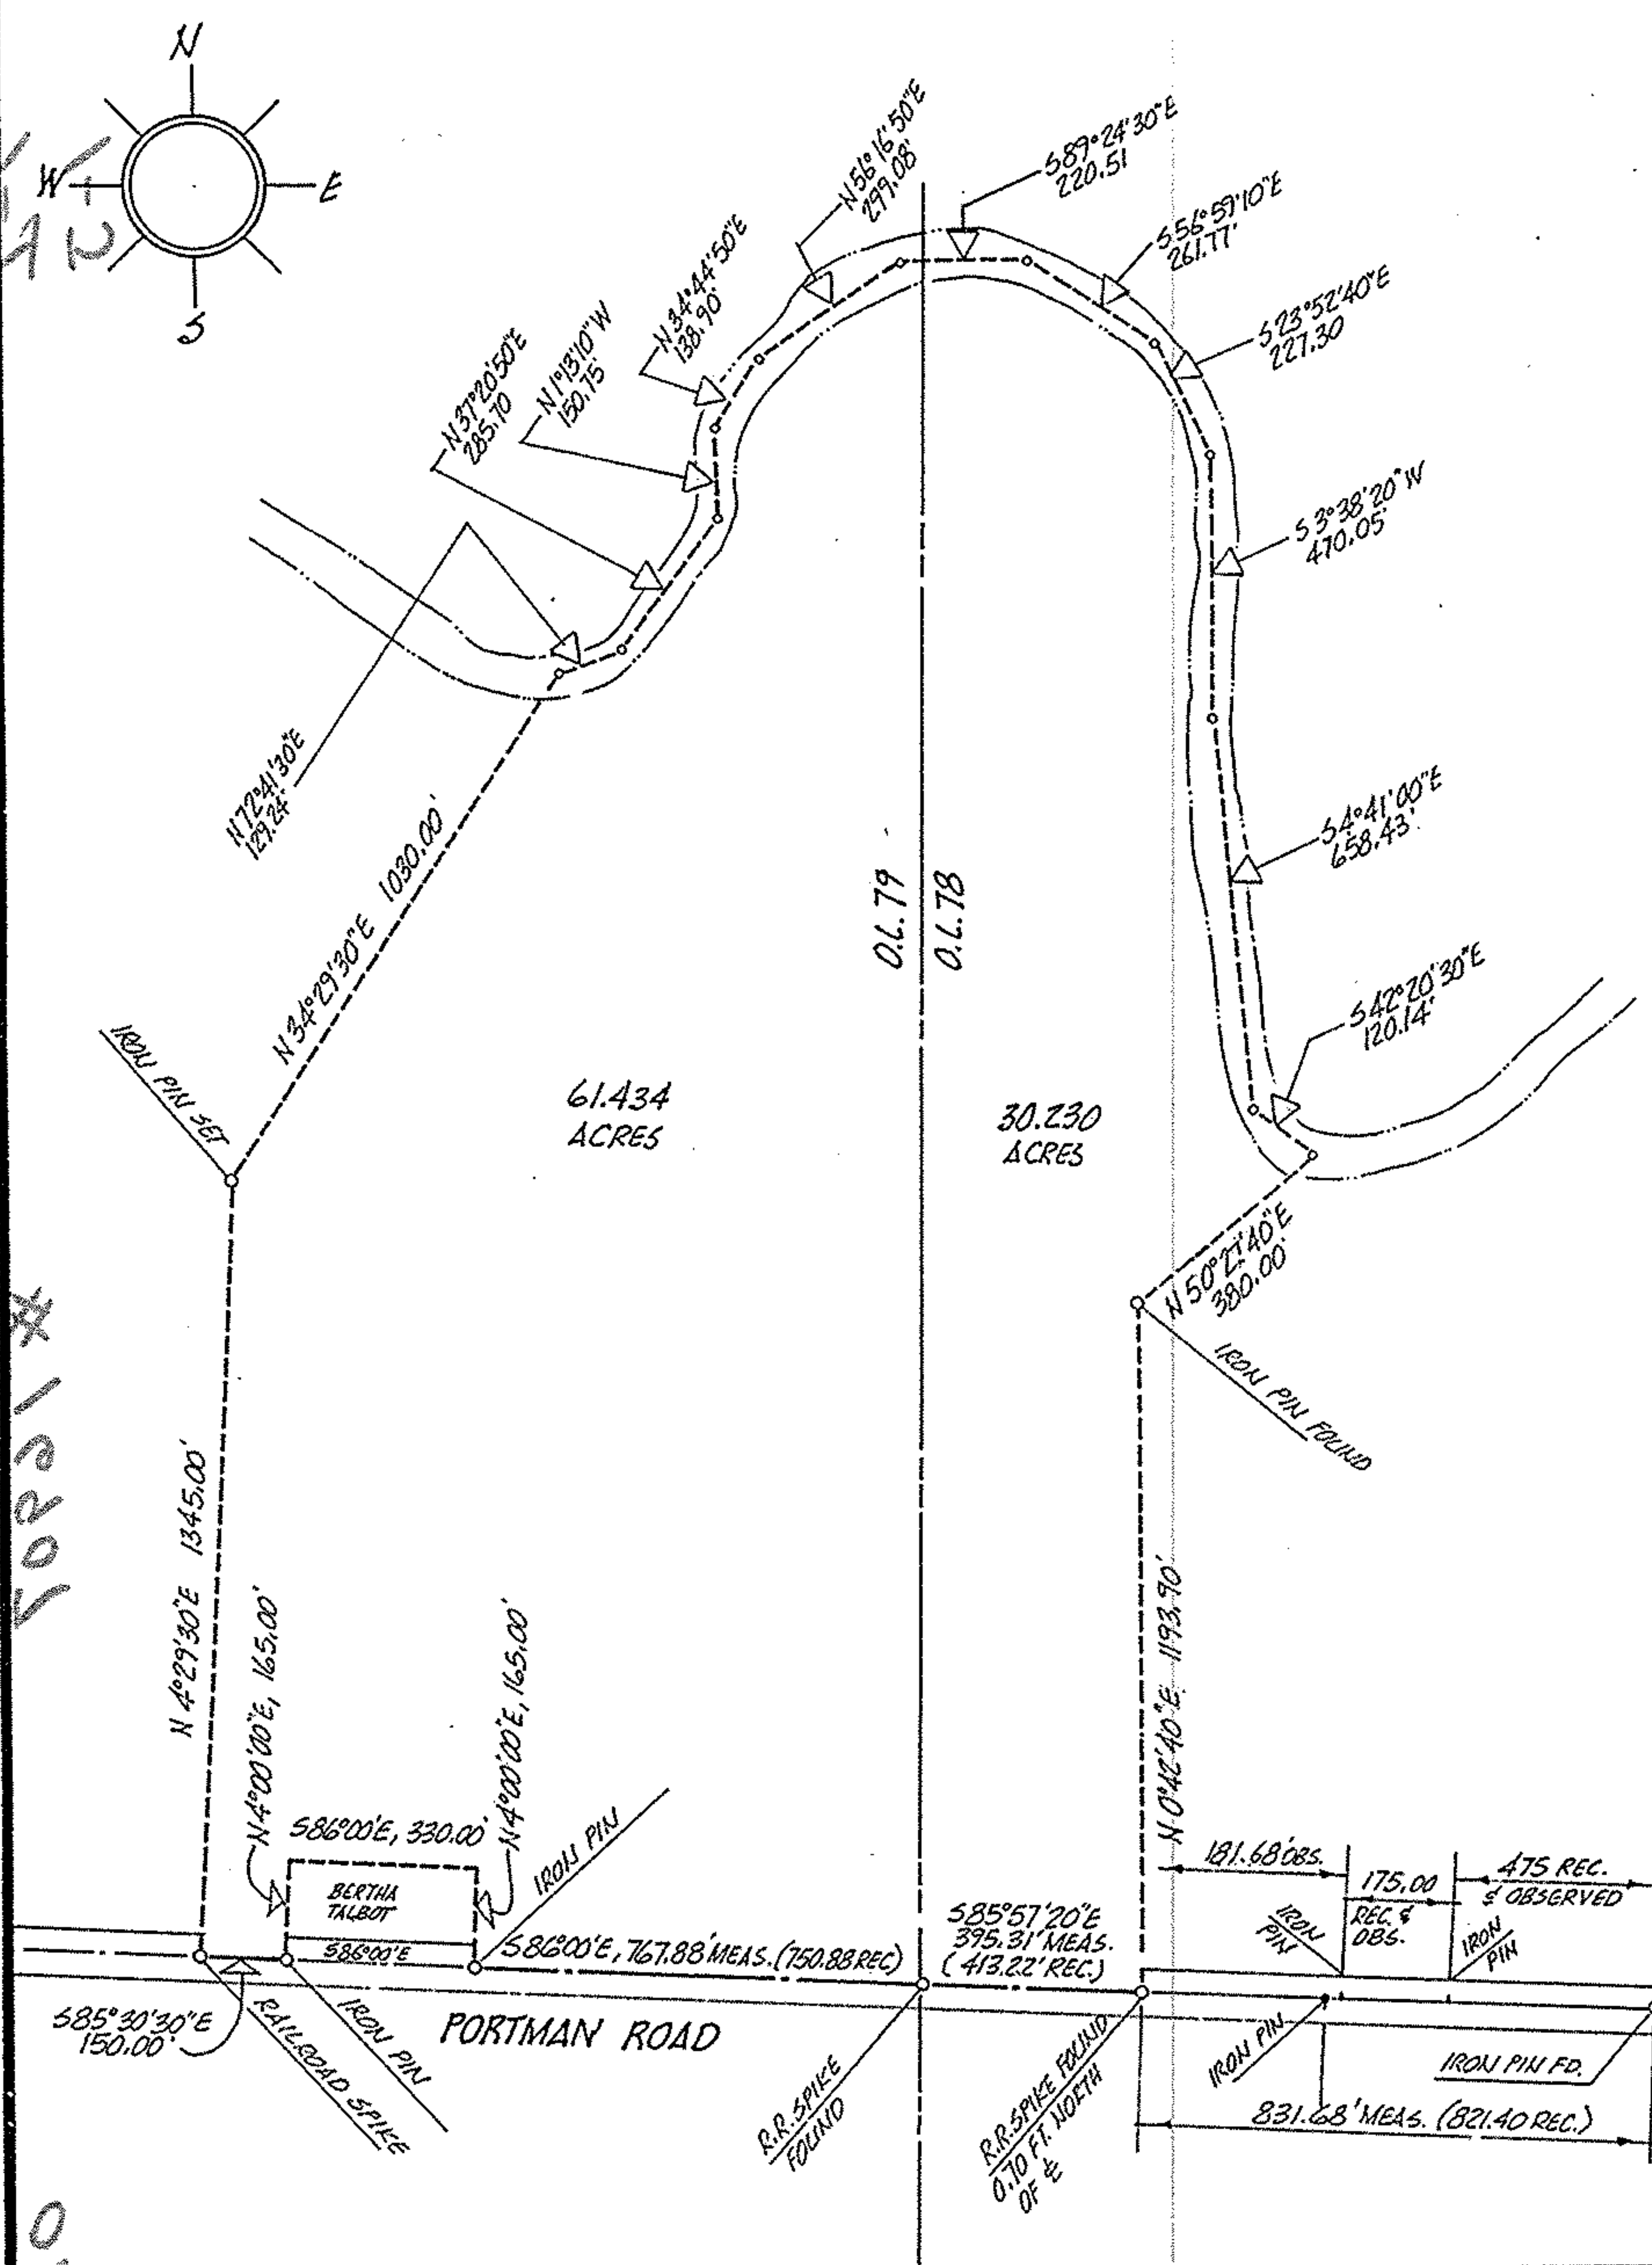

1-I 0.7-79

0.7-79

ACREAGE	91.664
DATE	04-09-86
DRAWN	MGH
SCALE	1" = 400 ft.

PREPARED FOR ROLLAND ANGERSBACH, PORTMAN RD. 965-7141
#51900 PORTMAN ROAD, AMHERST, OHIO

MICHAEL G. HURA, registered surveyor.
 12706 MASON RD., VERMILION, O., Ph(216) 965 4040

CITY OF



PERIMETER SURVEY

SUBLOT(s) _____ of _____
 _____, Volume _____ Page _____ of PLATS
 PART OF O.L.'s 78-79 TRACT _____ SECTION _____ OF
BROWNHELM TOWNSHIP LORAIN CO., OHIO
 PERMANENT PARCEL NO. _____