

J. W. WARDEN & ASSOCIATES

STATE OF OHIO

CIVIL ENGINEERS AND SURVEYORS


D. D. ANDRUS, PRESIDENT
405 ELYRIA BLOCK
ELYRIA, OHIO

TELEPHONES FA 2-9828
FA 2-1466

M. W. JACKSON
SECRETARY

PPN 05-00-068-000-030

MAP PG 05-00-068-A

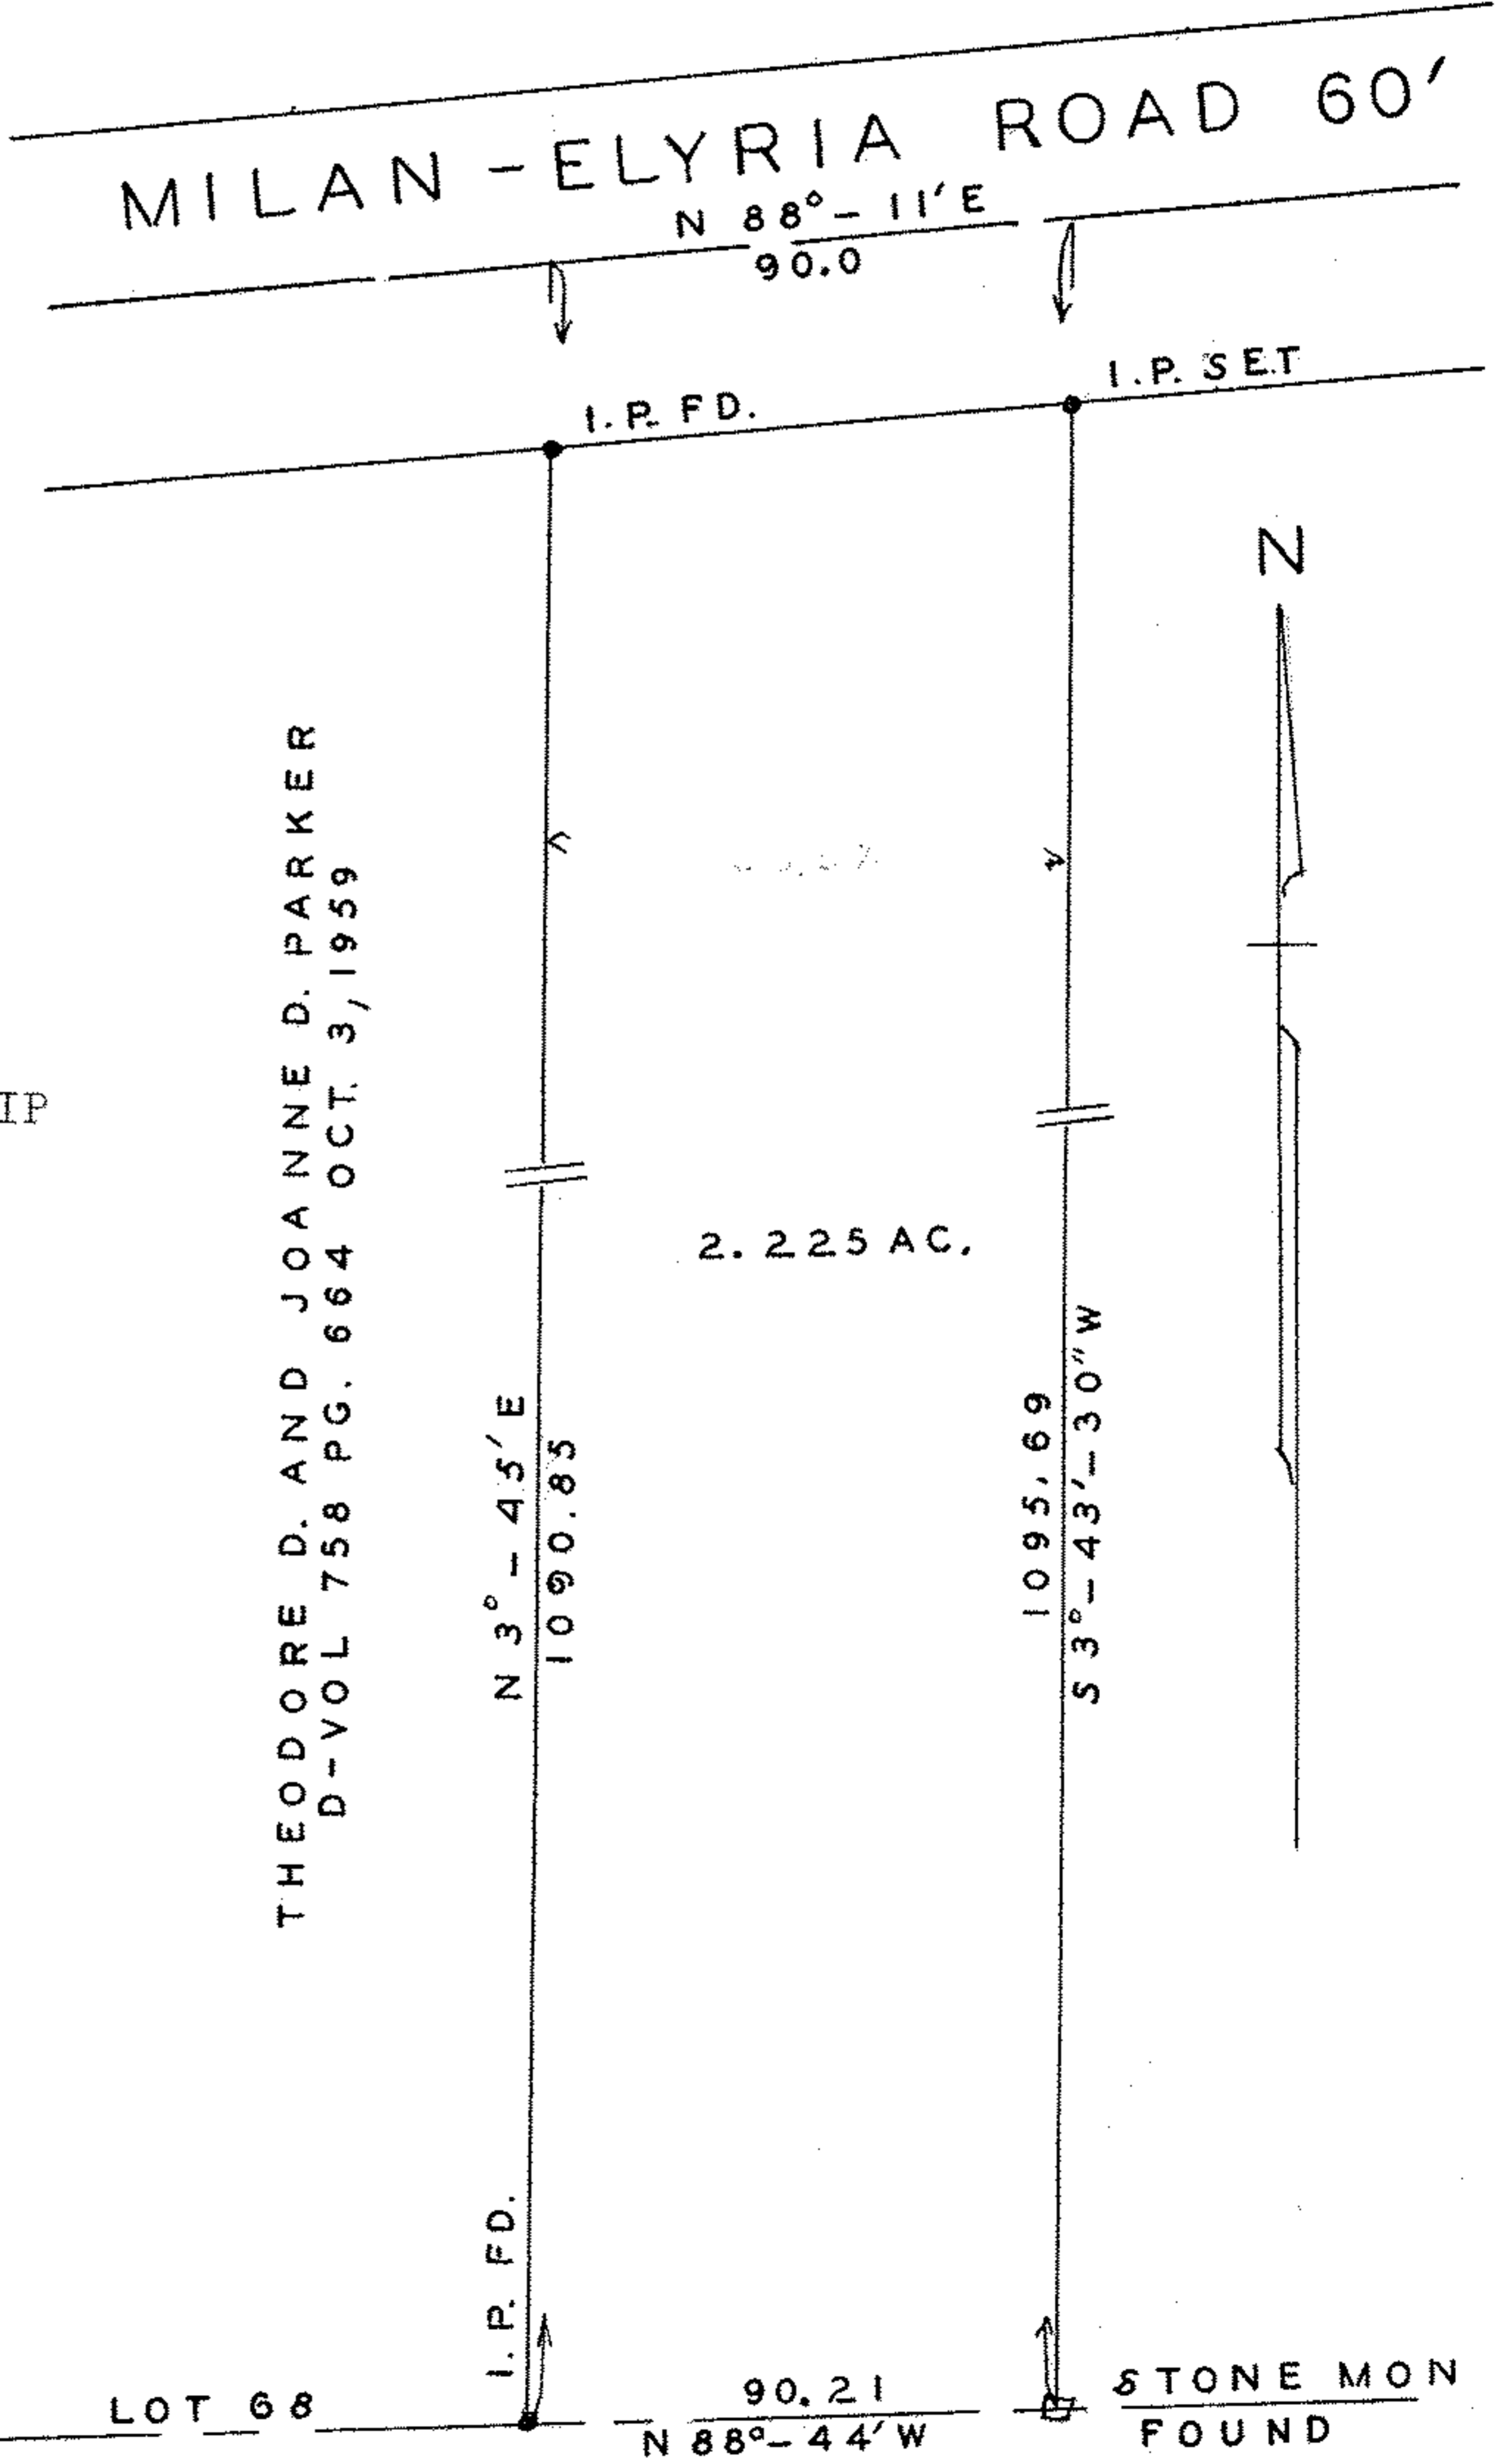

SURVEY FOR
KATHRYN L. SNYDER
O. L. 68 AMHERST TOWNSHIP
LORAIN COUNTY, OHIO
APRIL 10, 1963

THEODORE D. AND JOANNE D. PARKER
D-VOL 758 PG. 664 OCT. 3, 1959

13-1067D

