


PPN 18-00-028-101-023 → 026


SCAN 41357

MAP Pg 1800-028-B

SURVEY FOR
DELBERT YOHO
PREMISES OF
MABEL SOOY
WELLINGTON VILL., LORAIN CO.,
OHIO
PART OF O.L. 28 WELL. TWP.
SCALE 1" = 30' MAY 25, 1966
D.D. ANDRUS AND ASSOCIATES
REG SURVEYORS

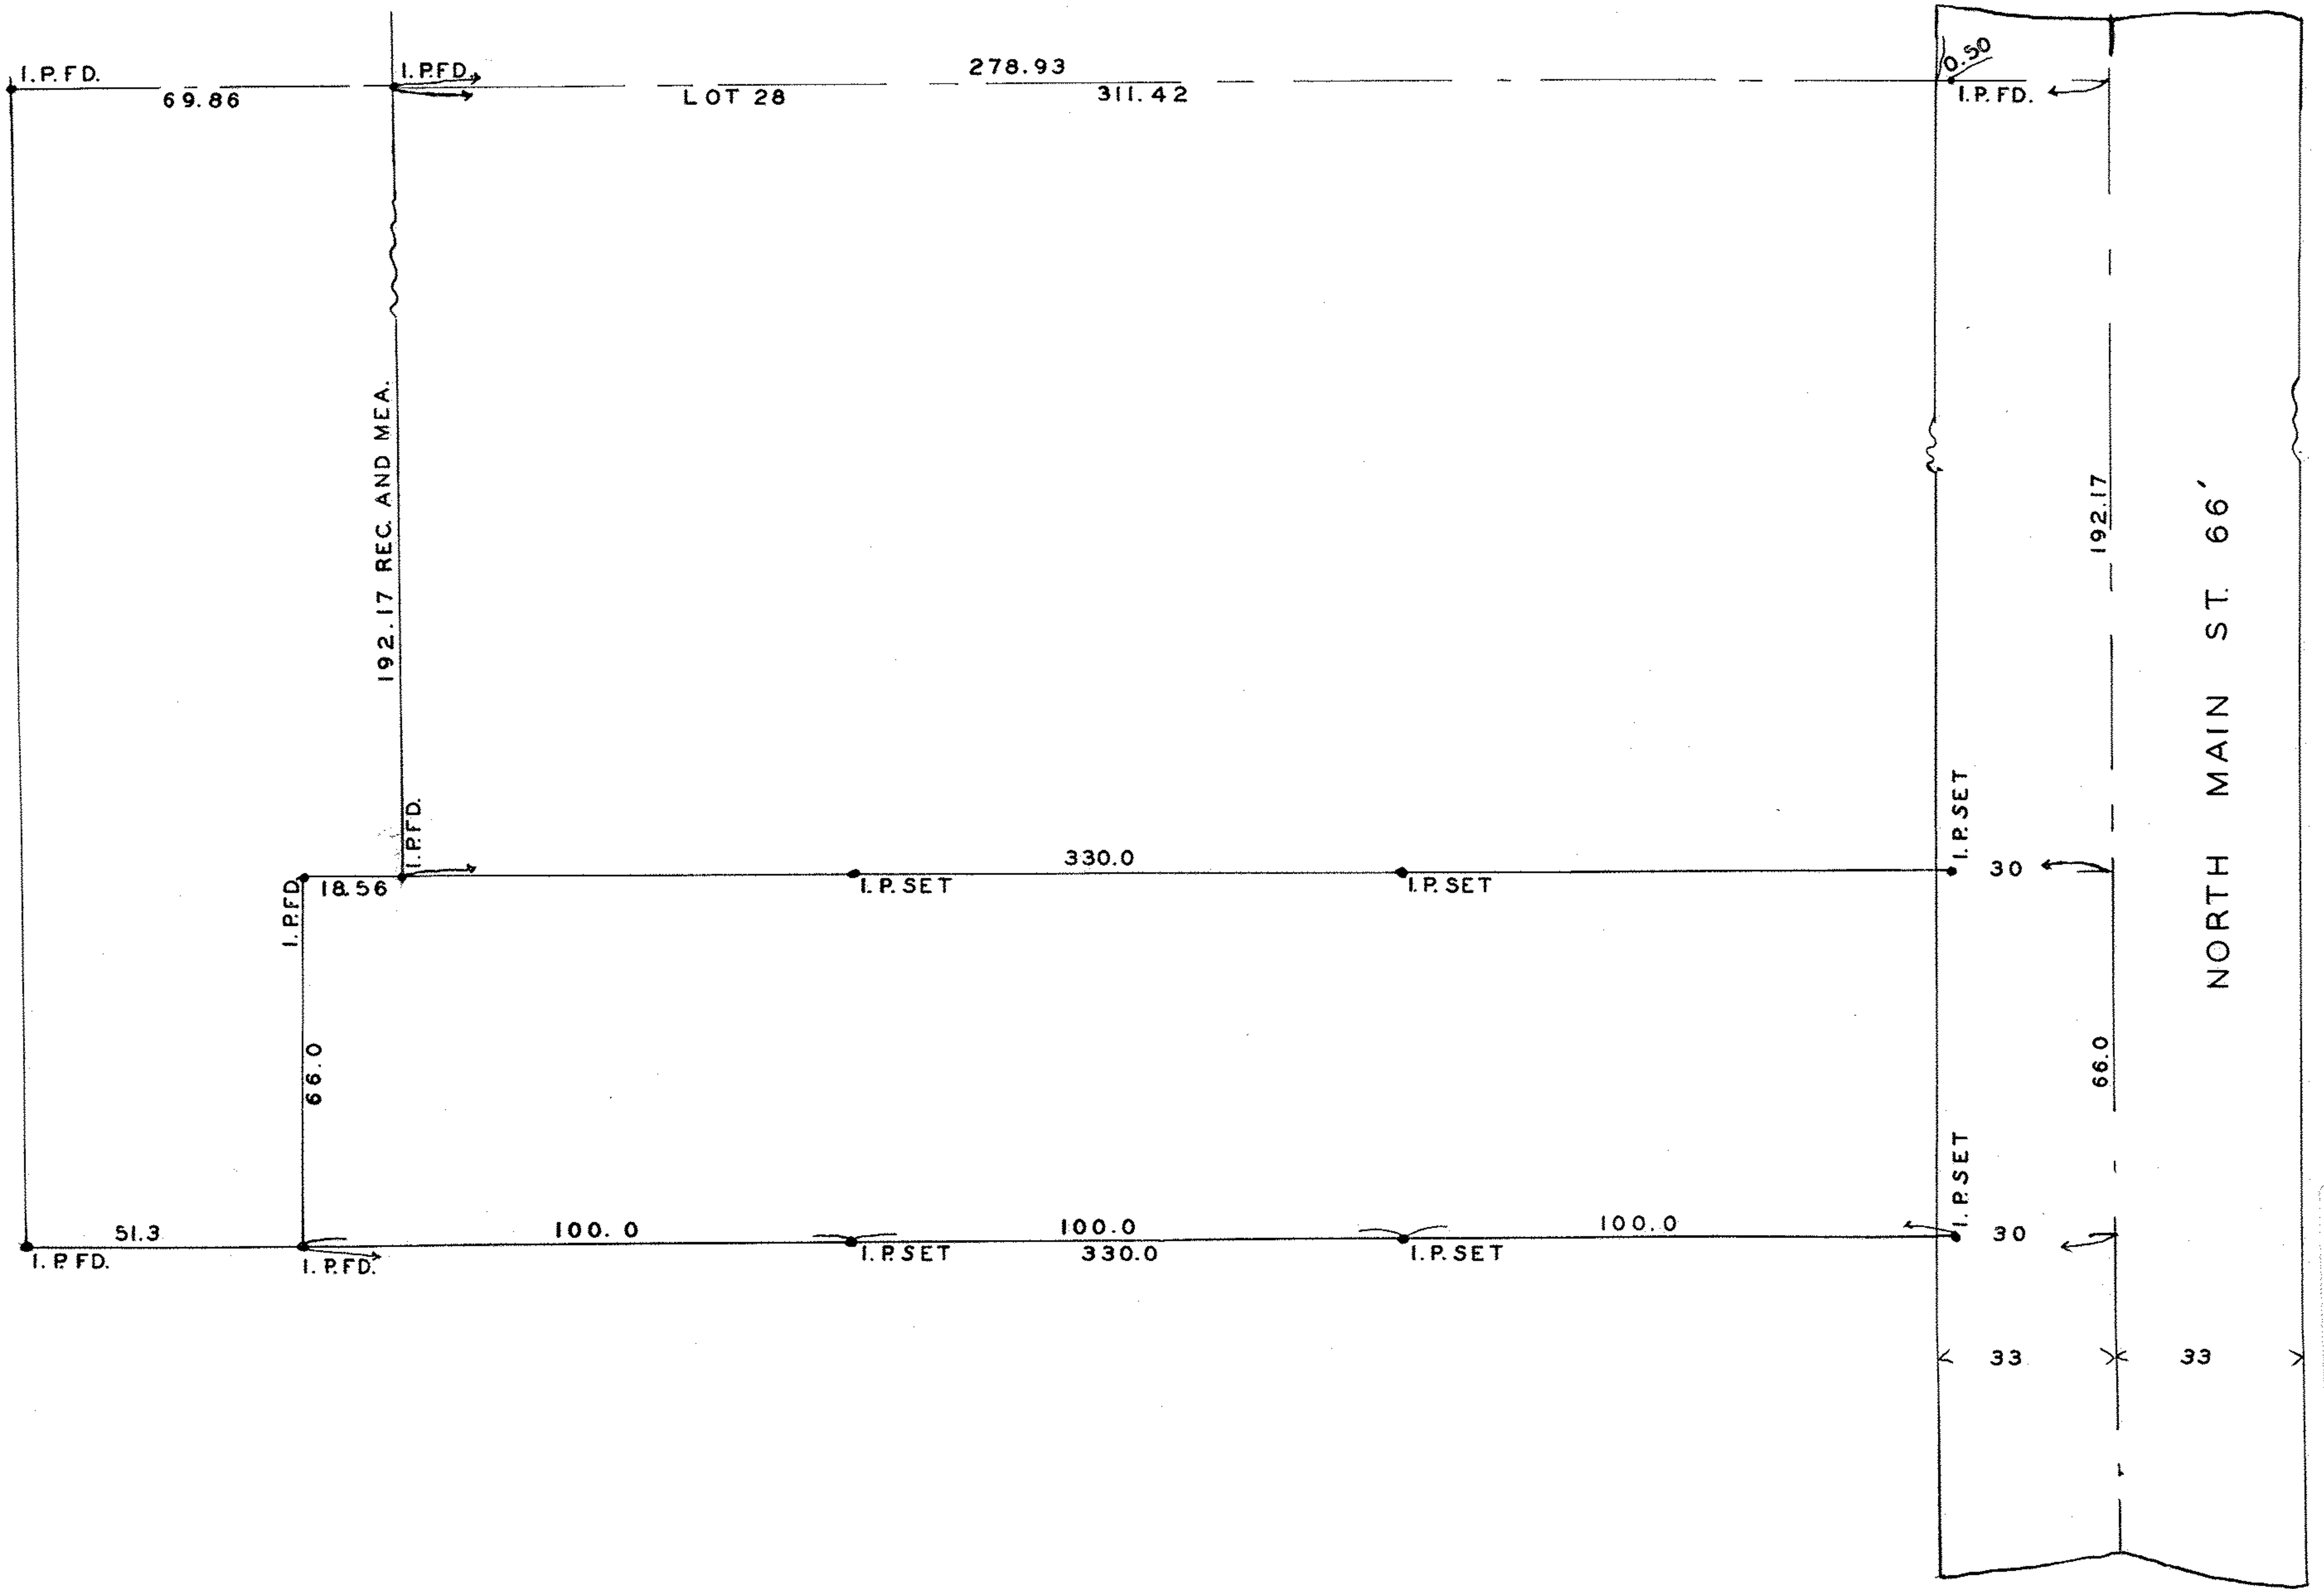

13-1210

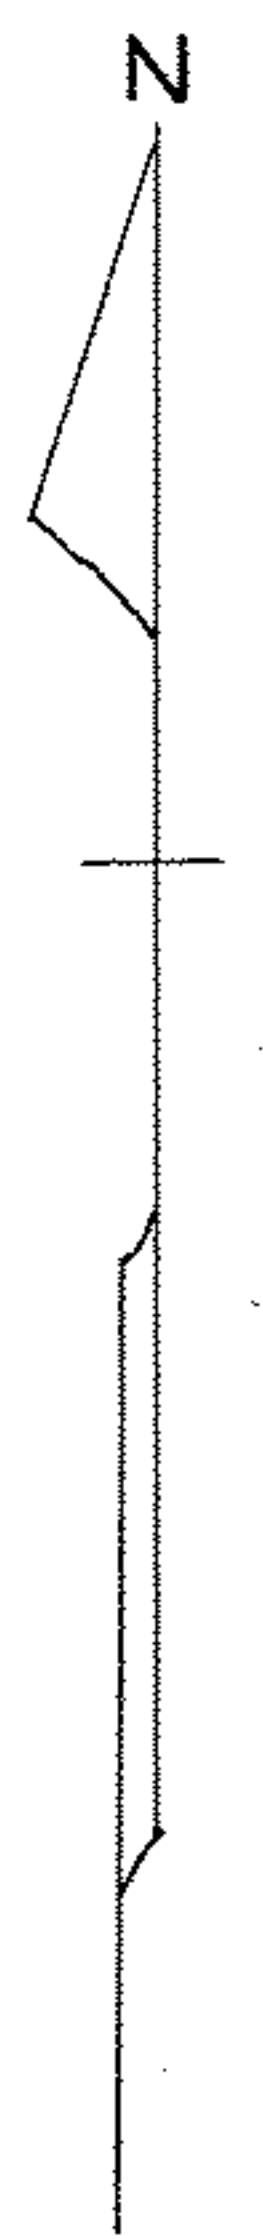

13-1510