

SURVEY MAP FOR

THE SHELL OIL COMPANY (A DELAWARE CORPORATION)

LOT 113 EAST OF BLACK RIVER CITY OF ELYRIA LORAIN CO. OHIO



Scale 1" = 30 FT July 21-1947 C.E. Penfound Registered Surveyor

Resurveyed & Revised Feb. 20-1956

Area Shell Oil Co. Property

South Line Lot 113 to Broad St. 0.485 Acre

Occupation Line to Broad St. 0.480 Acre

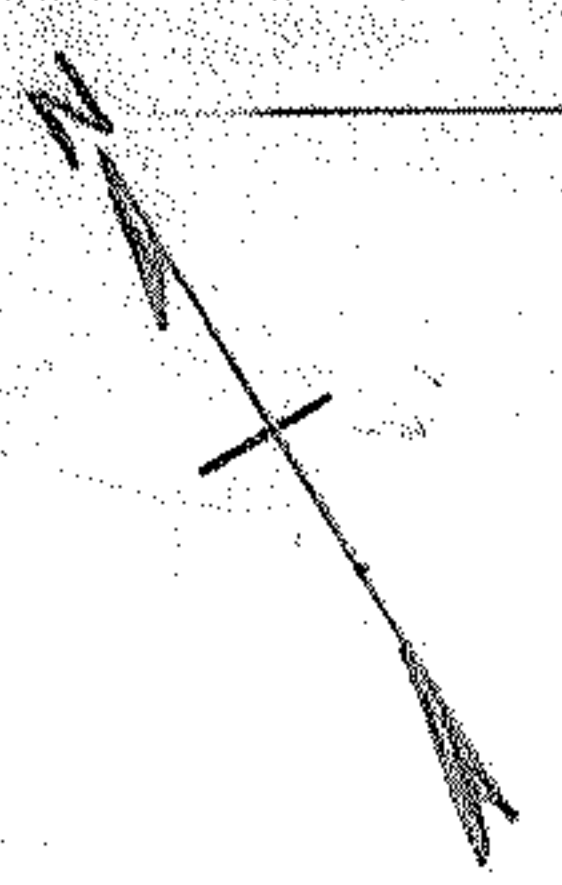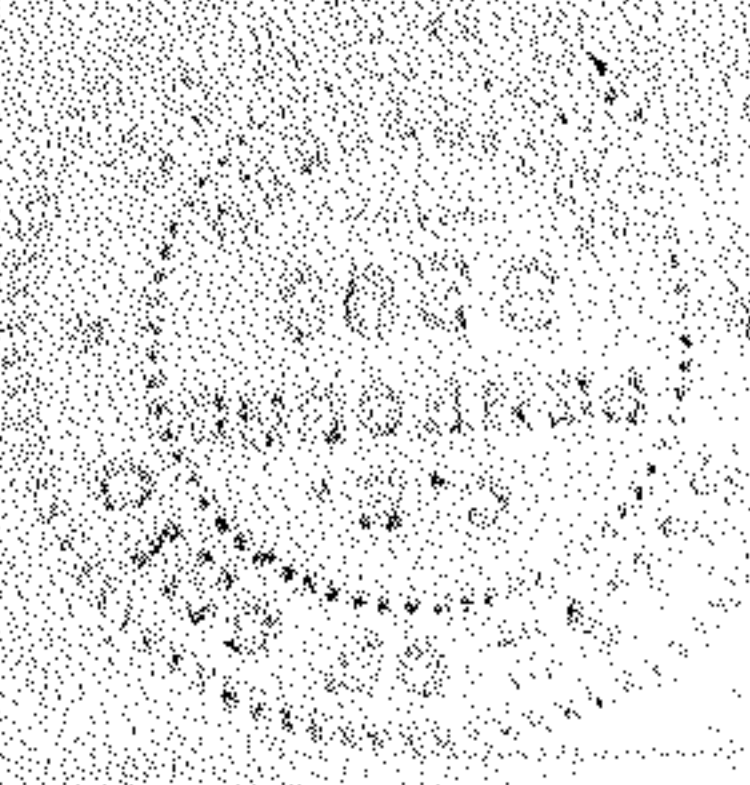

EAST BRANCH BLACK RIVER
High Water Mark

EAST BROAD STREET 66'

EAST RIVER STREET 66'

