


PPN 06-24-035-102-047,048

MAP PG 6-61

21-0483-1

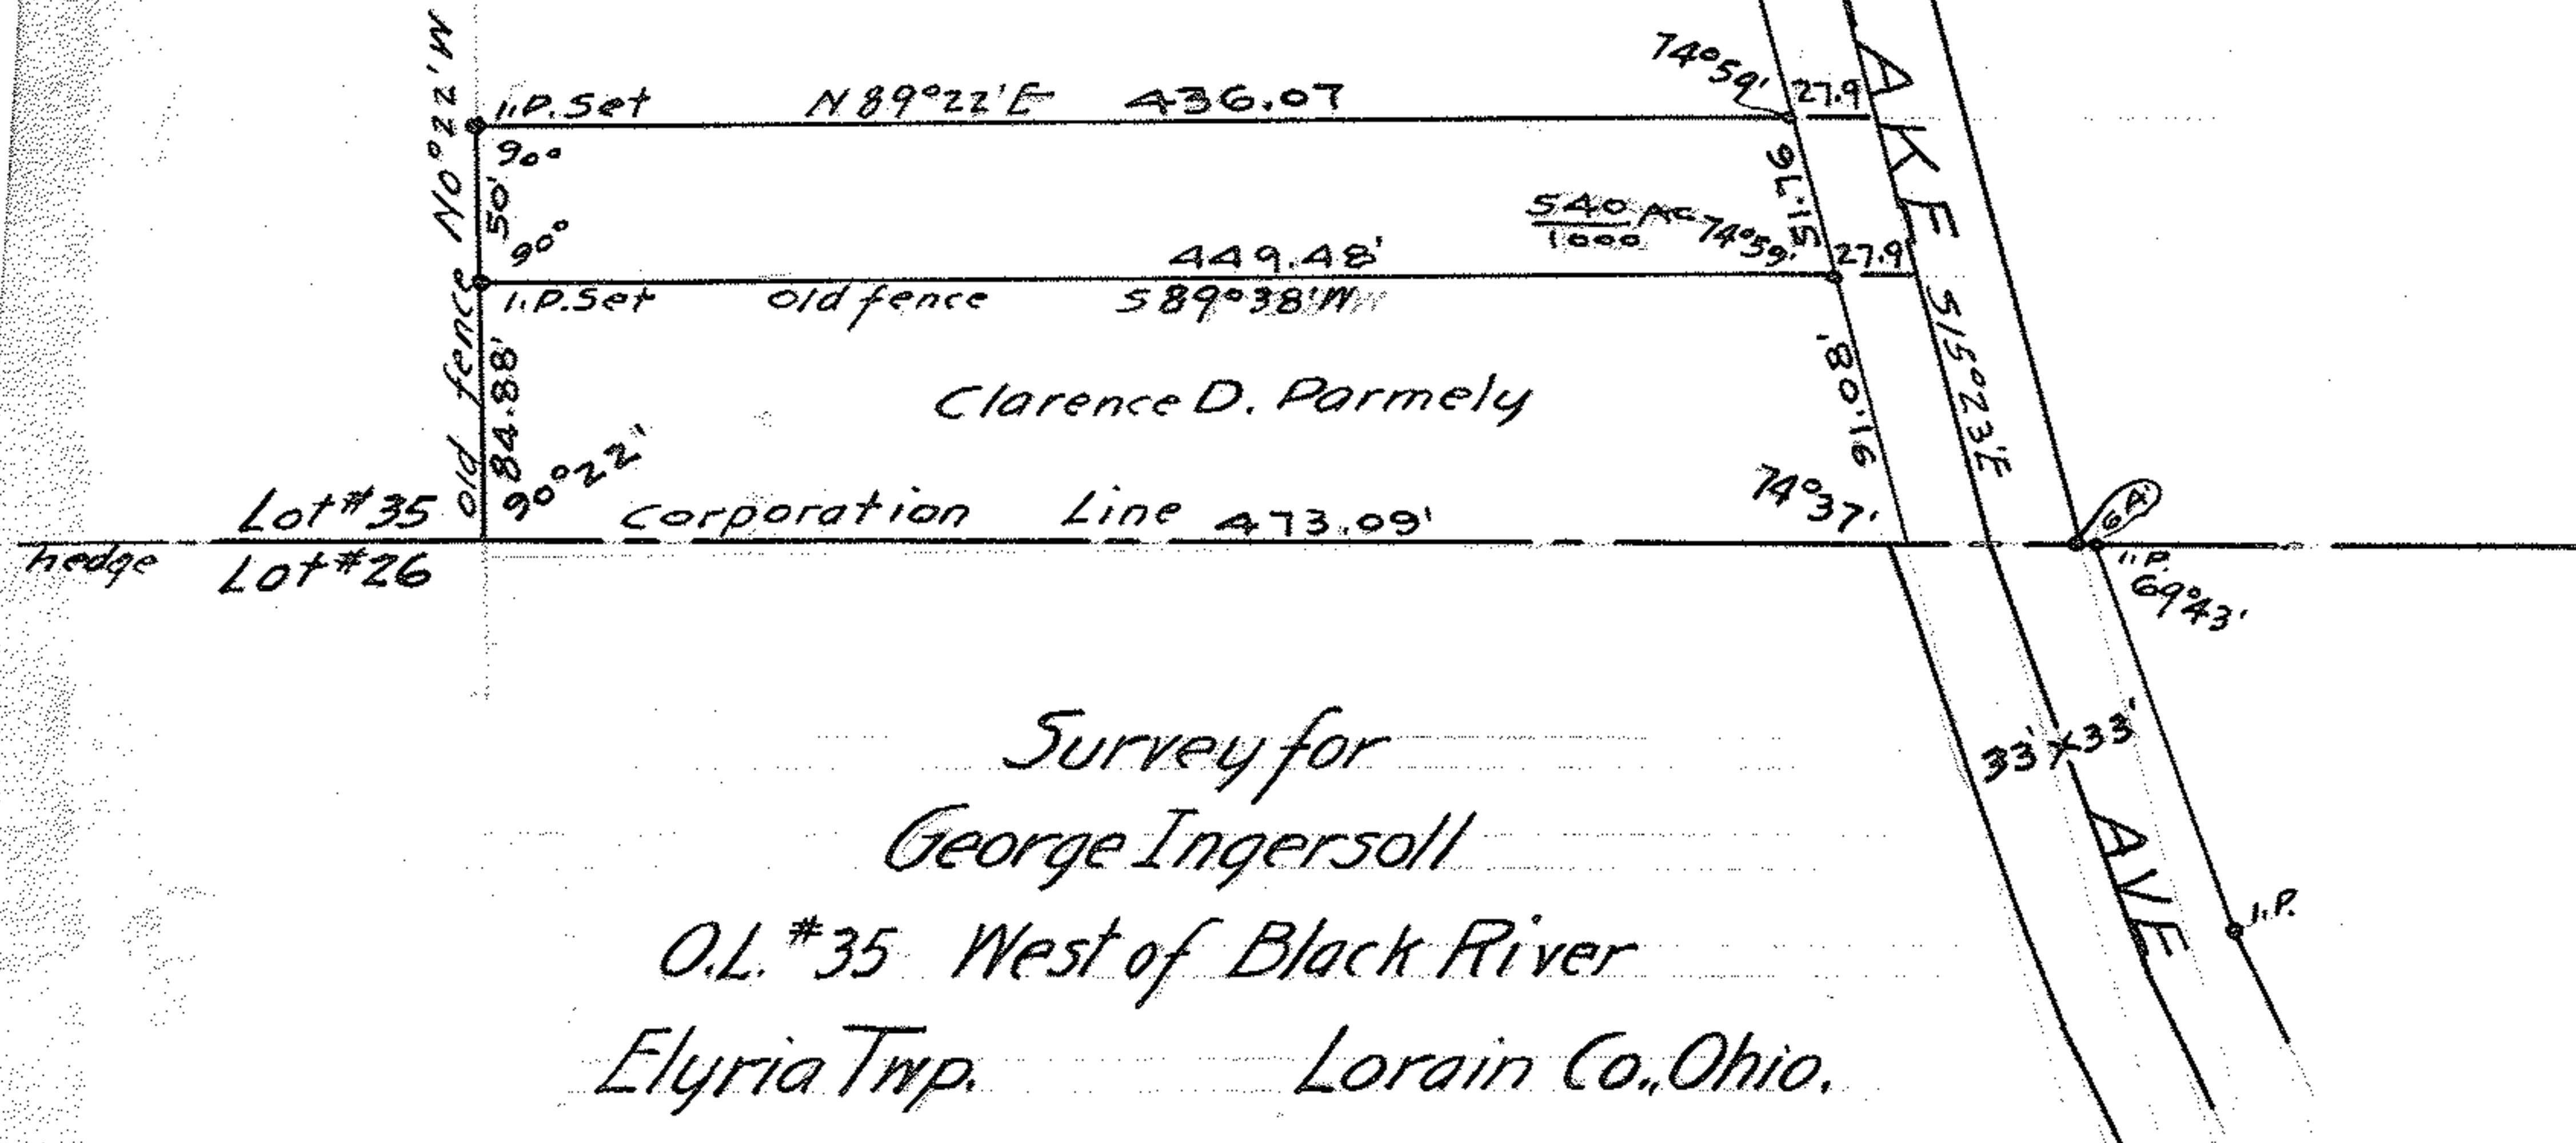

Survey for
 George Ingersoll
 O.L. #35 West of Black River
 Elyria Twp. Lorain Co., Ohio.
 Mar 10, 1915. F. P. Crosse C. E.