


WEST RIVER STREET 66'

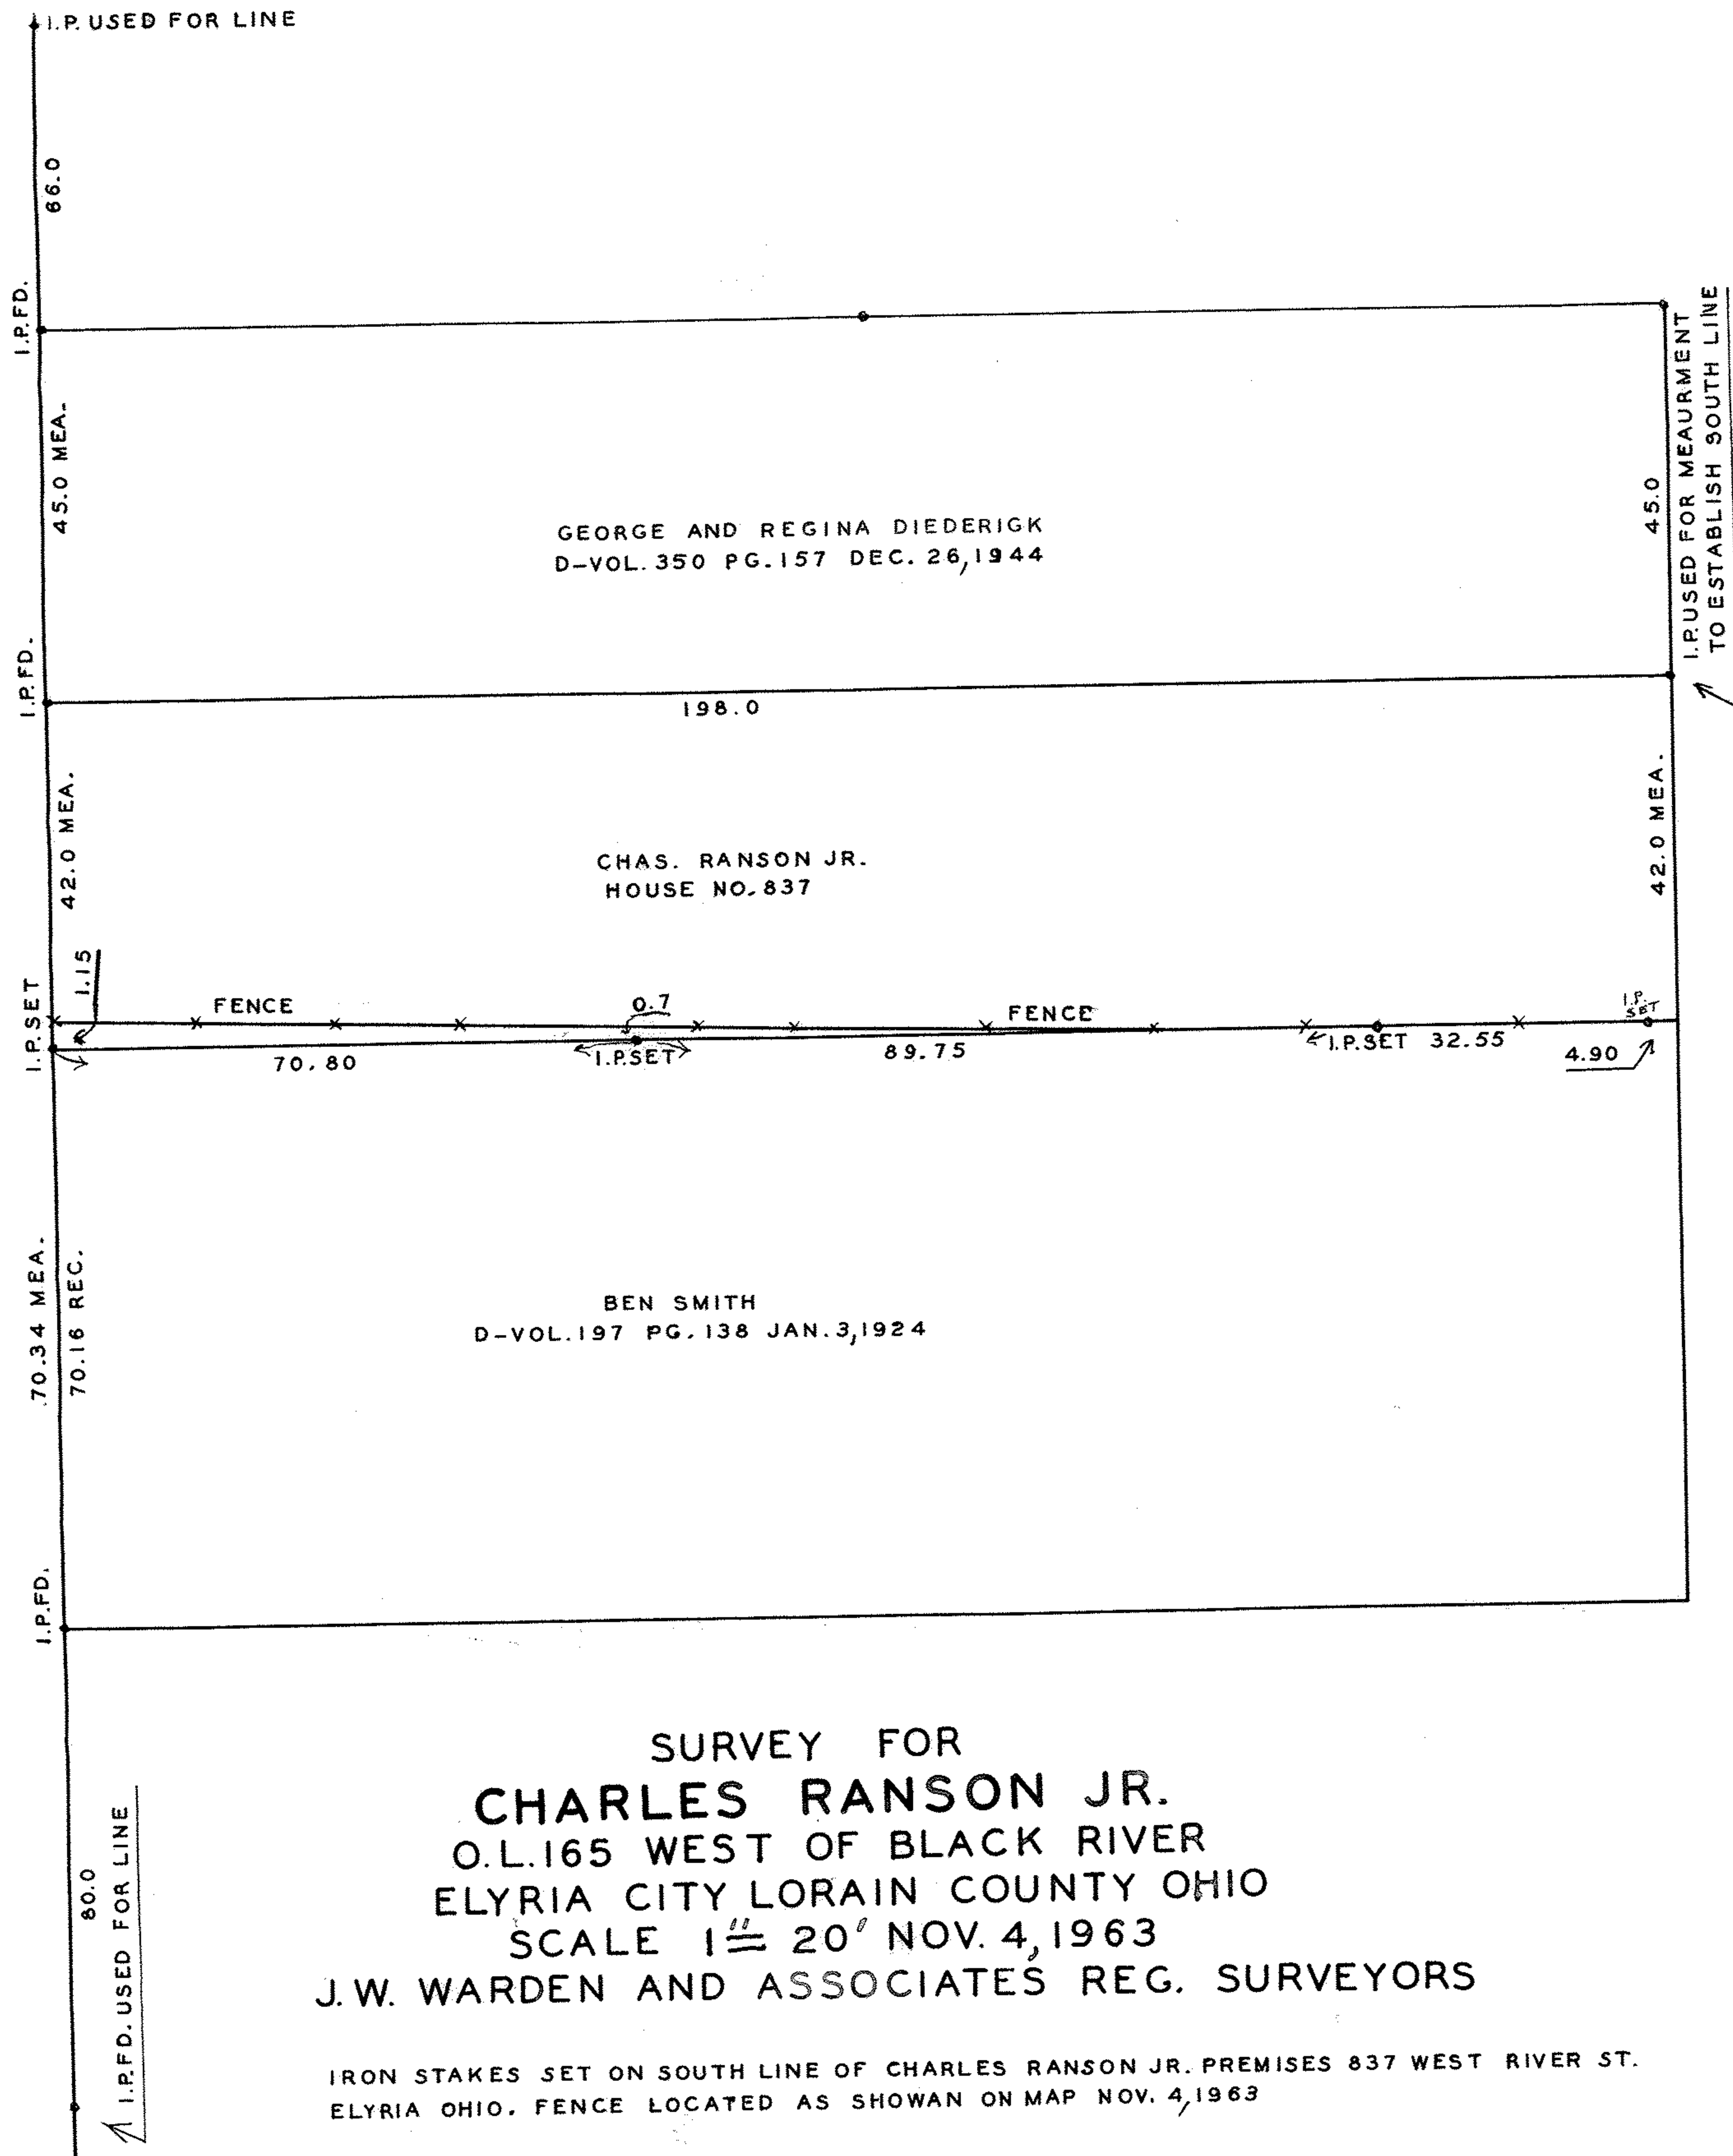

SURVEY FOR  
**CHARLES RANSON JR.**  
O.L. 165 WEST OF BLACK RIVER  
ELYRIA CITY LORAIN COUNTY OHIO  
SCALE 1" = 20' NOV. 4, 1963  
J.W. WARDEN AND ASSOCIATES REG. SURVEYORS

IRON STAKES SET ON SOUTH LINE OF CHARLES RANSON JR. PREMISES 837 WEST RIVER ST.  
ELYRIA OHIO. FENCE LOCATED AS SHOWN ON MAP NOV. 4, 1963

PPN 06-24-165-000008

MAP PG 683