

J. W. WARDEN & ASSOCIATES


CIVIL ENGINEERS AND SURVEYORS

D. D. ANDRUS, PRESIDENT
405 ELYRIA BLOCK
ELYRIA, OHIO

STATE OF OHIO
REGISTERED { PROFESSIONAL ENG.
SURVEYOR

TELEPHONES 3211
42871

M. W. JACKSON
SECRETARY

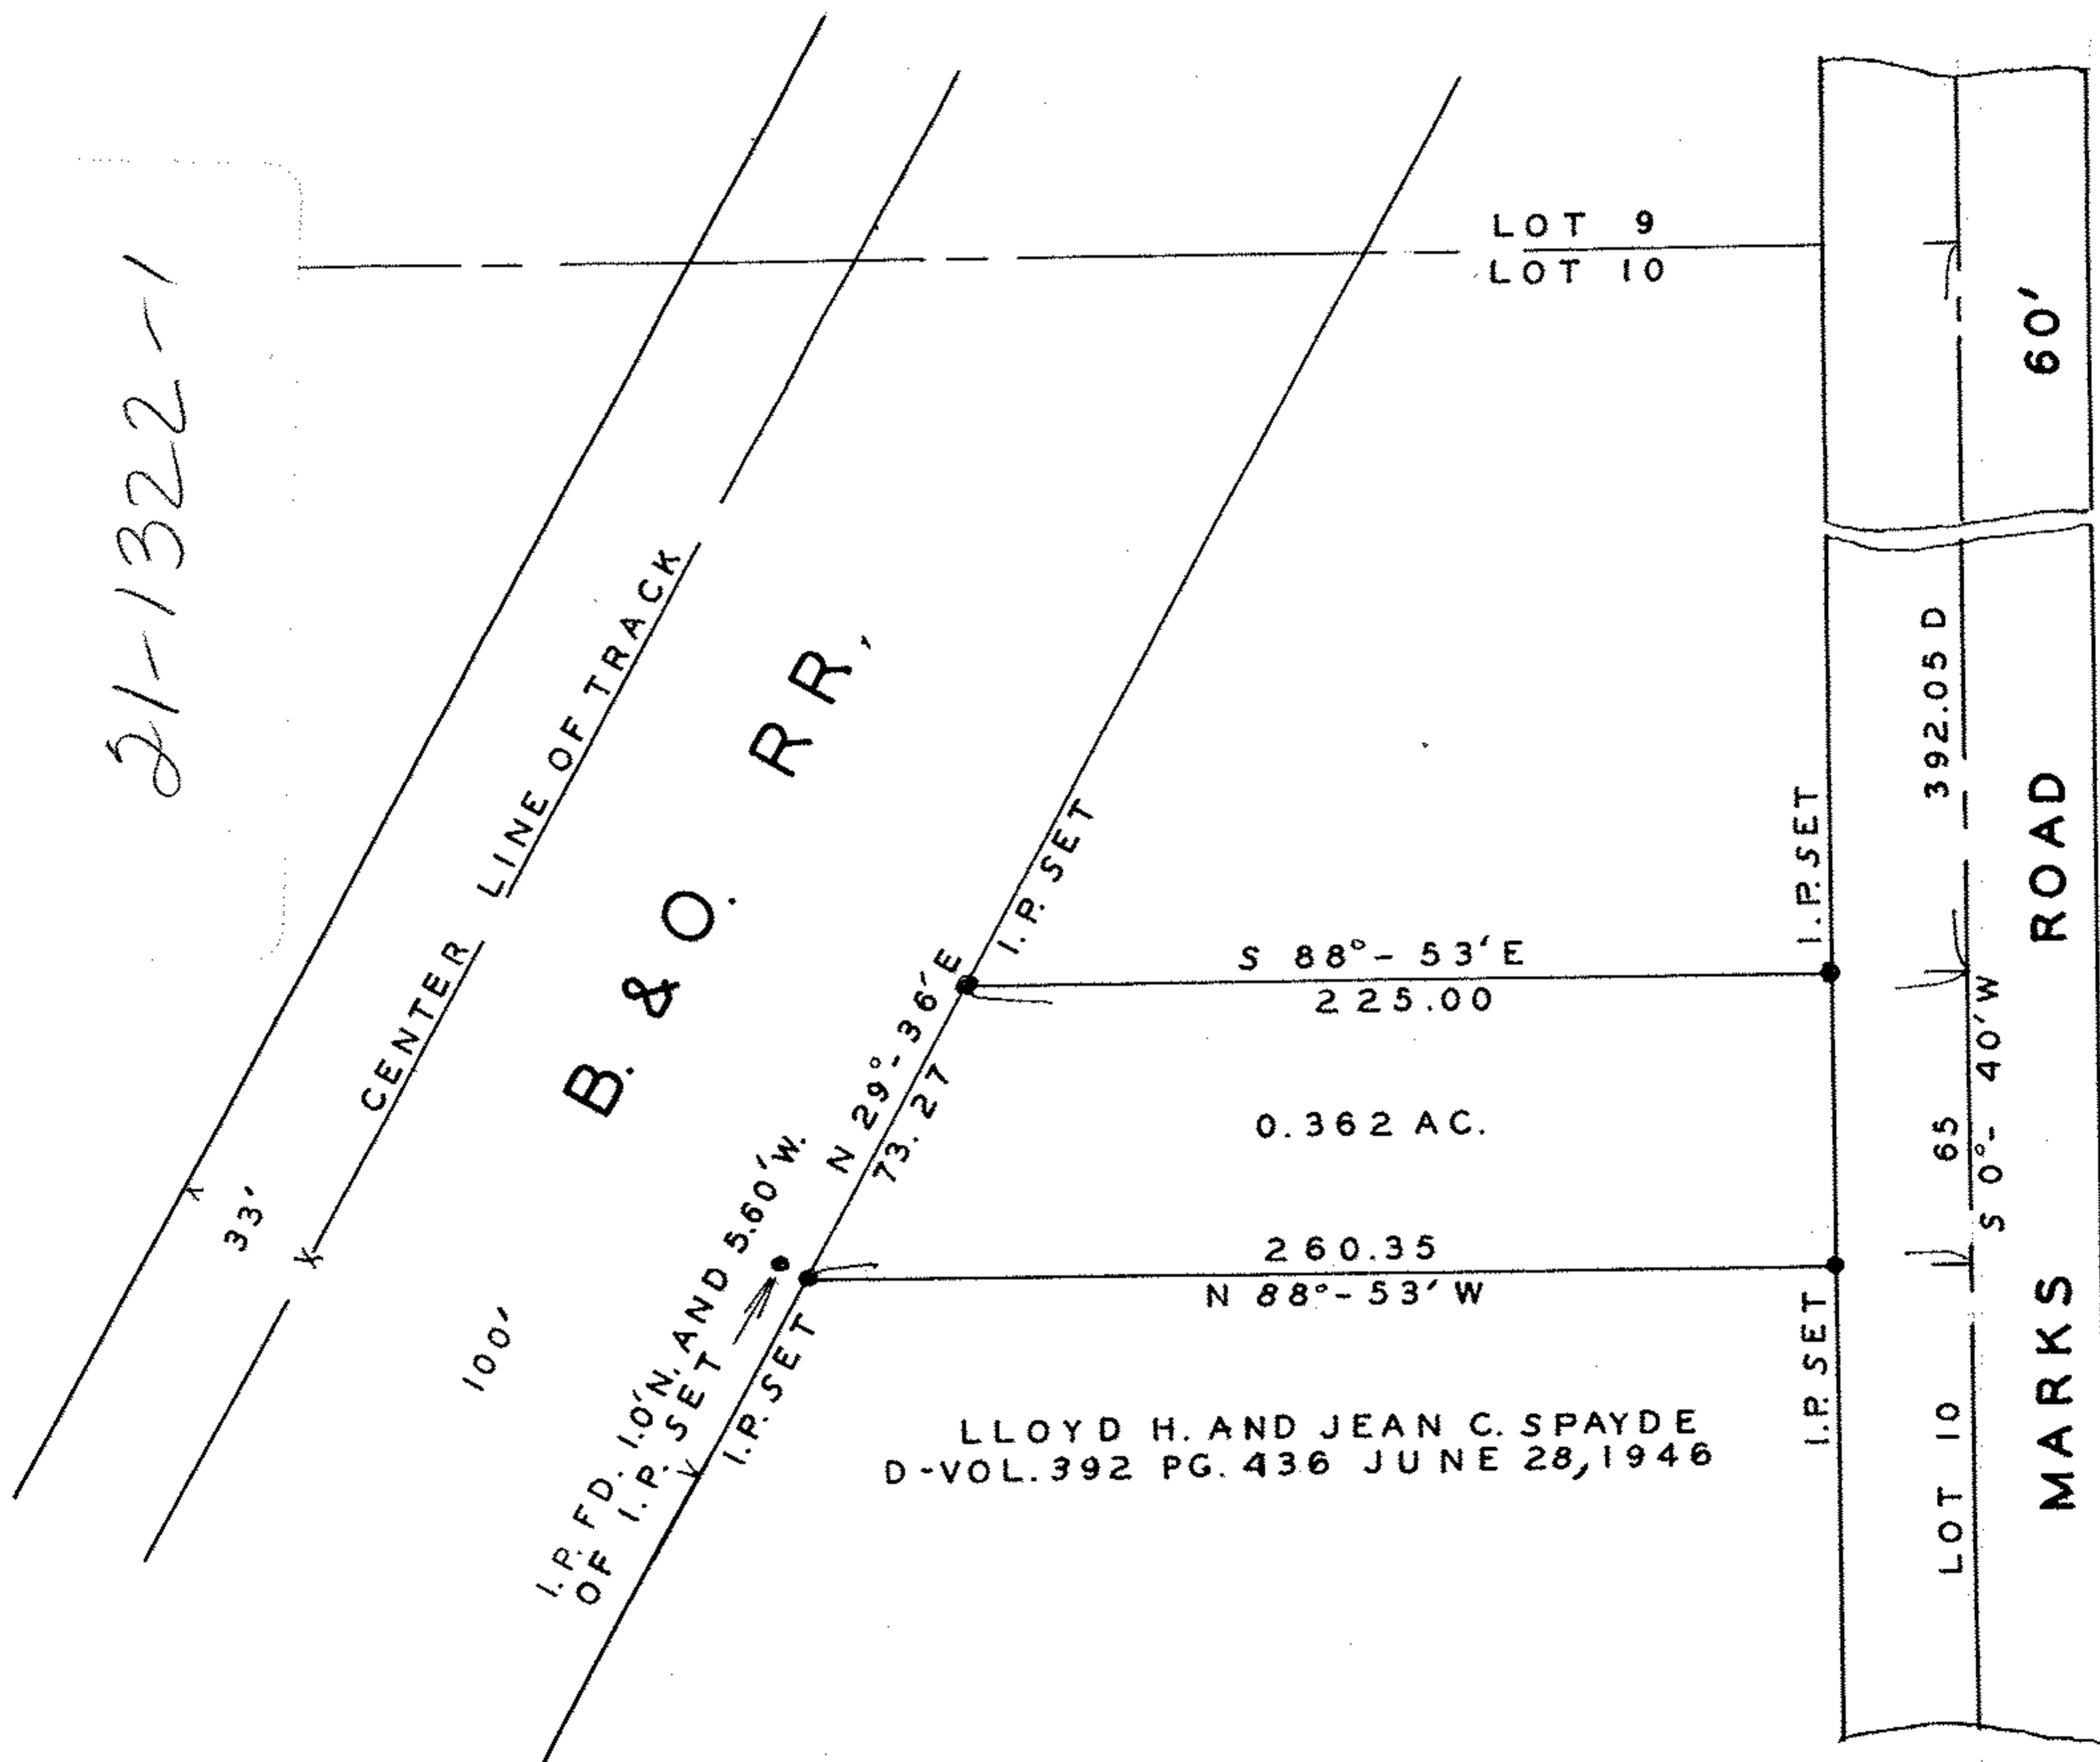

LLOYD H. AND JEAN C. SPAYDE
D-VOL. 392 PG. 436 JUNE 28, 1946

SURVEY FOR
LLOYD H. AND JEAN C. SPAYDE
PREMISES OF
ROSE AND ROSE LEASOCK