


519

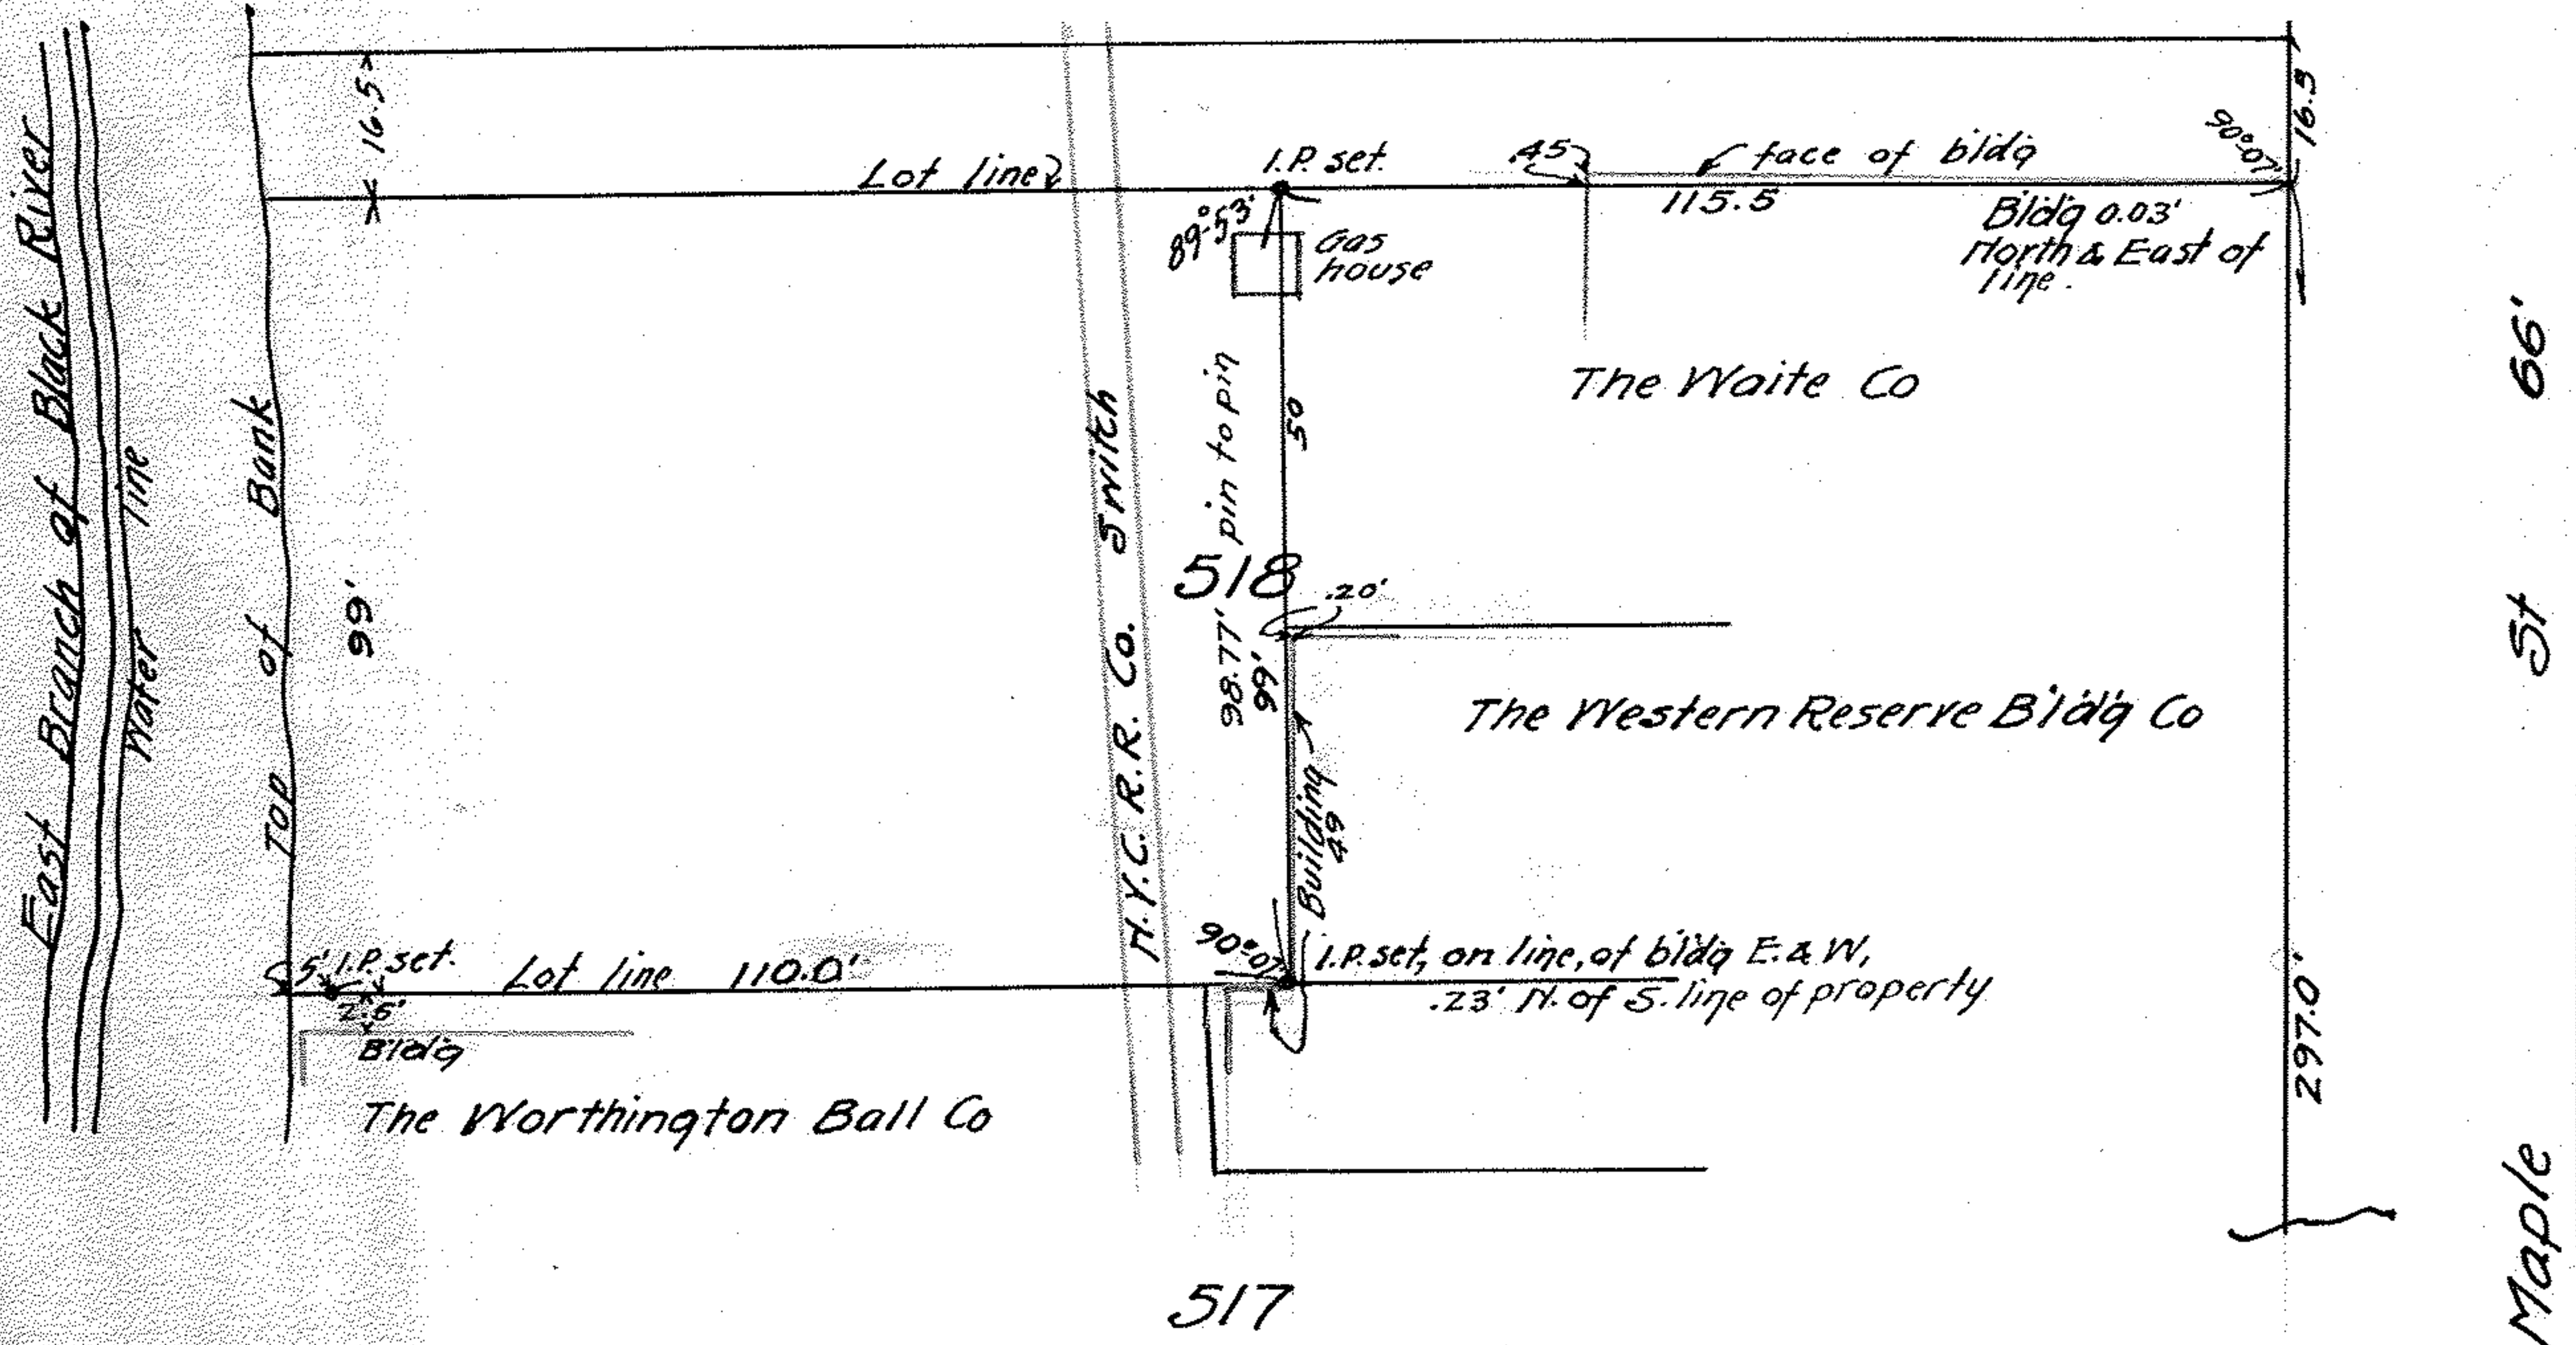

Survey for The I. T. S. Rubber Co
Parts of Lots 518-519 Block 96
Between Branches of Black River, Elyria, Lorain Co. Ohio.
Aug 19, 19. Scale 1" = 30' Warden & Laundon, C.E.'s

300742 B