


200  
GRAPHIC SCALE - FEET

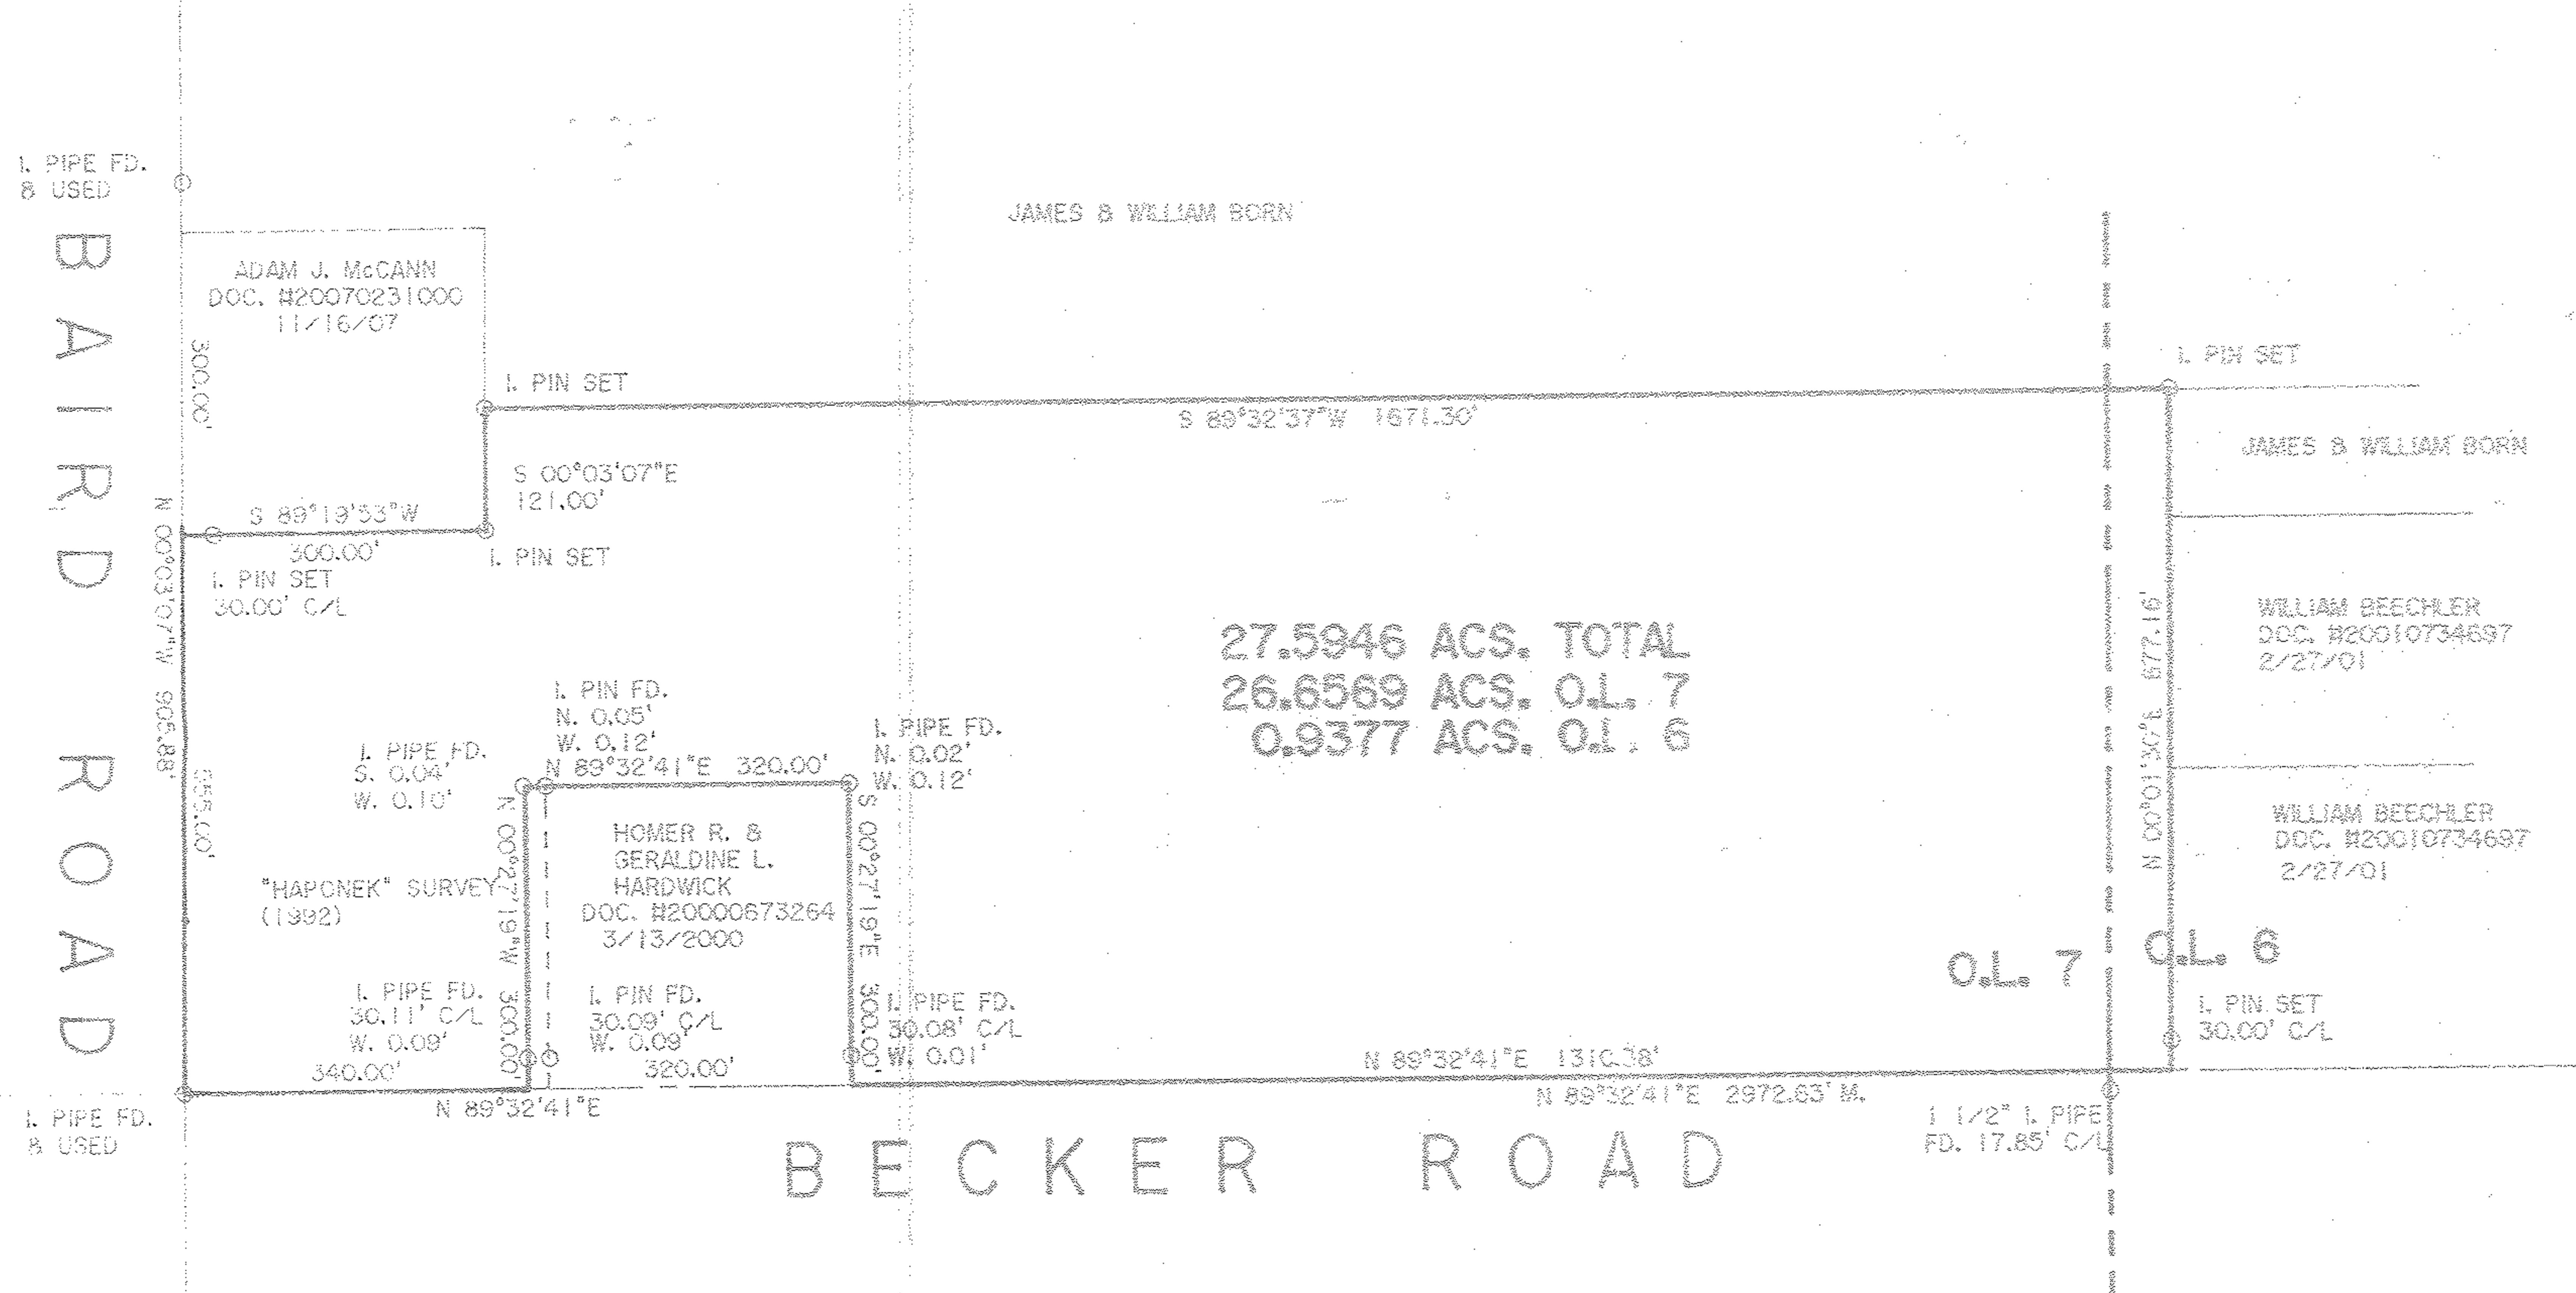

DIMENSIONS SHOWN ON THIS PLAT ARE EXPRESSED IN FEET AND DECIMAL PARTS THEREOF. ALL BEARINGS ARE TO AN ASSUMED MERIDIAN AND ARE USED TO INDICATE ANGLES ONLY. PERMANENT MONUMENTS WERE FOUND OR SET AT ALL POINTS INDICATED HEREON, ALL OF WHICH I CERTIFY TO BE CORRECT.

*Reece*

THOMAS A. SIMON  
REG. PROFESSIONAL SURVEYOR  
NO. S-7775

BASIS OF BEARINGS IS THE CENTERLINE OF BECKER ROAD (NORTH 89°32'41" EAST). IRON PINS SET ARE 5/8" DIAMETER, 30" LONG WITH PLASTIC CAPS "T. SIMON, S-7775".

APPROVED
LORAIN CO.
MAP DEPT
DATE 5/18/09
8-12-007-B
PAGE 8-12-006-B
DY Holland
09-01827-C

## PLAT OF SURVEY FOR JAMES & WILLIAM BORN

BEING KNOWN AS PARTS OF ORIGINAL  
HENRIETTA TOWNSHIP LOT NOS. 6 AND 7  
TRACT 12

COUNTY OF LORAIN STATE OF OHIO

NOVEMBER, 2008 SCALE: 1" = 200'

THOMAS SIMON & ASSOCIATES, INC.  
PROFESSIONAL LAND SURVEYORS

150 SOUTH OLIVE STREET  
ELYRIA, OHIO 44035

(440) 327-2925  
FAX 327-2964