


3-12-37

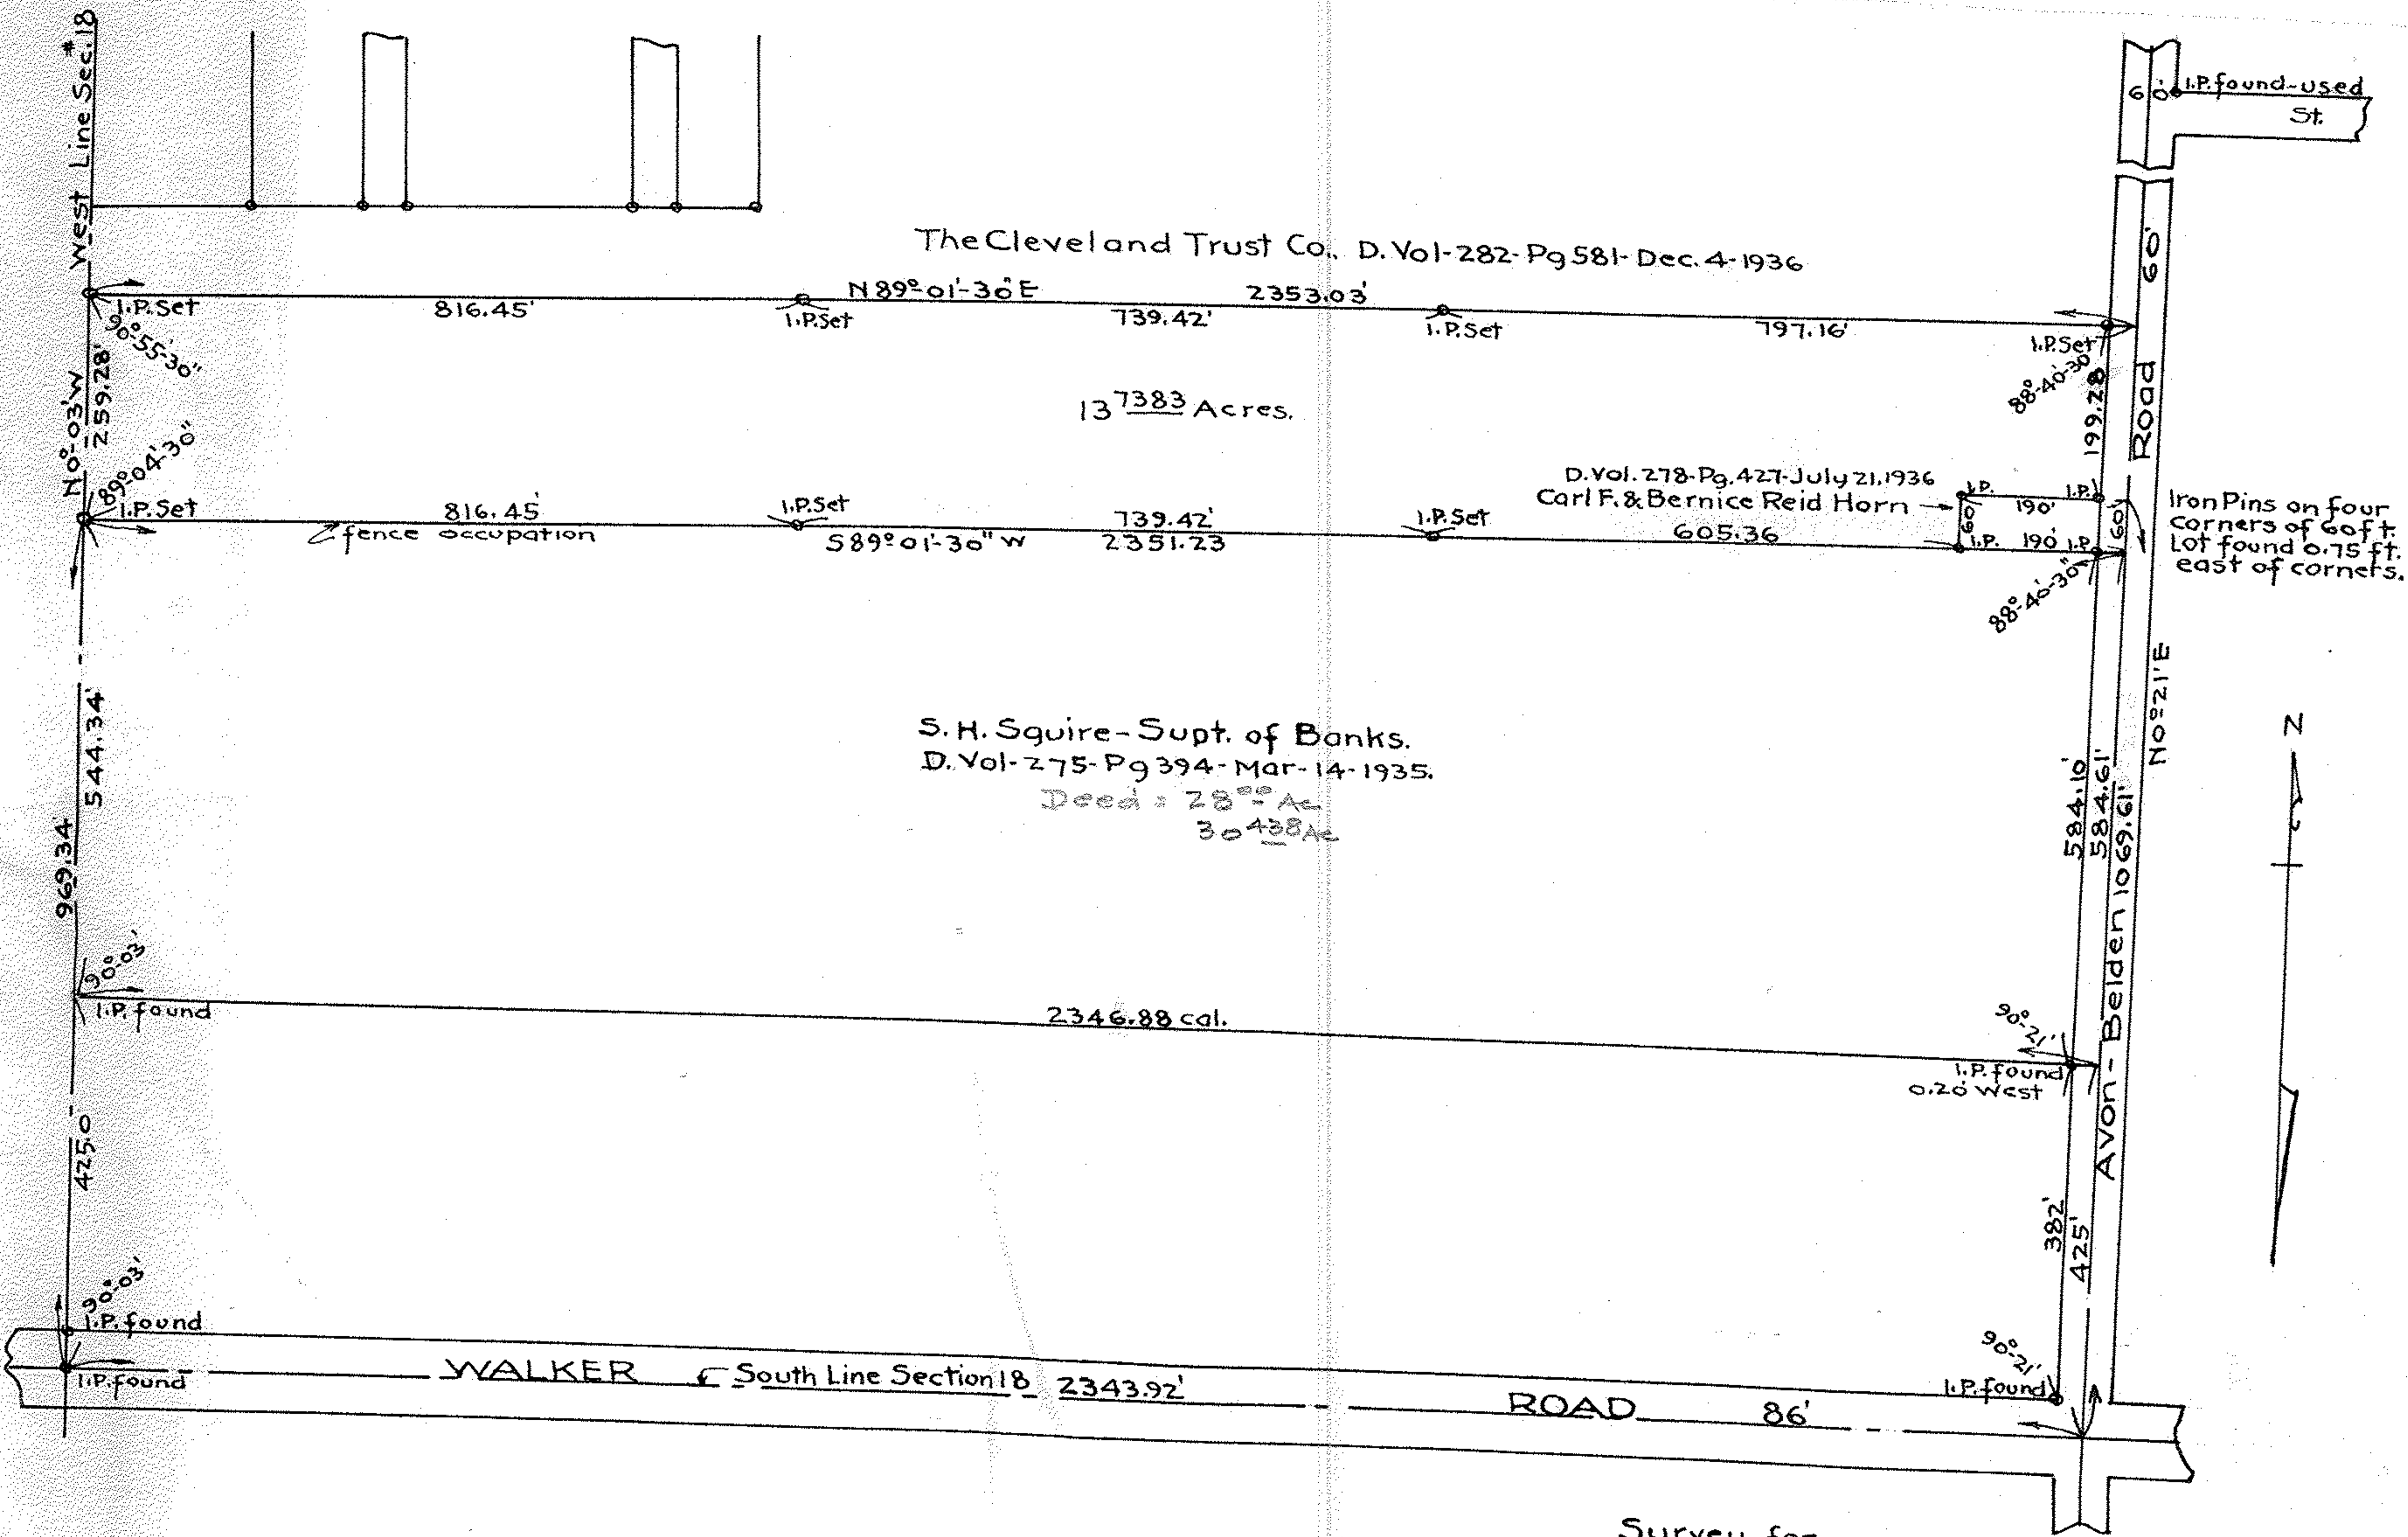

300754

Survey for  
Glenn C. Watkins.  
Section 18. fmlly Avon Township,  
Avon Lake Village - Lorain Co., O.  
Dec. 21, 1937. Scale 1" = 200ft.  
J. W. Warden - Registered Surveyor.