

J. W. WARDEN & ASSOCIATES

STATE OF OHIO

CIVIL ENGINEERS AND SURVEYORS

REGISTERED { PROFESSIONAL ENG.
SURVEYOR

D. D. ANDRUS, PRESIDENT
405 ELYRIA BLOCK
ELYRIA, OHIO


TELEPHONES FA 2-9828

FA 2-1466

M. W. JACKSON
SECRETARY

PPN 07-00-028-102-045

MAP Pg 07-00-028-D

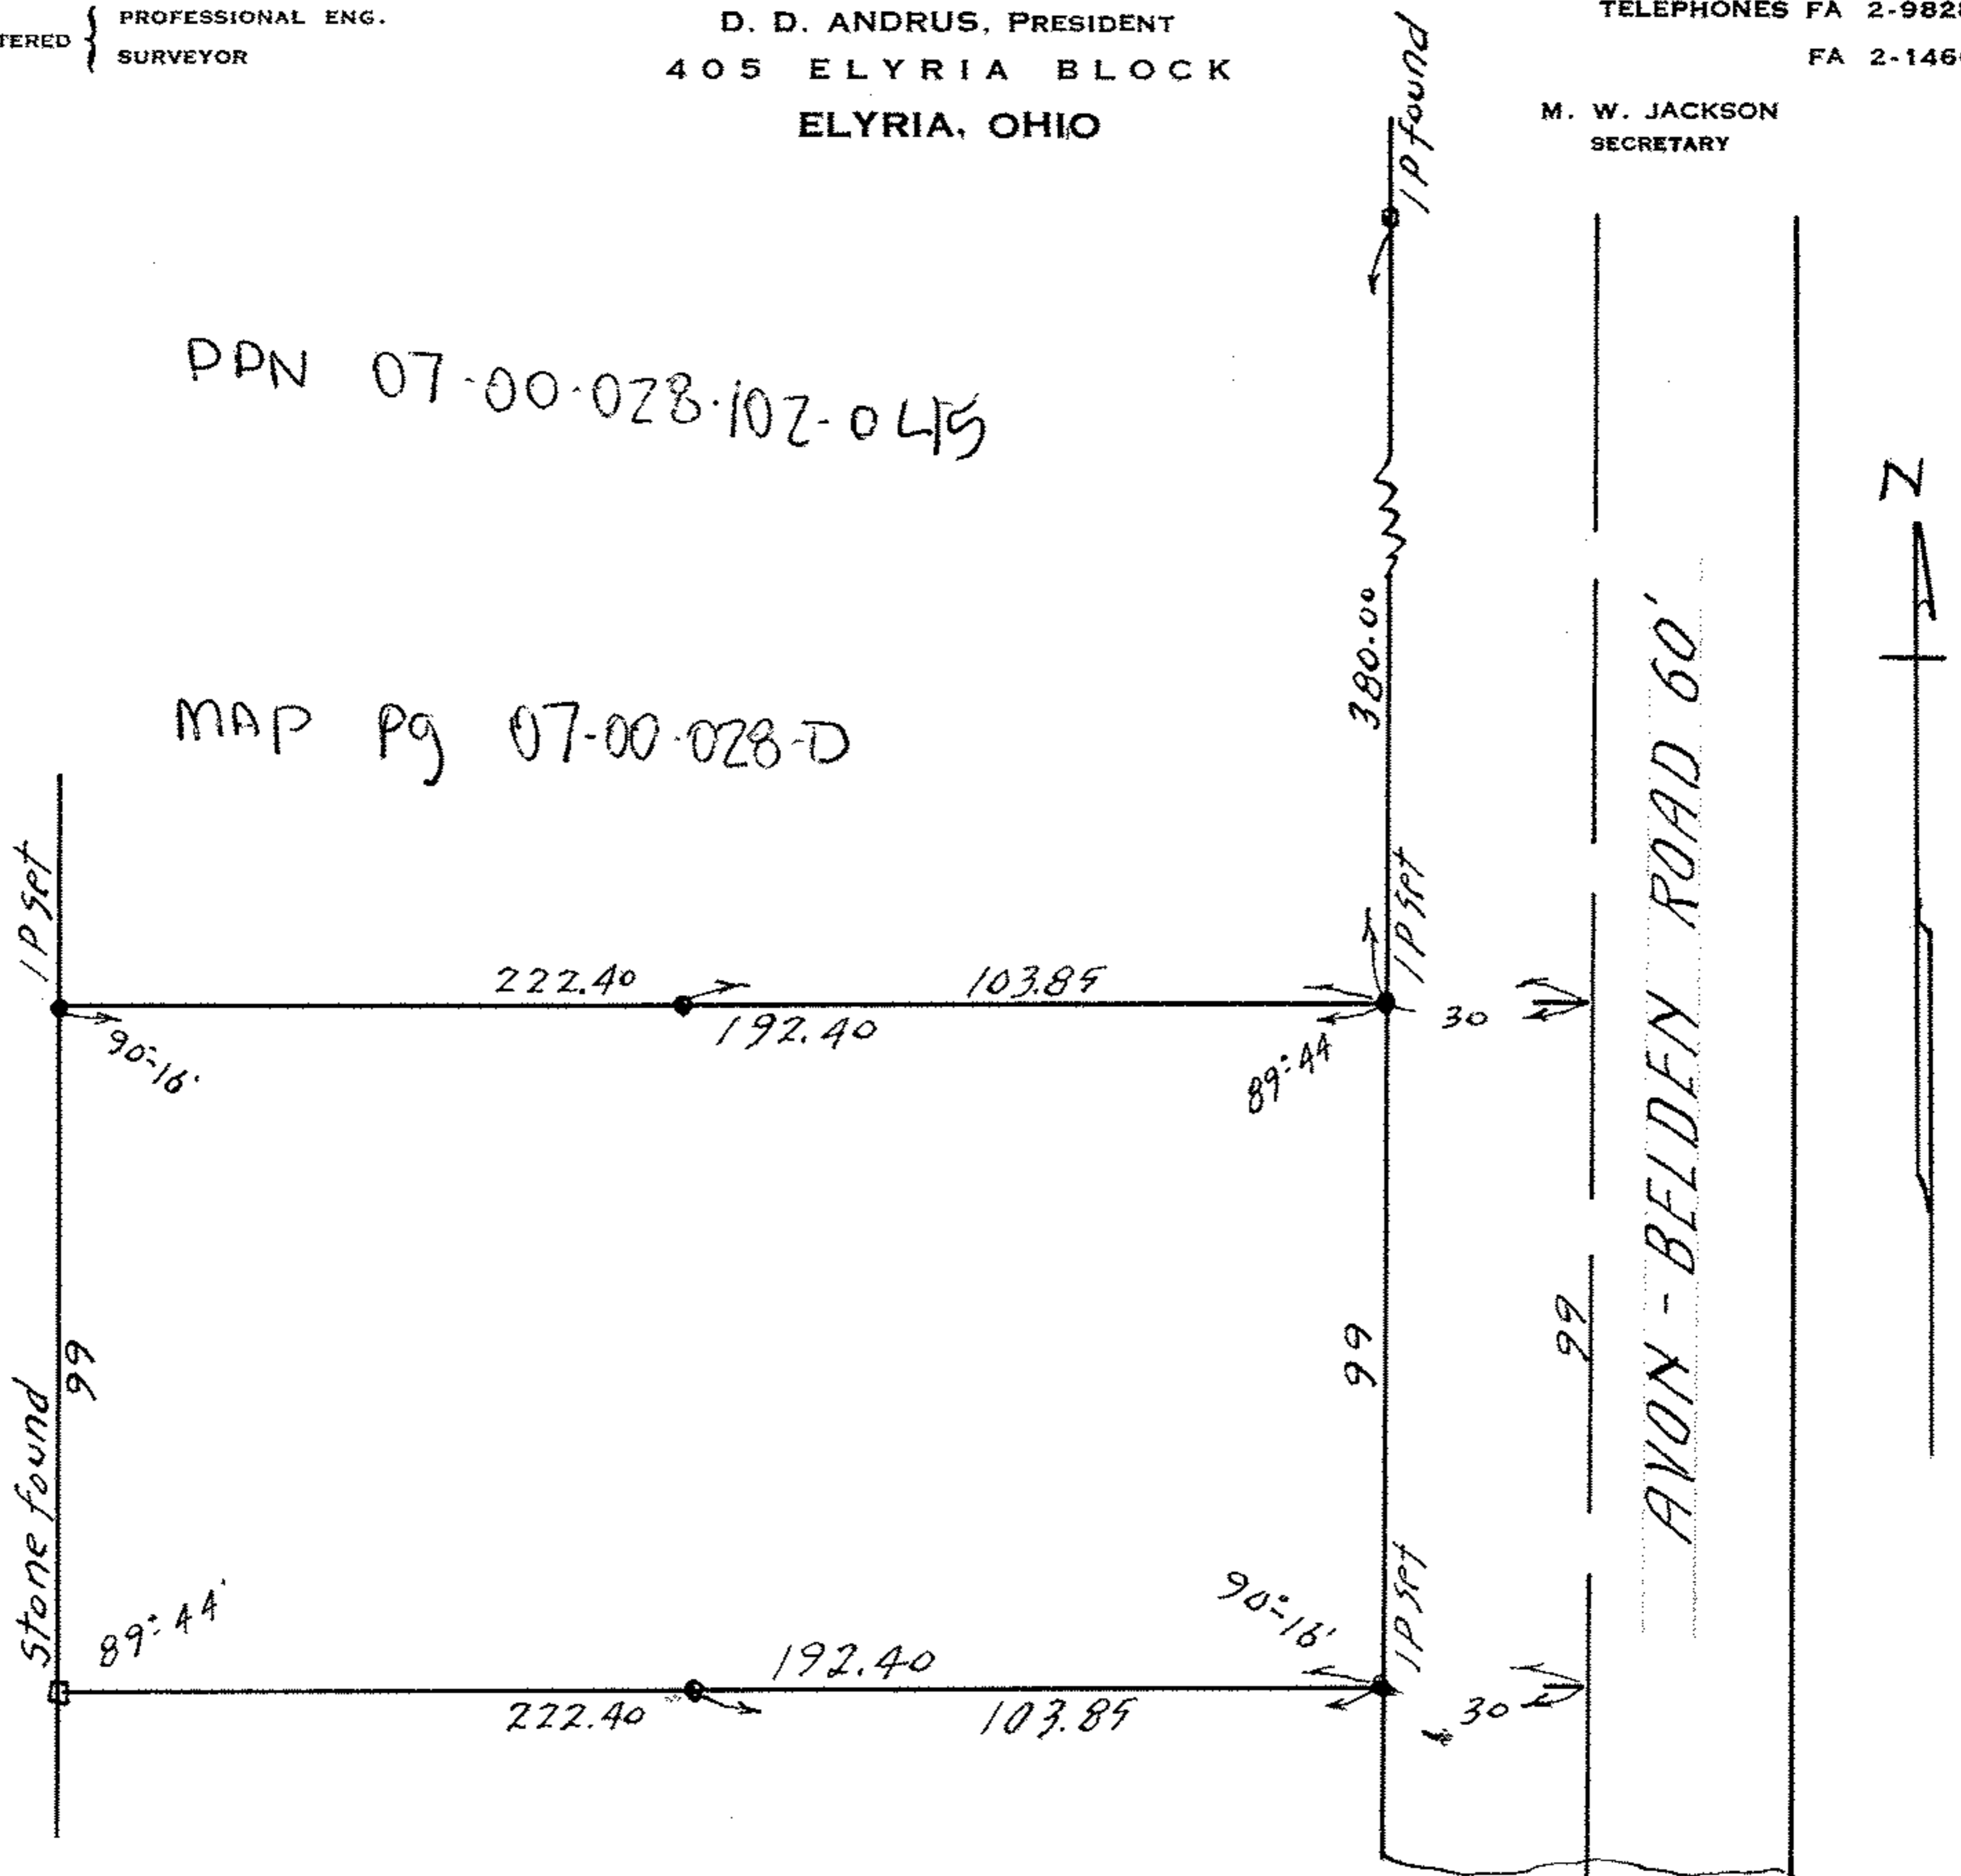

SURVEY FOR
MIRIAN E. & JOHN HERR
D-VOL 534 Pg 391 NOV. 16, 1951
LOT 28 RIDGEVILLE TWP.
N. RIDGEVILLE CITY LORAIN CO. OHIO
SCALE 1" = 40'

300376. A