


Survey for
 Elizabeth Gaal
 Lot 32- Grafton Twp.,
 Lorain Co., Ohio.
 July 29, 1937. Scale 1" = 200ft.
 J. W. Warden - Registered Surveyor.
 Revised Apr. 25, 1940.

North line lot 32

Mary Killup

Edward M. Deimling - D. Vol. 275 - Pg. 98 - Feb. 25, 1935

Edward J. Deimling - D. Vol. 275 - Pg. 98 - Feb. 25, 1935

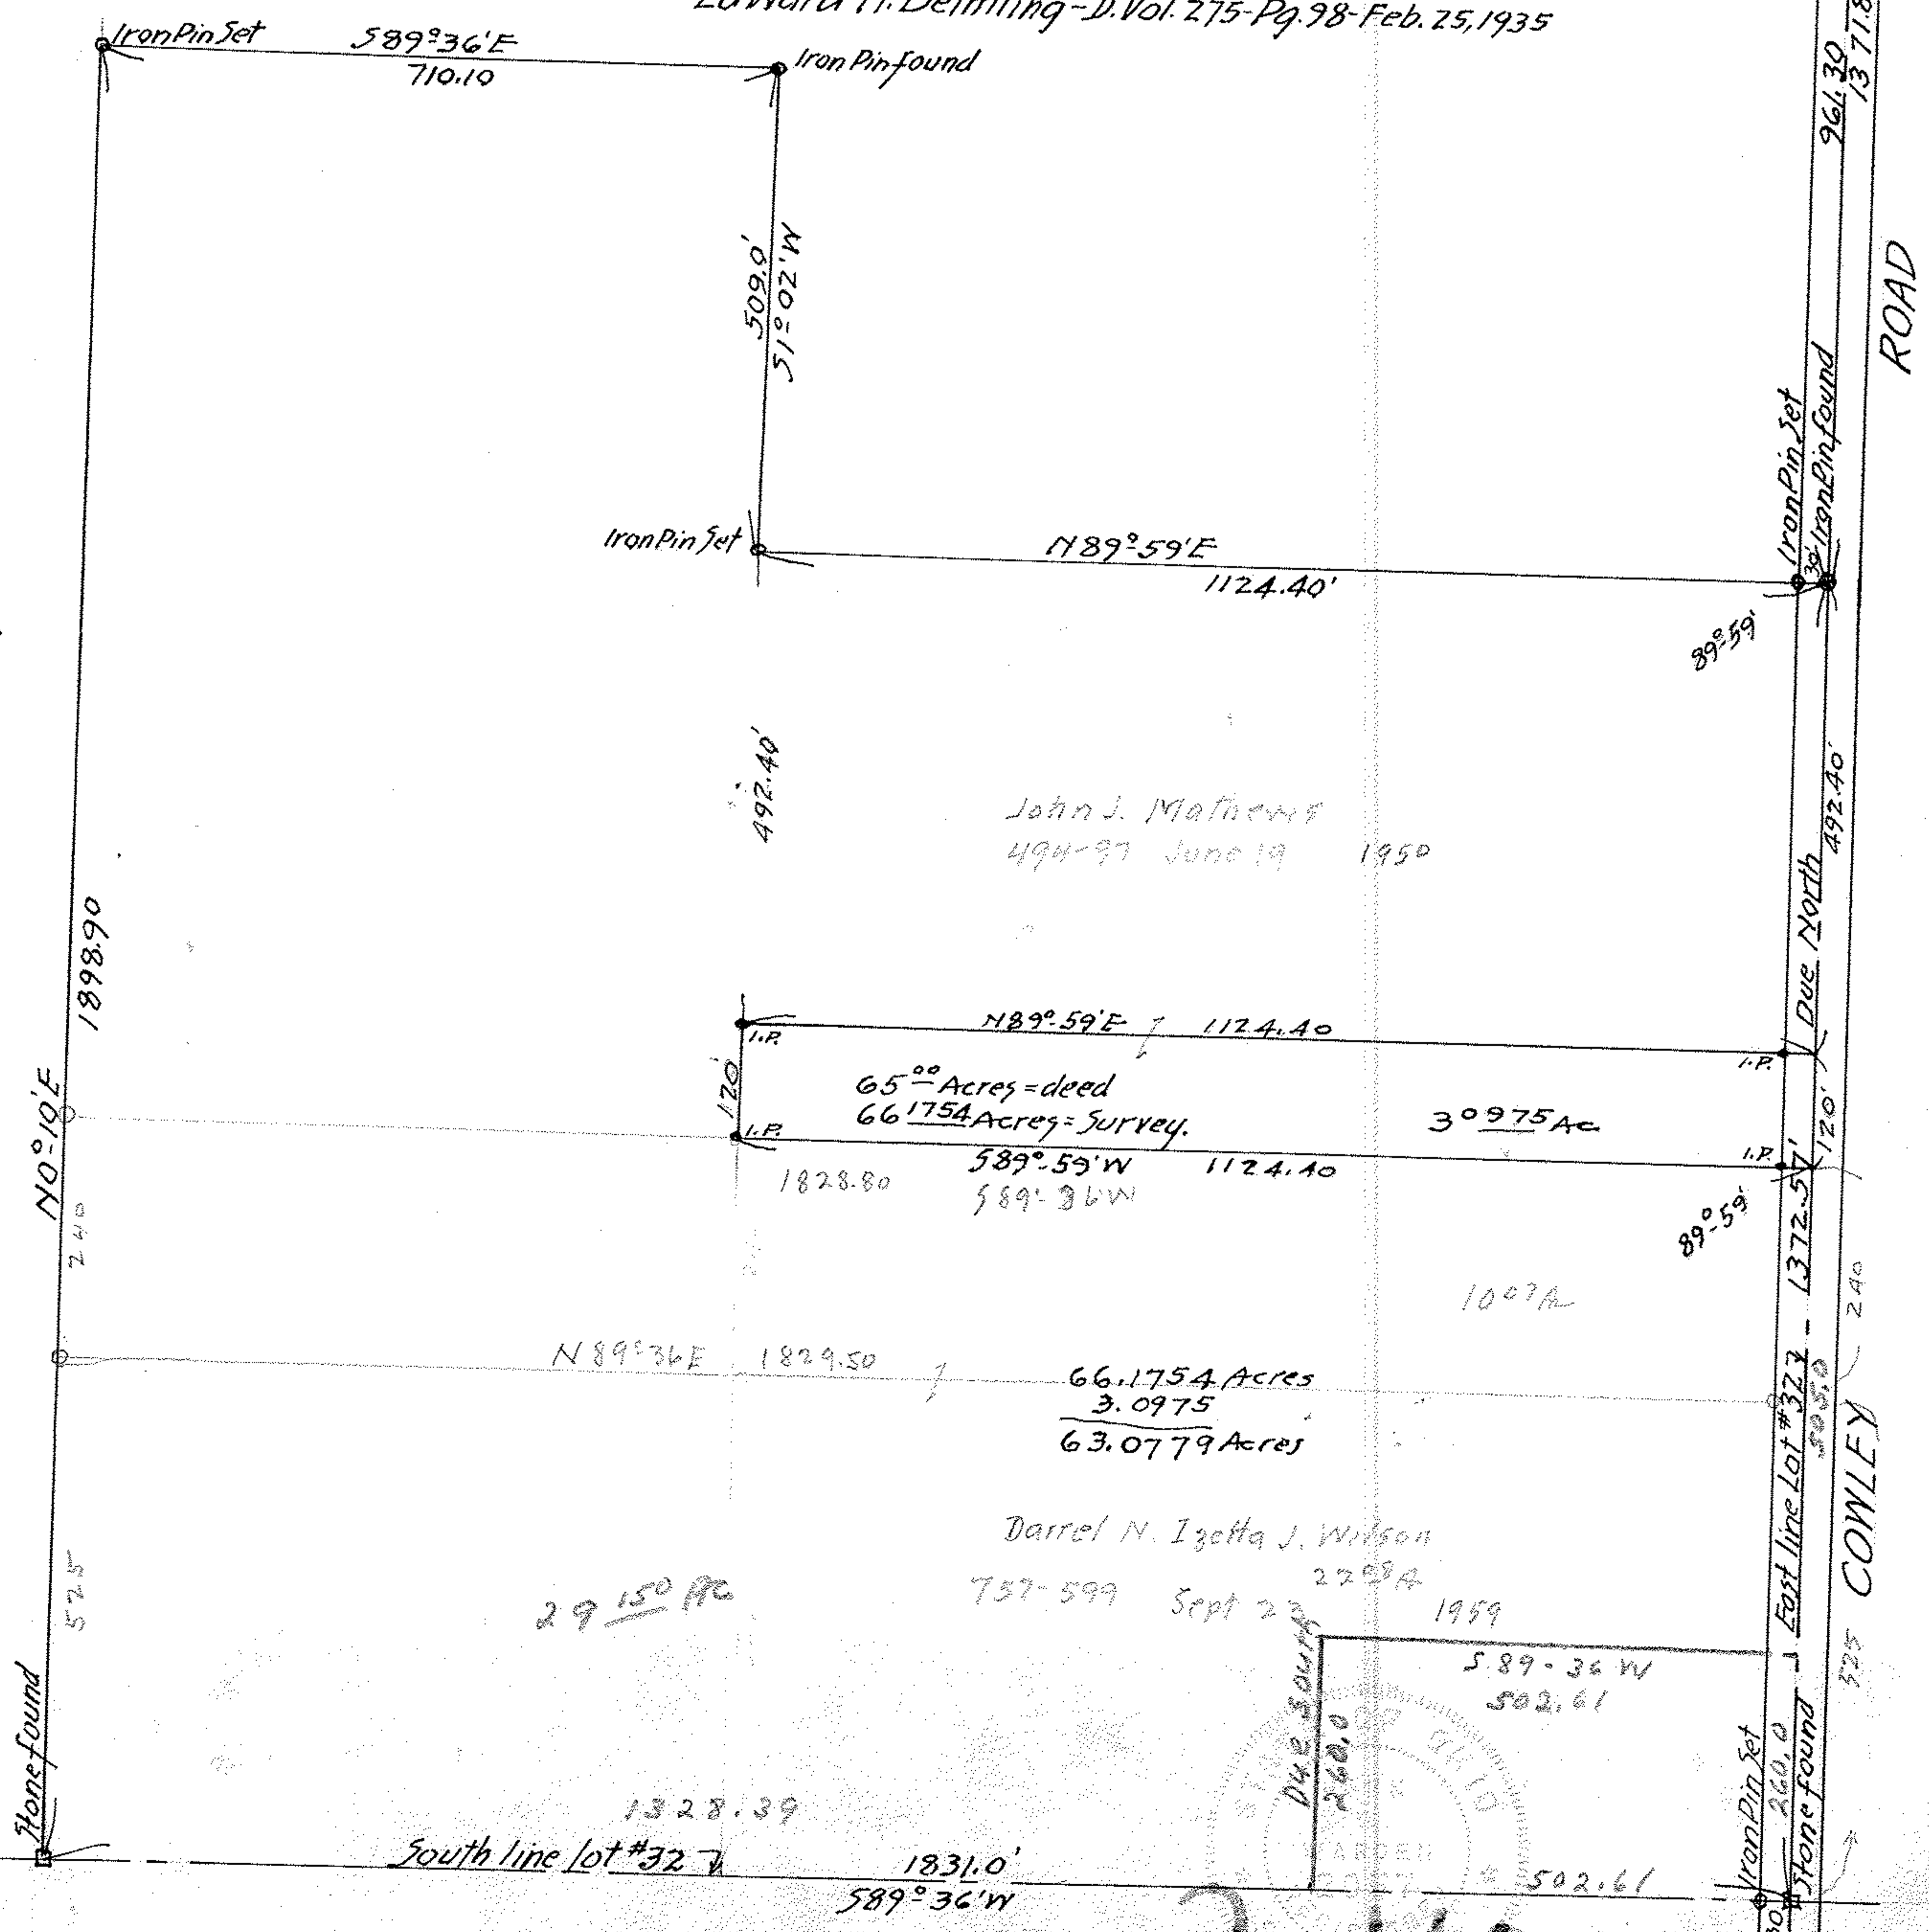

John J. Mathews
 494-27 June 19 1950

65.00 Acres = deed
 66.1754 Acres = Survey.

66.1754 Acres
 3.0975
 63.0779 Acres

Darrel N. Izetta J. Wilson
 757-599 Sept 27 1959

Survey by A. W. Nettleton

300743

3-113