


**JOHN W. WARDEN**  
 CIVIL ENGINEER AND SURVEYOR  
 405 ELYRIA BLOCK  
 ELYRIA, OHIO

STATE OF OHIO  
 REGISTERED } PROFESSIONAL ENG.  
 SURVEYOR

PHONES  
 BUSINESS 3211  
 RESIDENCE 38633

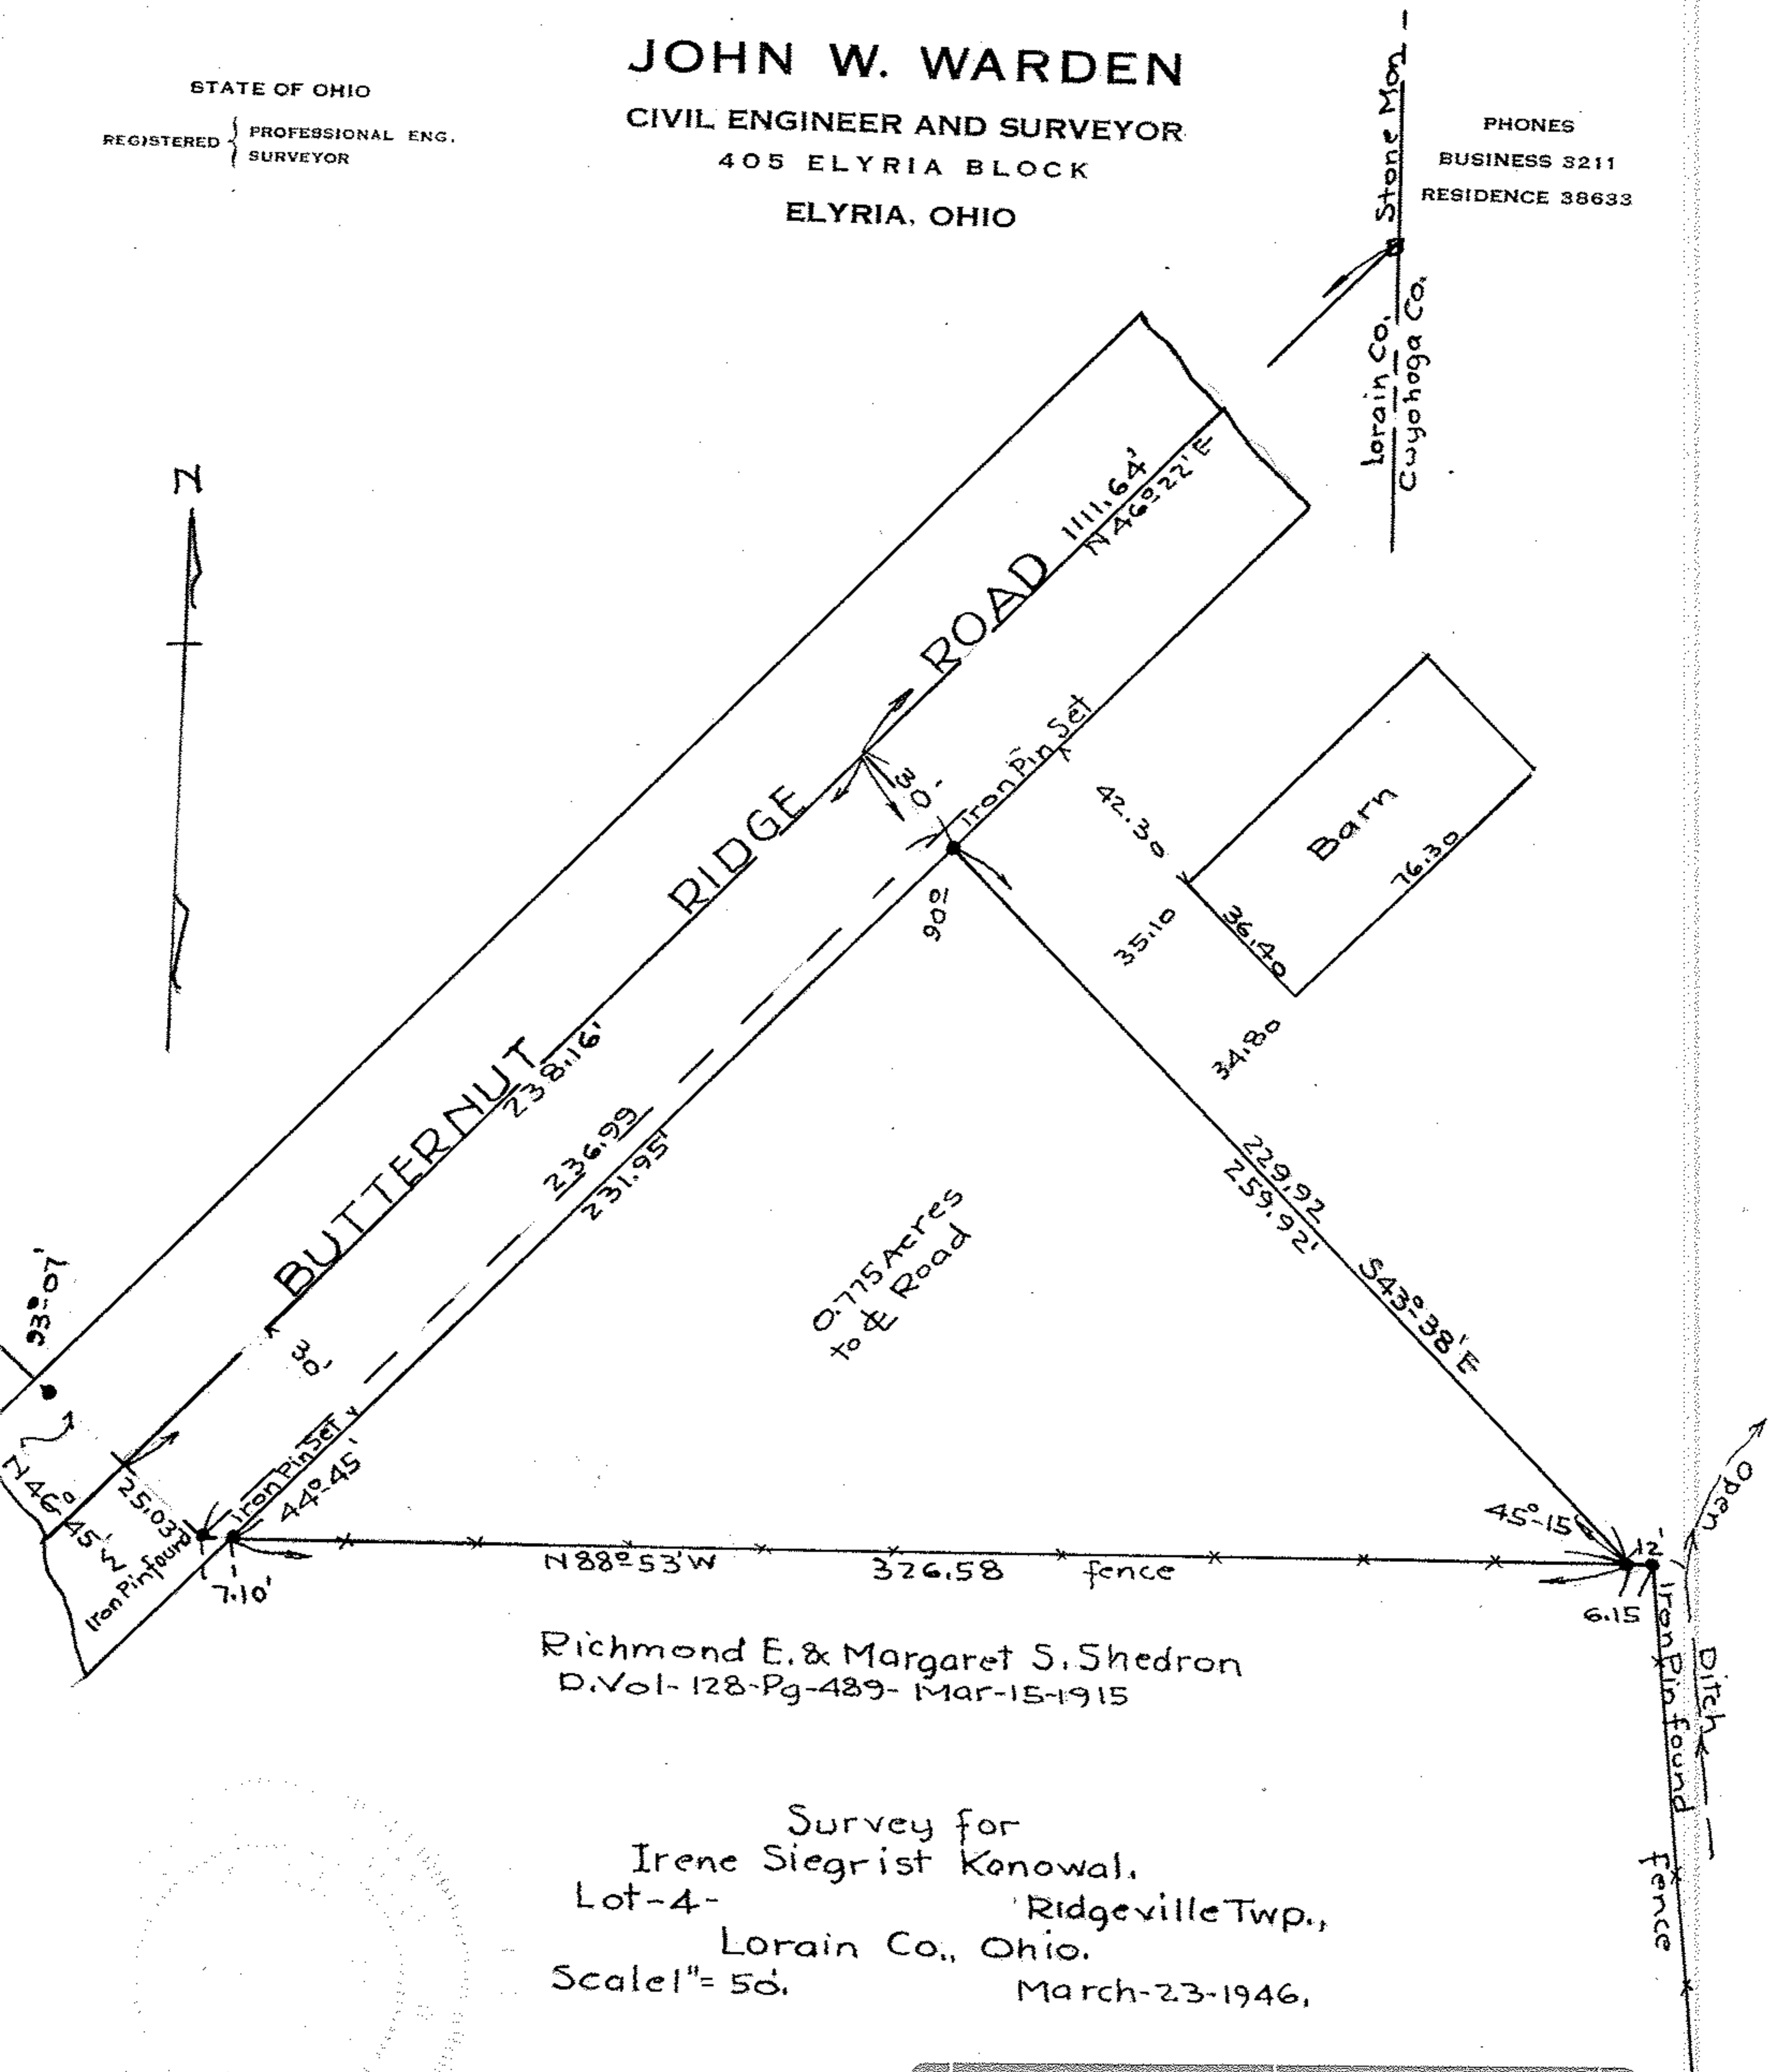

Richmond E. & Margaret S. Shedron  
 D. Vol-128-Pg-489- Mar-15-1915

Survey for  
 Irene Siegrist Kanowal,  
 Lot-4- Ridgeville Twp.,  
 Lorain Co., Ohio.  
 Scale"= 50'. March-23-1946,

300 348 C