


Earl LeRoy & Ruth E. Hartman
D-Vol. 376 Pg. 250 Nov. 15, 1945.

The Cleveland Trust Co.
D-Vol. 237 Pg. 383 May 15, 1928.
50:46'E

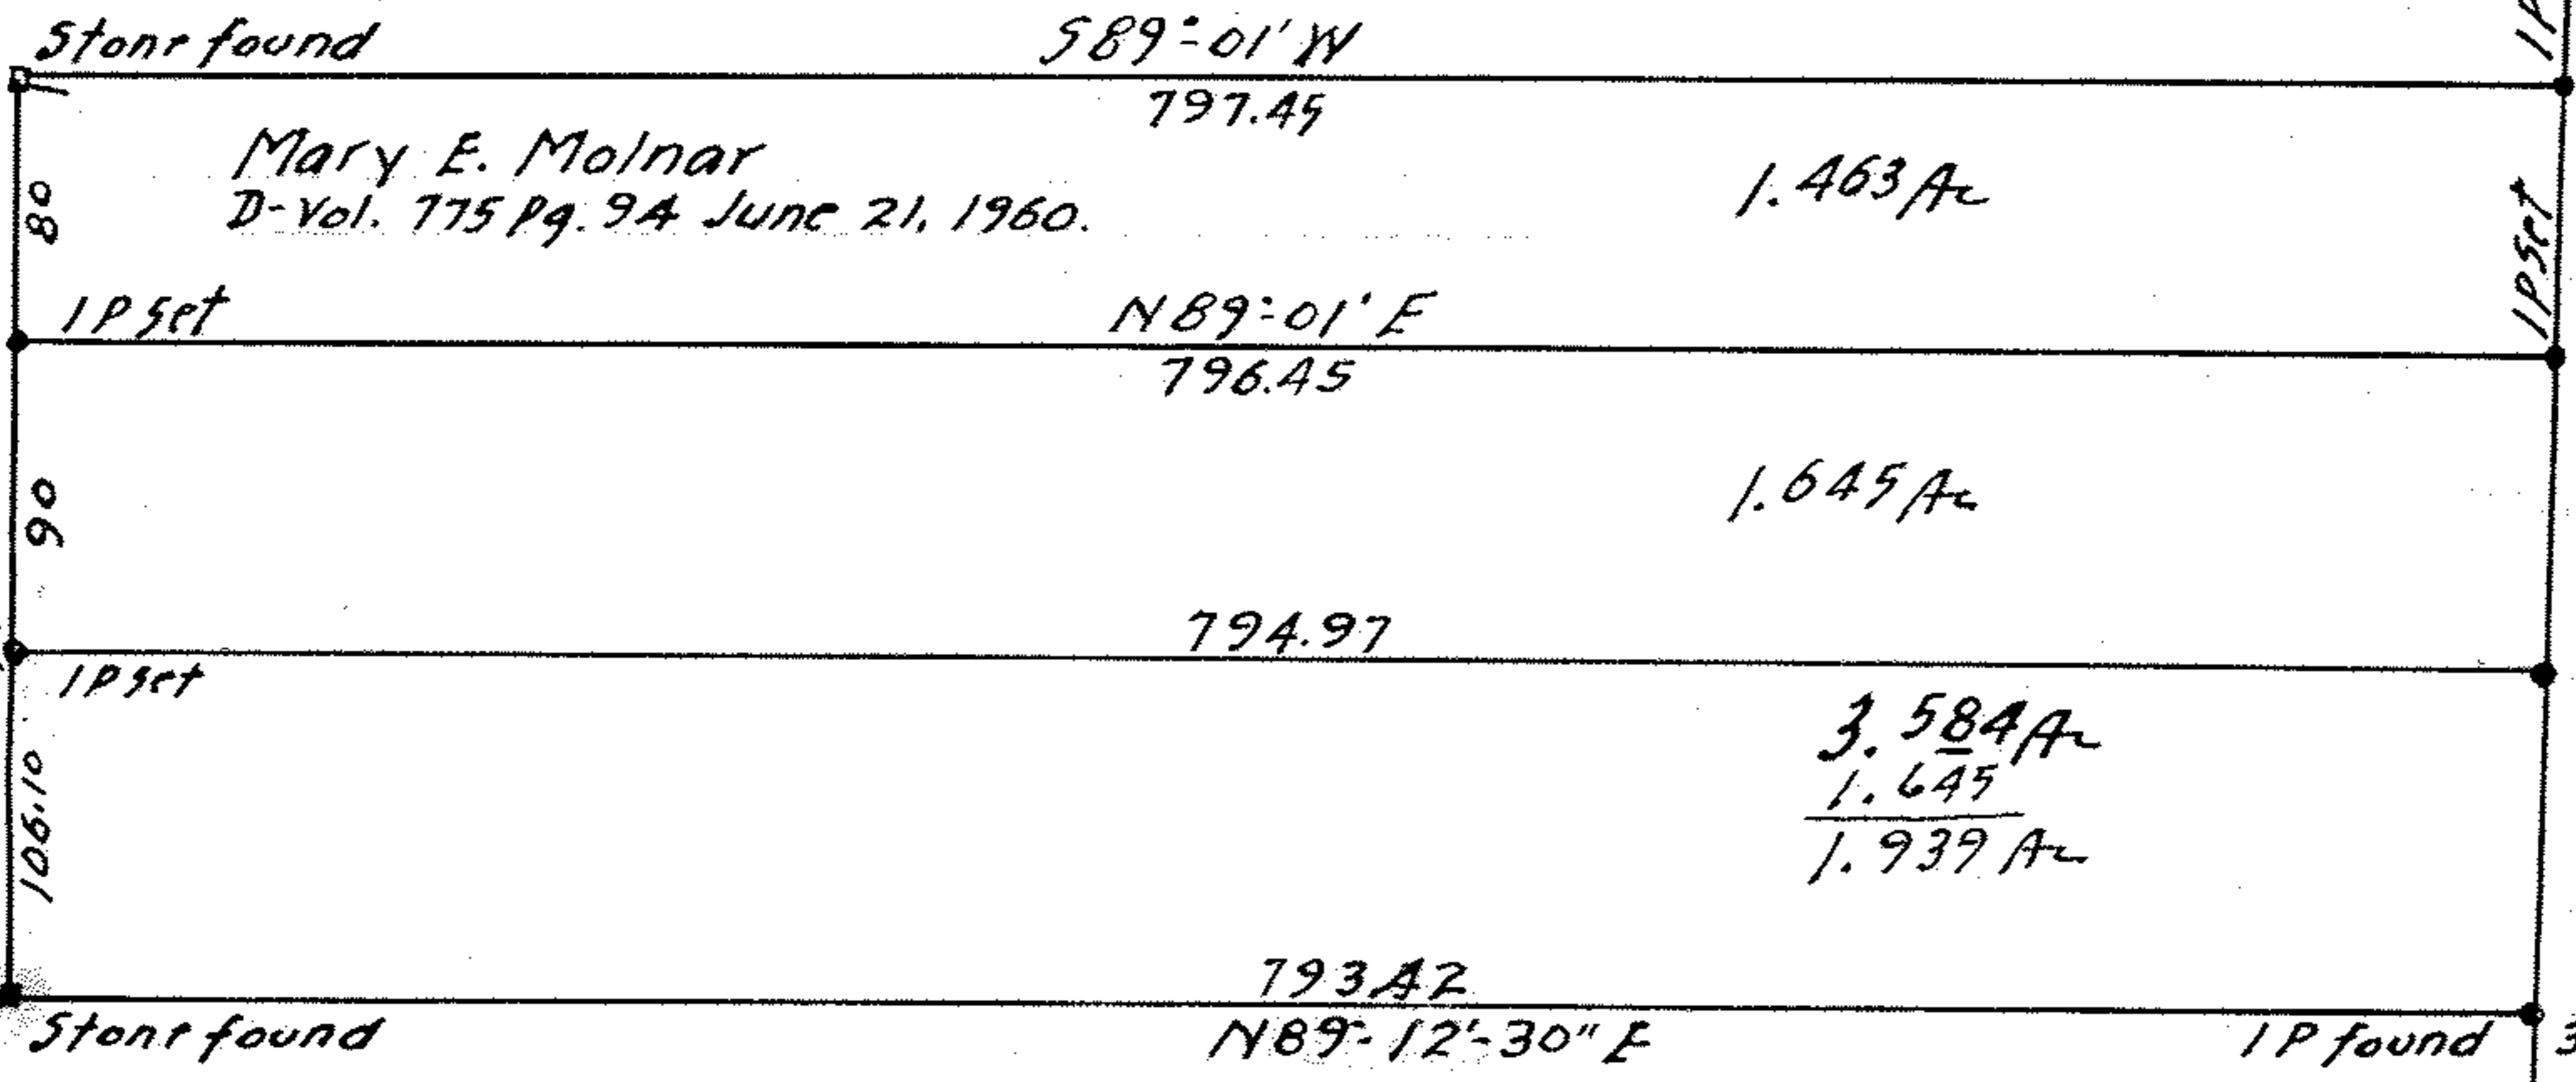

Mary E. Molnar
D-Vol. 775 Pg. 94 June 21, 1960.

1.463 Ac

1.645 Ac

3.584 Ac
1.645
1.939 Ac

Hermaine Spigle D-Vol. 313 Pg. 366 June 23, 1941.

300770 B

Survey for
MATILDA BILTZ
D-Vol. 137 Pg. 118 Aug. 5, 1915.
Section 18 Avon Lake Village.
Lorain County, Ohio.
Scale 1" = 100' March 10, 1954.
J. W. Warden, 9th Associates Reg. Surveyor's.
Revised Oct. 24, 1960. By D. D. Andrus.

MAP PG 04-00-018-F

PPN 04-00-018-128-012-2014