
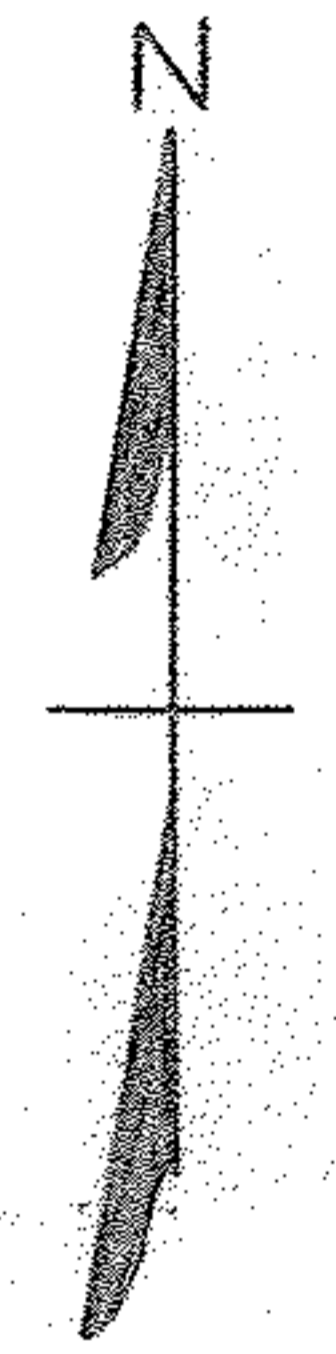


EATON TWP. I.P.F.D.  
 ORIG. LOT 7 GRAFTON TWP.

Paul Andrasek 75.9 Acres ± Total 70.0 Acres ± Remainder  
~~Faber & Victoria Mandeville 83.4 Acres ± Total~~

ORIG. LOT 6  
 ORIG. LOT 7

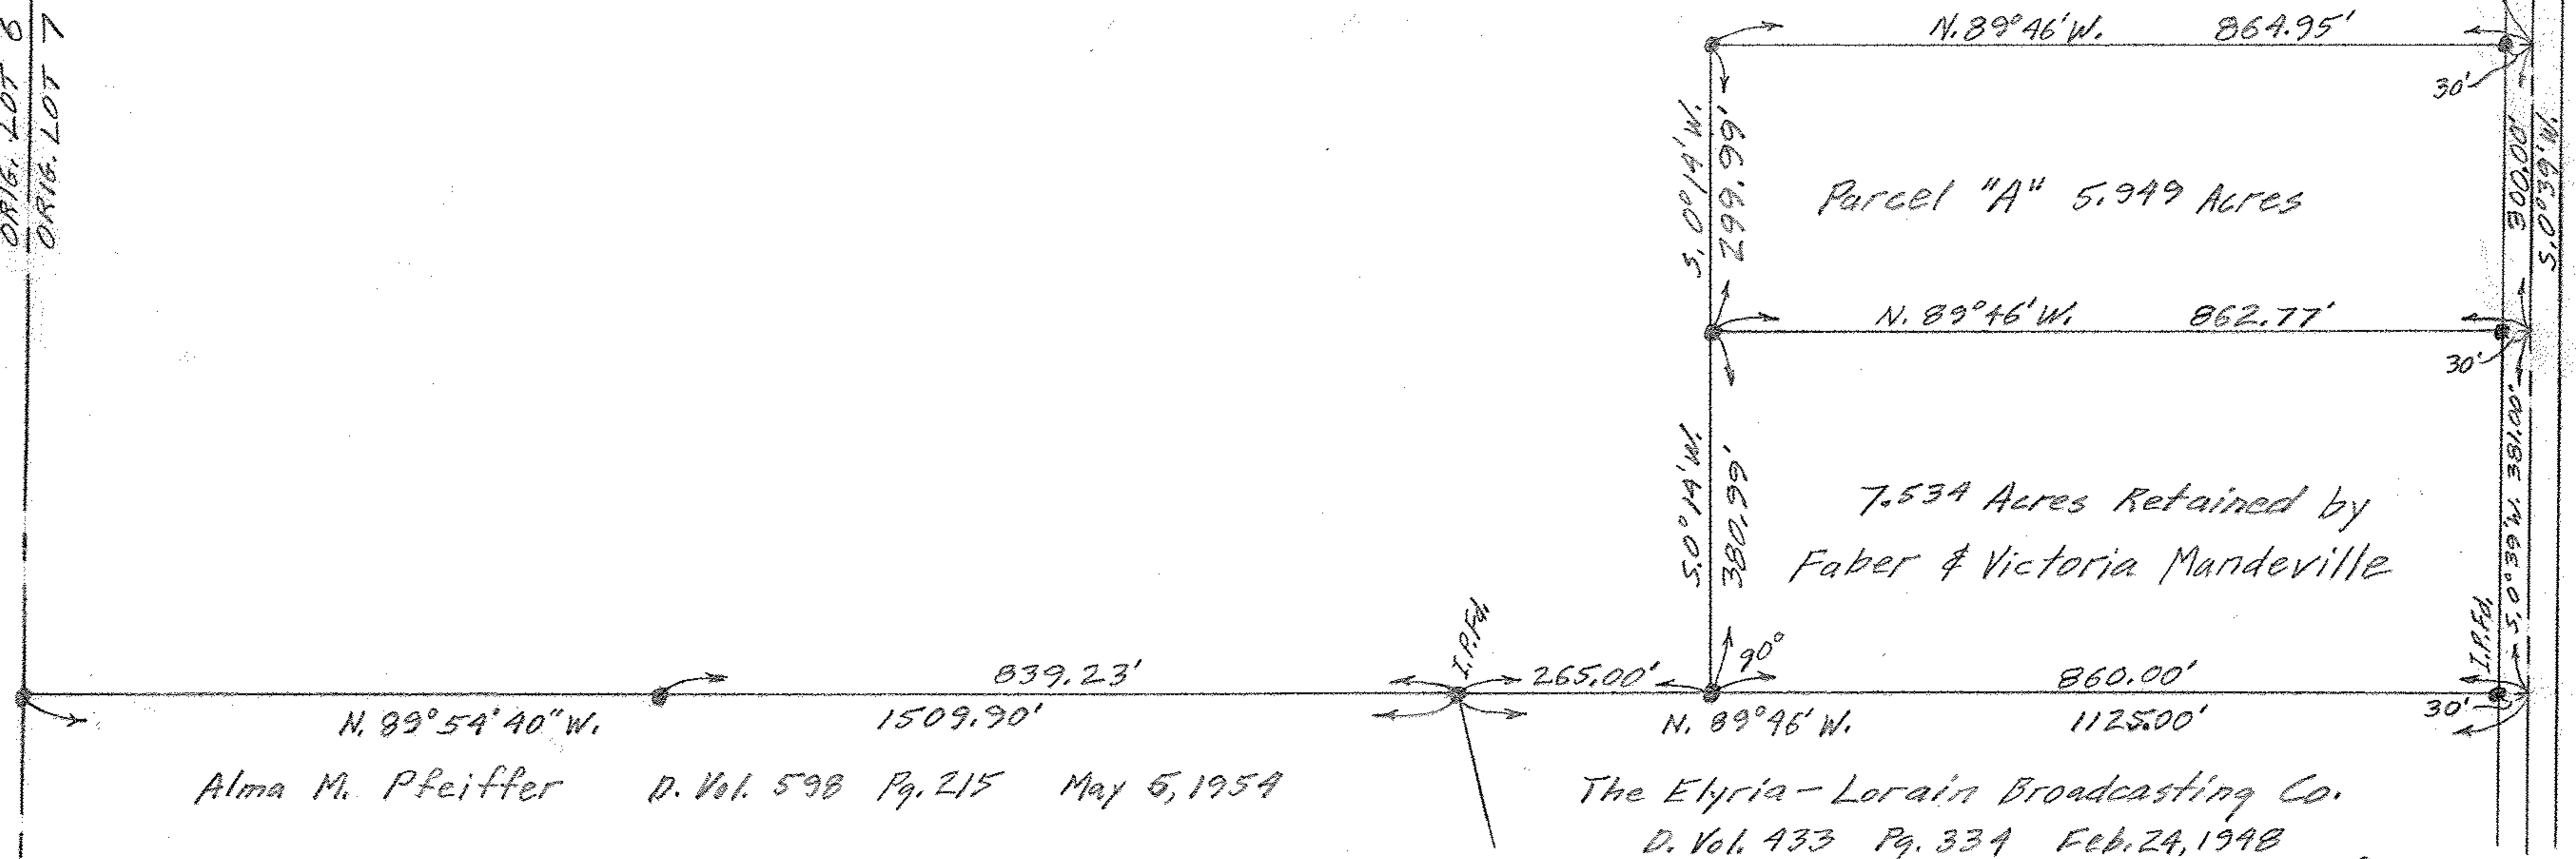

PLAT OF SURVEY FOR FABER MANDEVILLE  
 SOUTH & EAST LINES OF FARM IN SEPTEMBER OF 1957  
 7.534 ACRE PARCEL TO BE RETAINED ON OCTOBER 16, 1958

ORIGINAL LOT 7 GRAFTON TOWNSHIP  
 LORAIN COUNTY OHIO  
 PARCEL "A" SURVEYED FOR PAUL ANDRASEK ON FEBRUARY 26, 1959

SCALE: 1 Inch = 200 Feet. 16-00-007-000-005, -006, -009  
 • indicates iron pin set unless otherwise noted.

GARY E. PENFOUND REG. SURVEYOR NO. 4457