
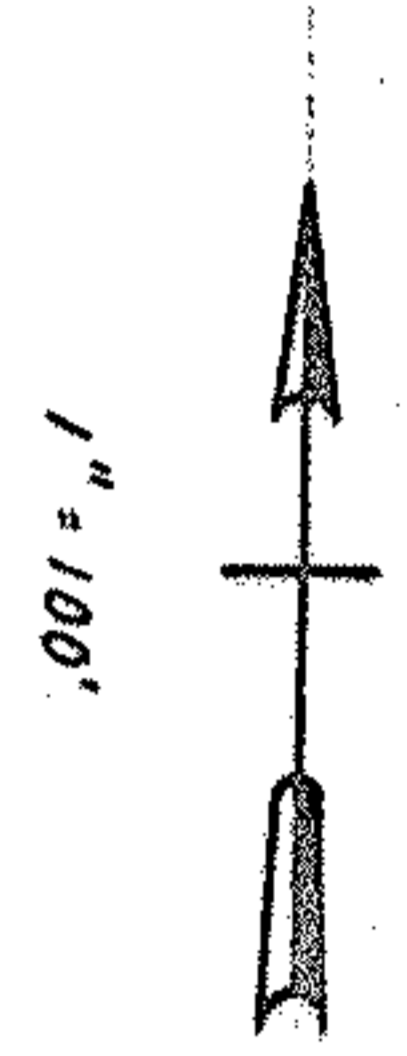


Fd Used
MON BOX
MOON RD

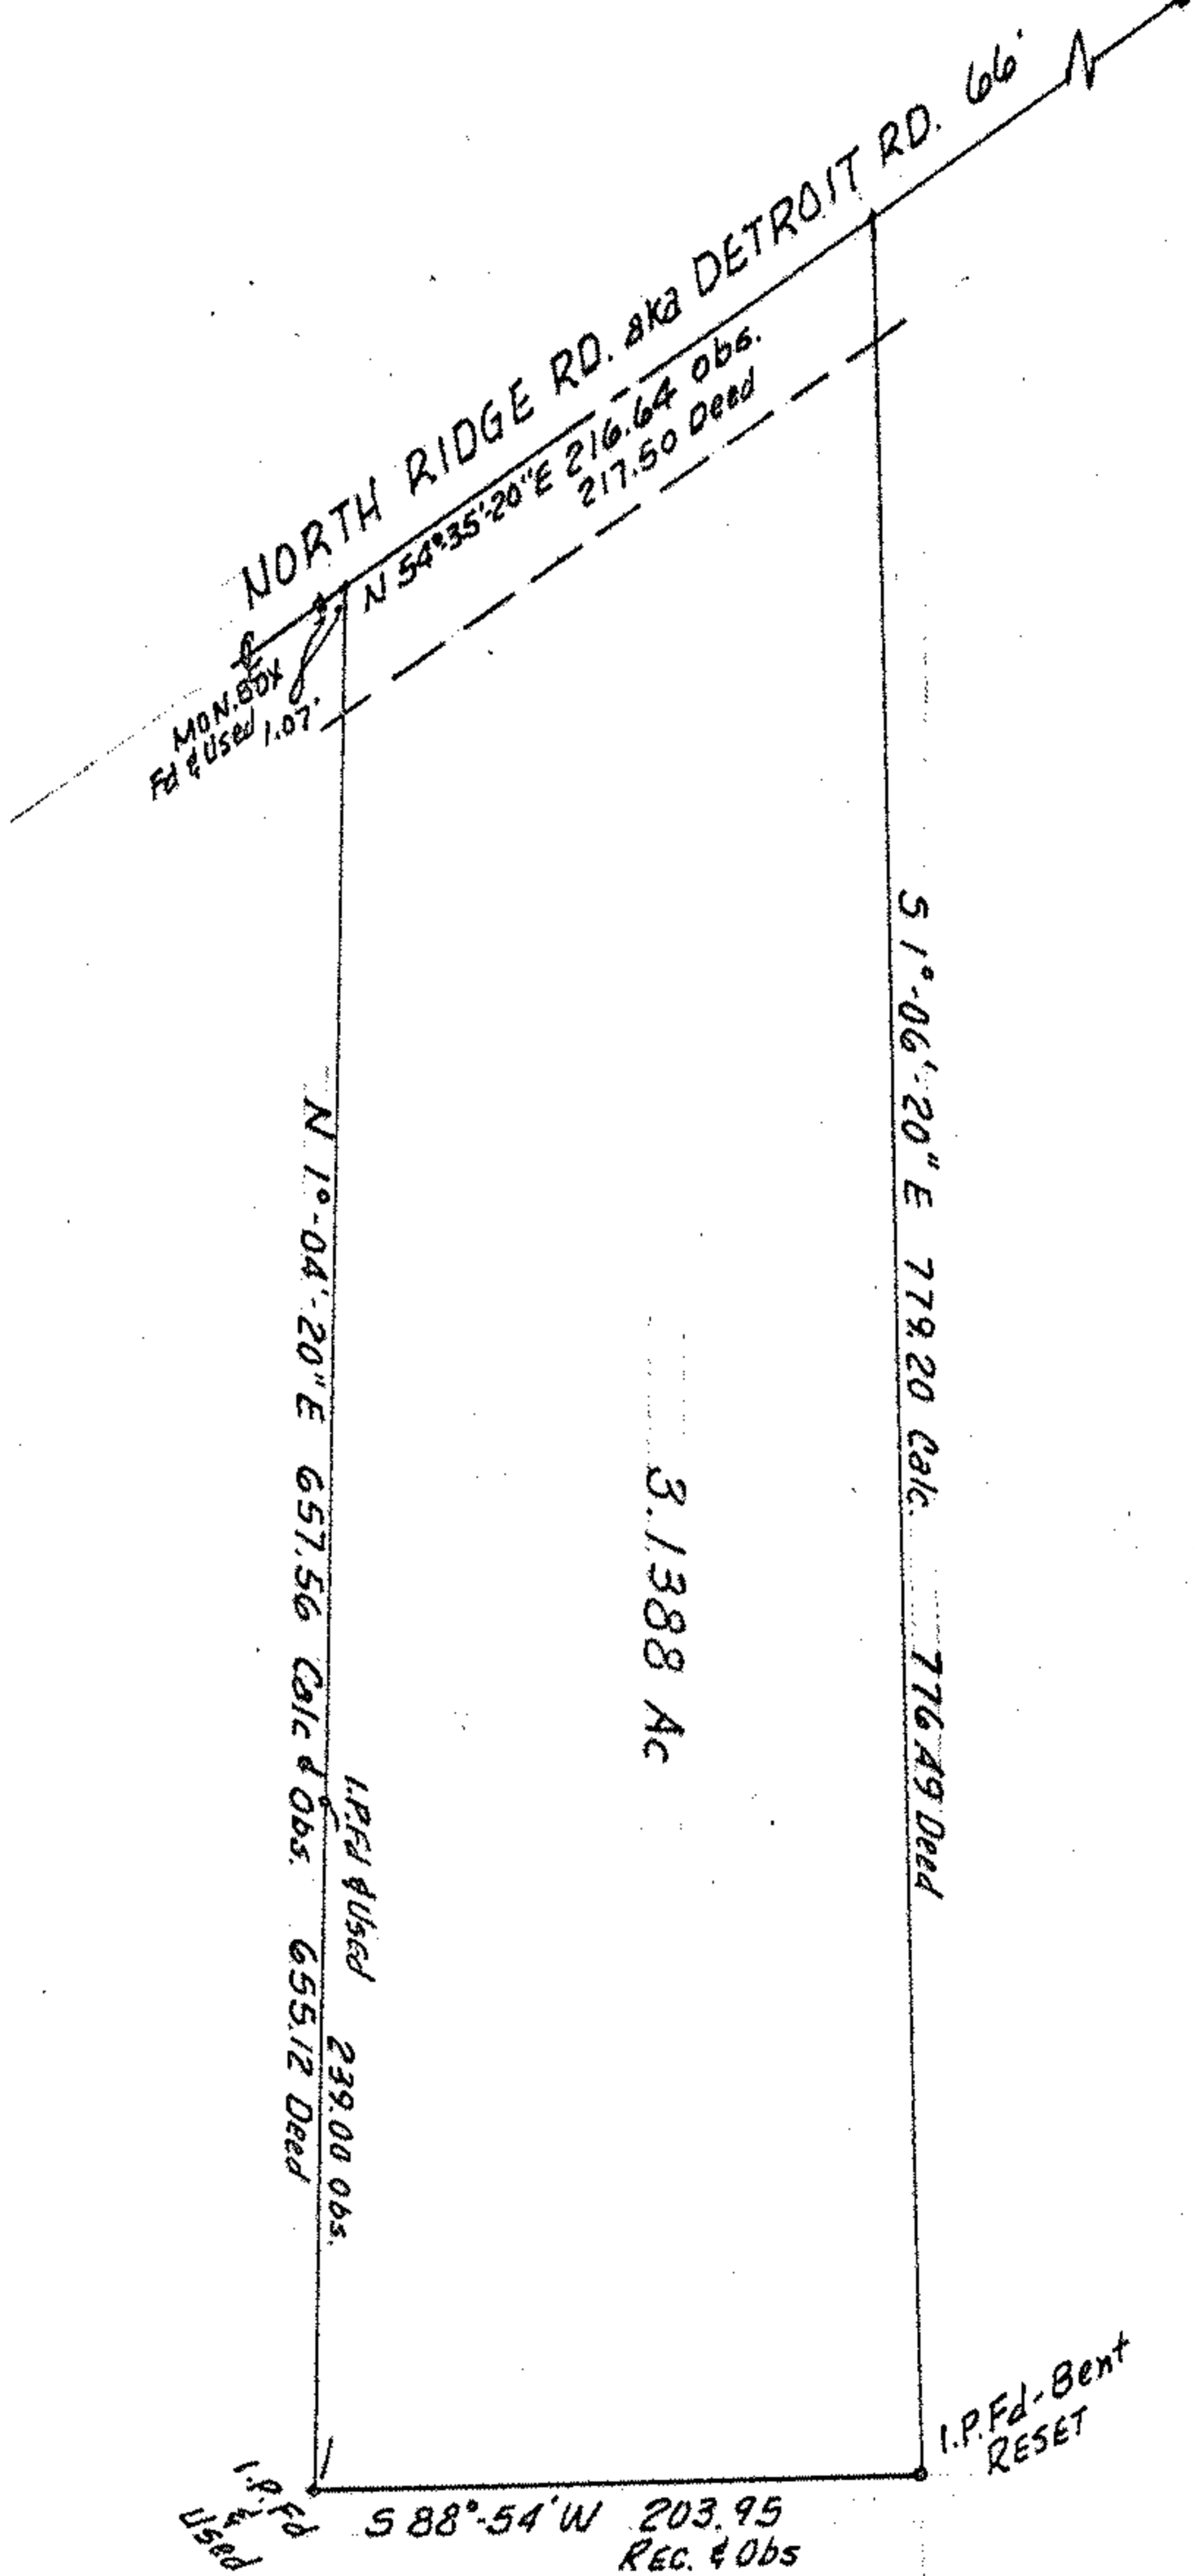

3.1388 Ac

PART OF ORIG. AVON TWP. SECTION 1
NOW IN CITY OF AVON, OHIO

THIS IS A PLAT OF SURVEY:

McGLINCHY & ASSOCIATES INC.

MARCH 1992

#827152

04-00-001-???