


1"=20'

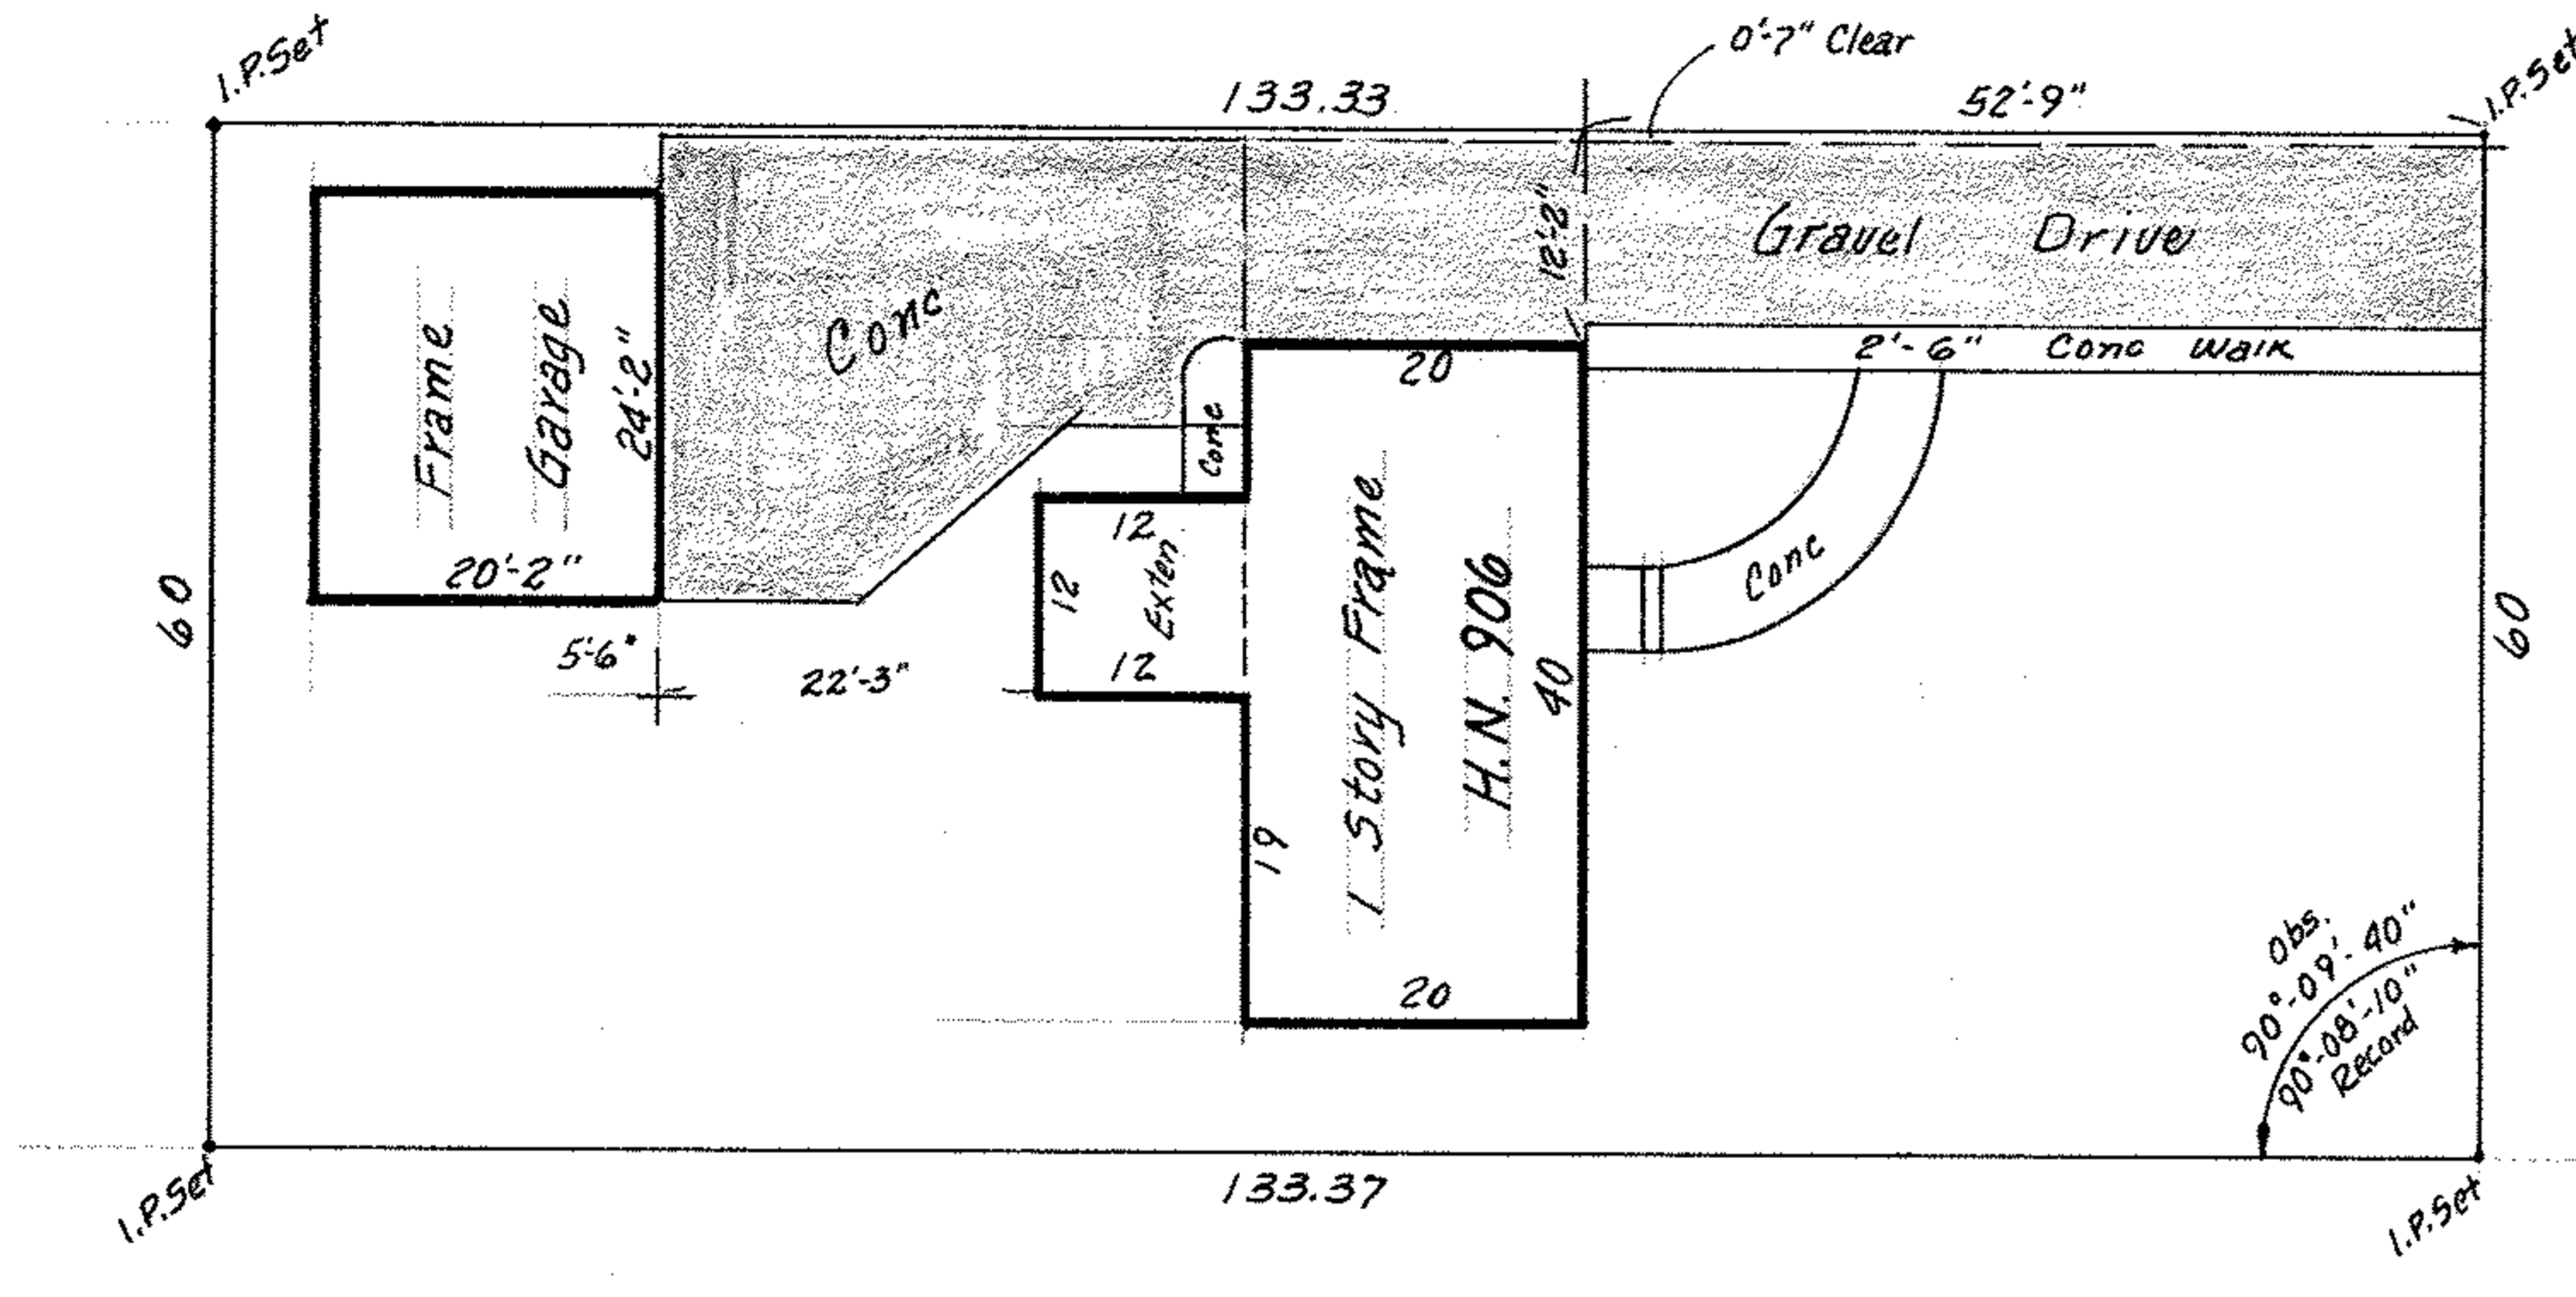

P.P. # 03-00-043-113-029  
 SUBLOT #152 of MAPLE GROVE SUBDIVISION

PLAT VOL. 17 PAGE 30  
 PART of ORIG. SHEFFIELD TWP. LOT 43  
 NOW in CITY of SHEFFIELD LAKE, OHIO

3-00-043

THIS IS A PLAT OF SURVEY:  
 FOR MORTGAGE LOAN PURPOSES ONLY

McGLINCHY & ASSOCIATES  
 OCT. 22, 1979 #795666