


02-02-025-114-039  
(02-02-025-114-039)

02-02-025-B

S-J-20

S-J-20

5-1-20

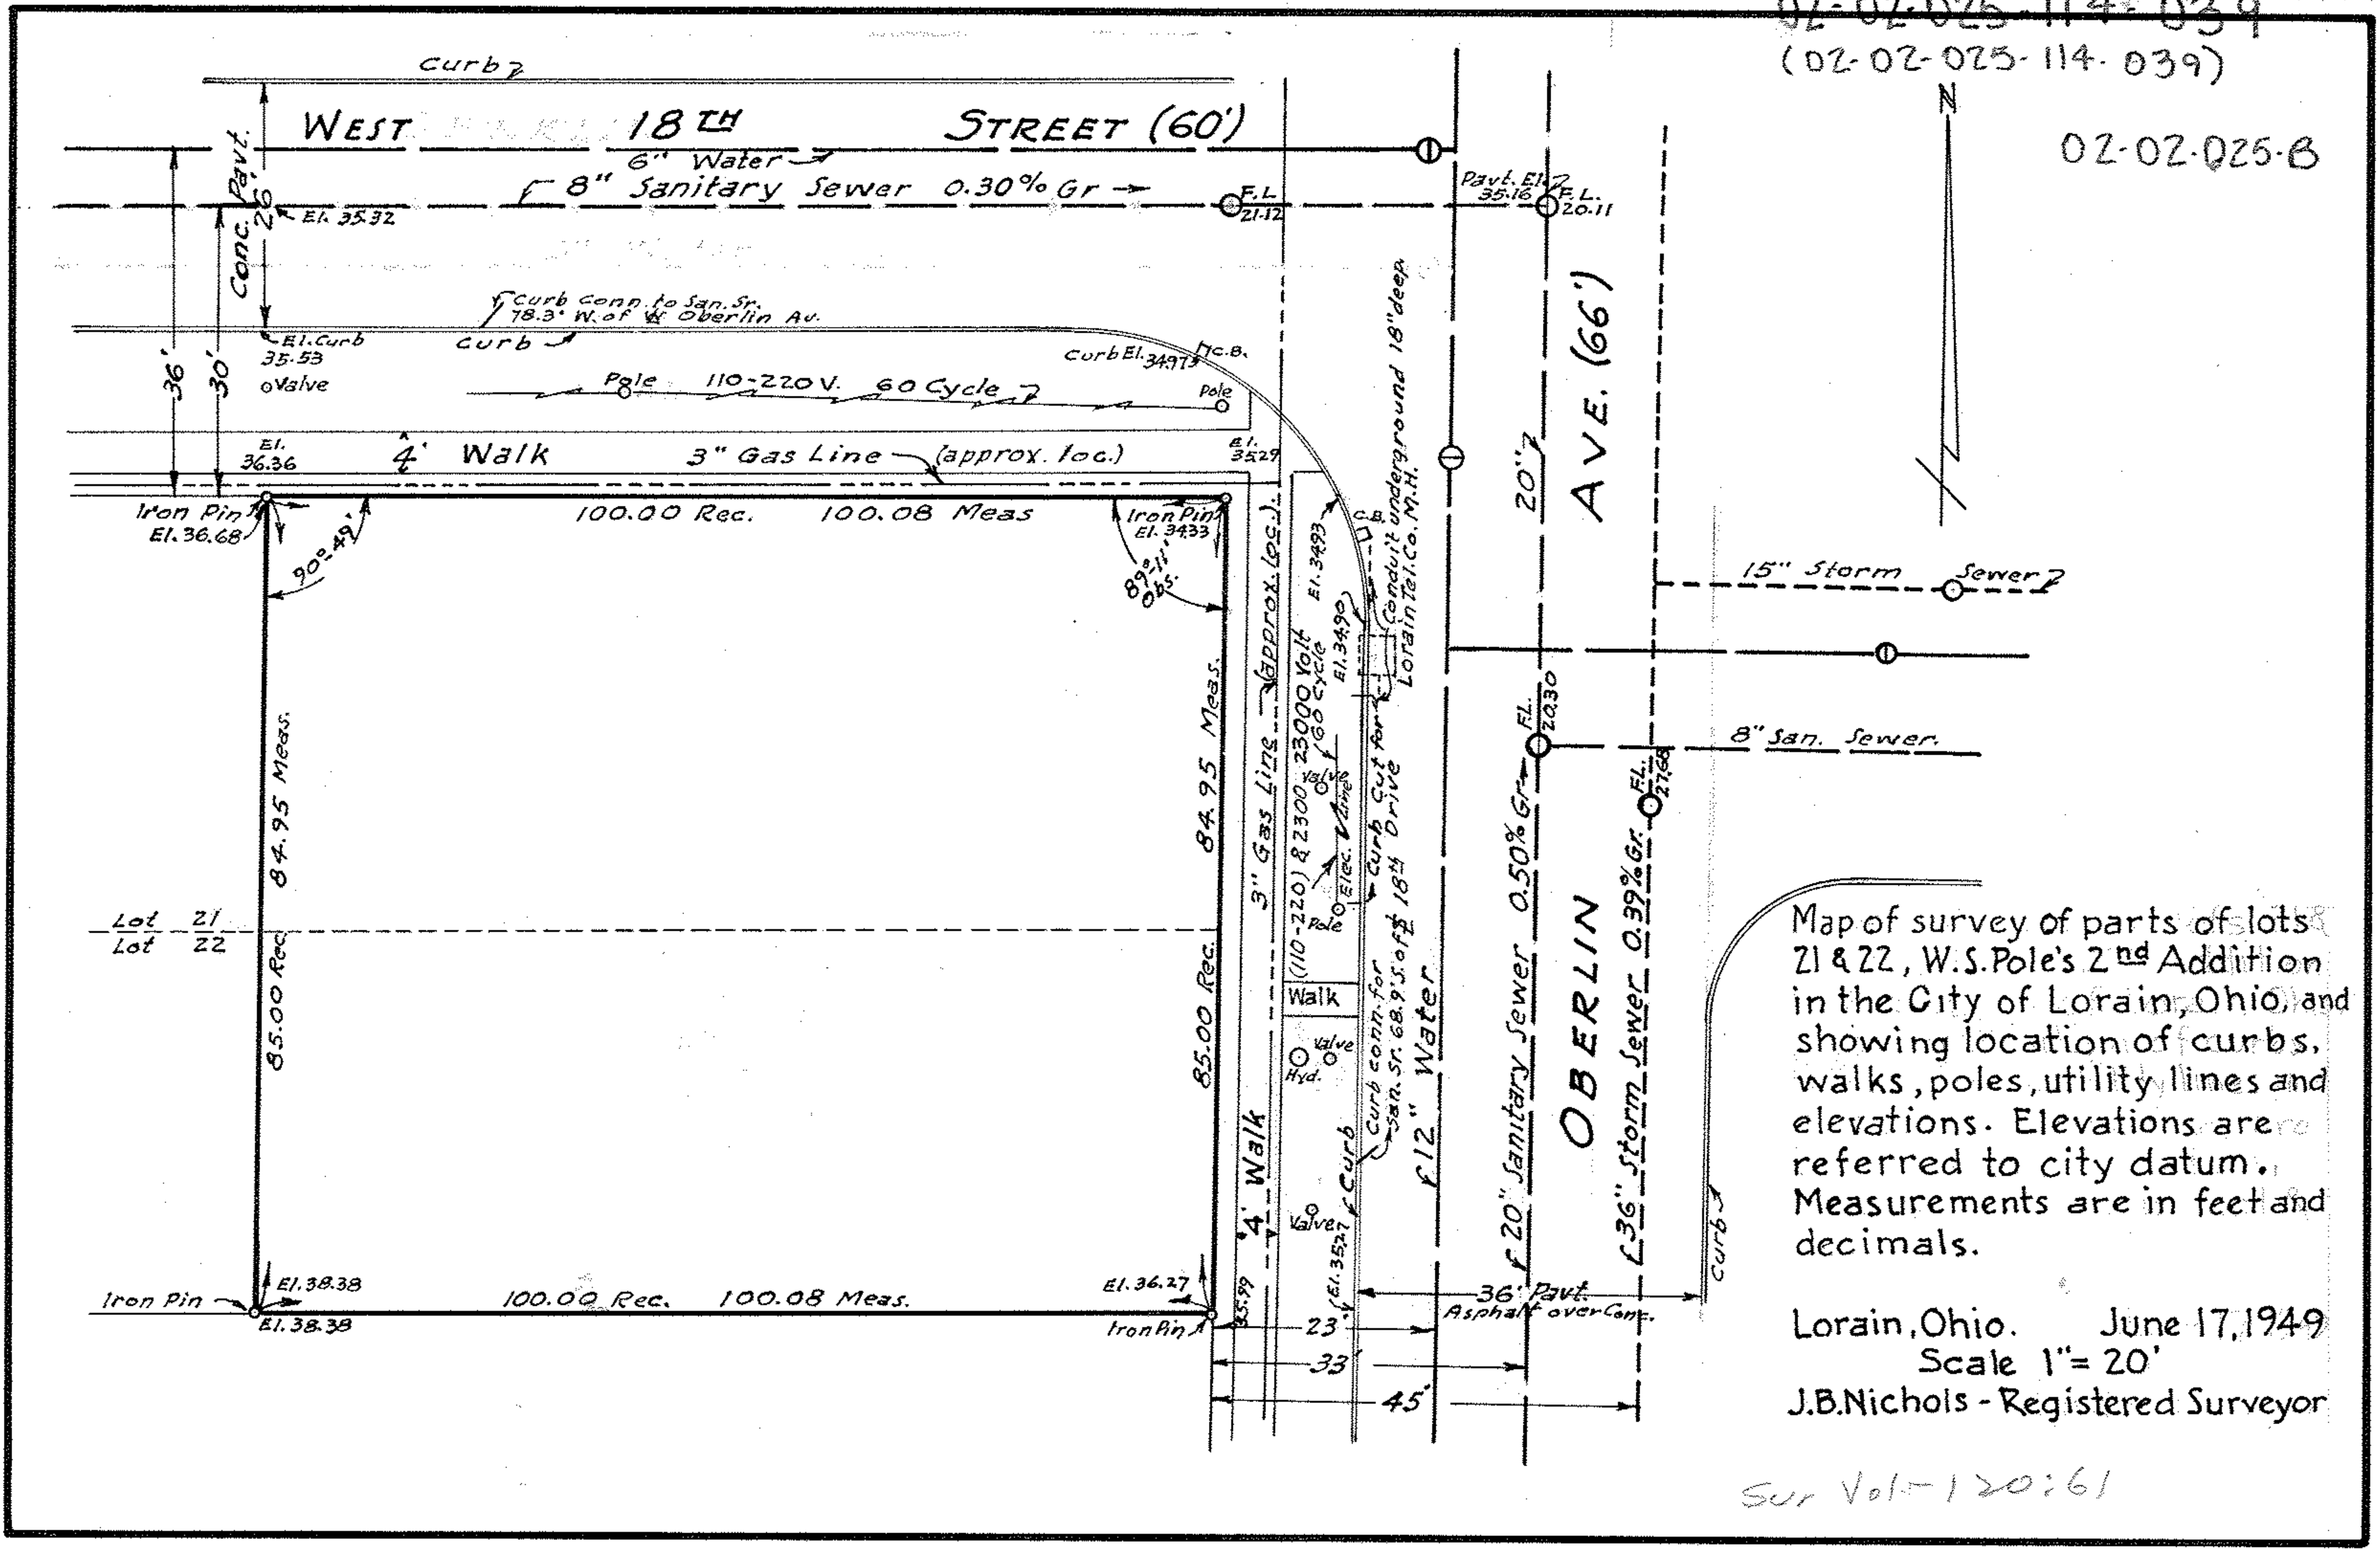

Map of survey of parts of lots 21 & 22, W.S. Pole's 2<sup>nd</sup> Addition in the City of Lorain, Ohio, and showing location of curbs, walks, poles, utility lines and elevations. Elevations are referred to city datum. Measurements are in feet and decimals.

Lorain, Ohio. June 17, 1949  
Scale 1" = 20'  
J.B. Nichols - Registered Surveyor

Sur Vol-120:61