

04-00-019-101-???


04-00-019-B

61-P-5

L A K E

L A K E

N

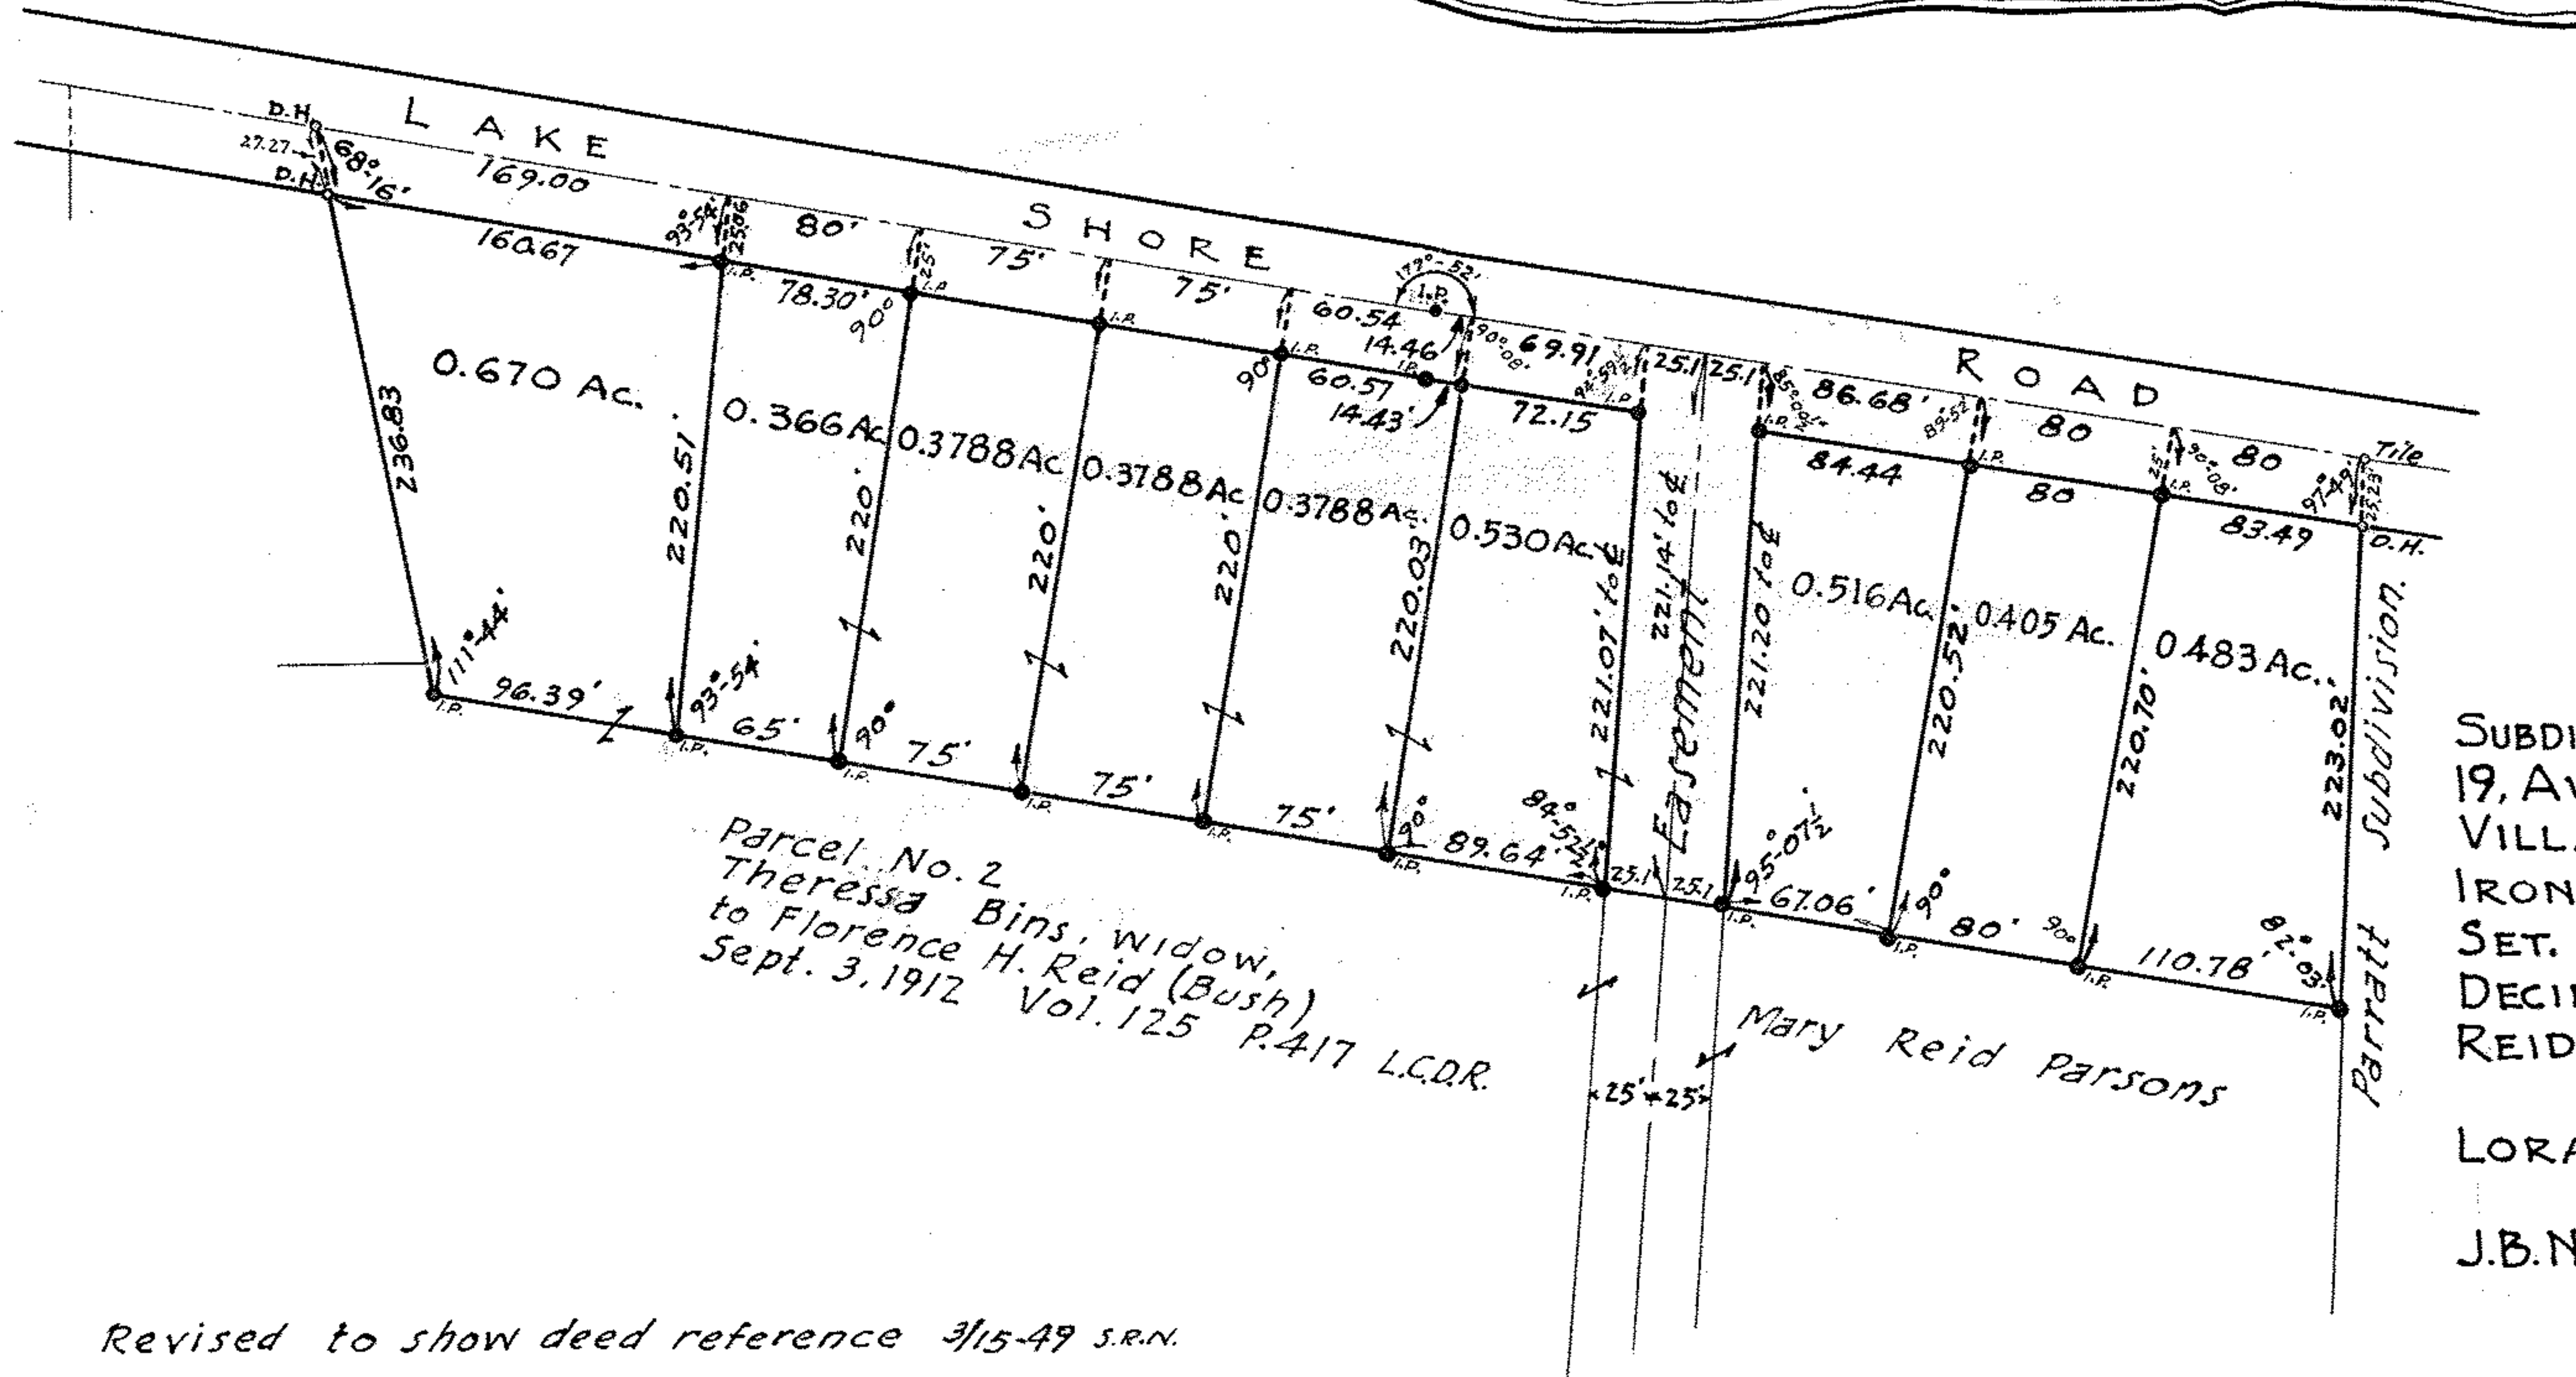

Parcel No. 2
 Theresa Bins, widow,
 to Florence H. Reid (Bush)
 Sept. 3, 1912 Vol. 125 P. 417 L.C.D.R.

Mary Reid Parsons

Parratt Subdivision

SUBDIVISION OF LAND IN SECTION 19, AVON TOWNSHIP, NOW IN THE VILLAGE OF AVON LAKE, OHIO. IRON PINS, SHOWN THUS (●) WERE SET. DISTANCES ARE IN FEET AND DECIMALS. WORK DONE FOR FLORENCE REID BUSH.

LORAIN, OHIO. MARCH 8, 1949
 SCALE 1"=100'
 J.B. NICHOLS - REGISTERED SURVEYOR.

Revised to show deed reference 3/15-49 S.R.N.

See S-E-119
 K-39

61-P-5