


O.L. 2  
O.L. 19

Henry S. Rockwood Oct. 7, 1834 D. Vol. 8 Pg. 111.


April 7, 1840  
D. Vol. 8 Pg. 112

LAGRANGE  
D. Vol. 32 Pg. 31  
May 5, 1870

TWP. CEMETERY  
D. Vol. 88 Pg. 335  
July 1902

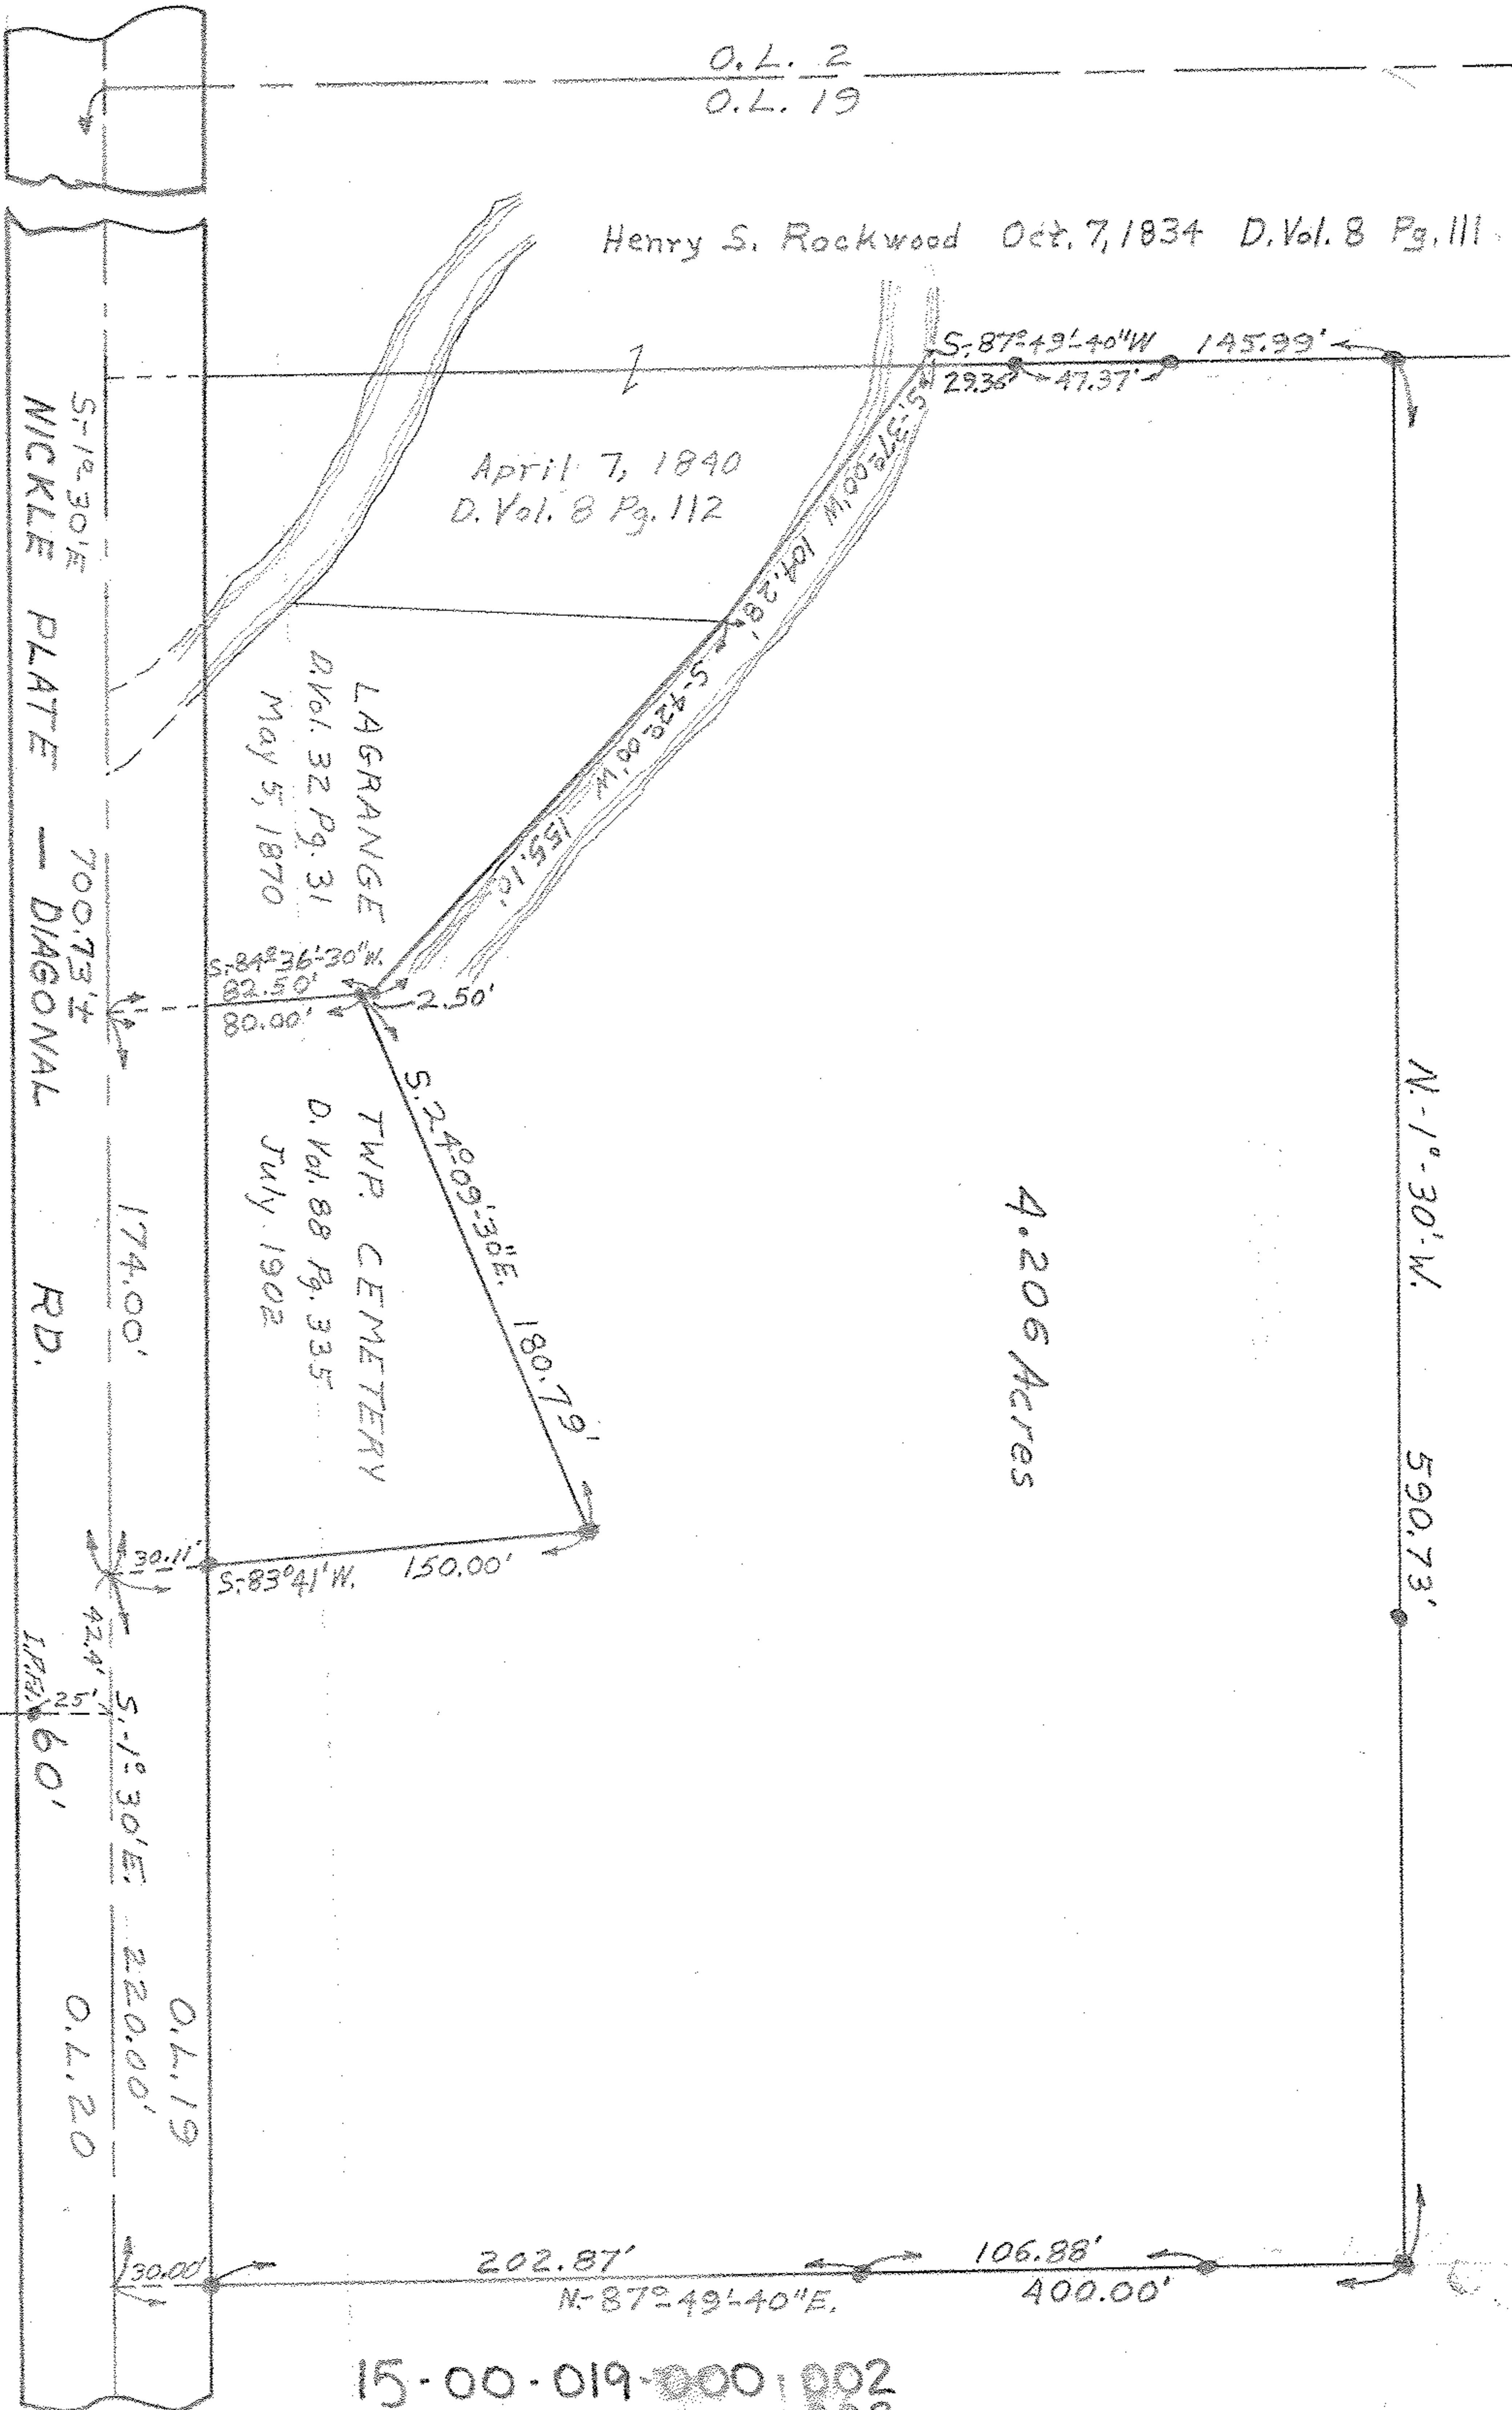

4.206 Acres

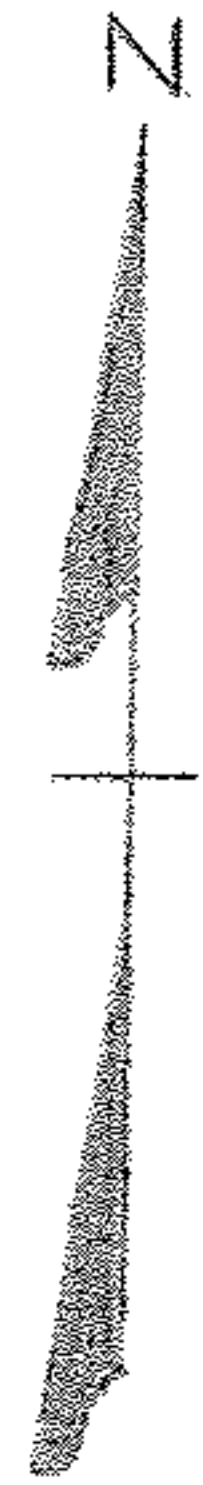

Note: Iron pins found or set shown thus: ●

# PLAT OF SURVEY FOR FRED SMITH

ORIGINAL LOT 19 - LAGRANGE TWP.

LORAIN COUNTY - OHIO

SCALE: 1"=60'

APRIL 29, 1957

15-00-019-000-002  
15-A