


03-00-066-102-011
03-00-066-B

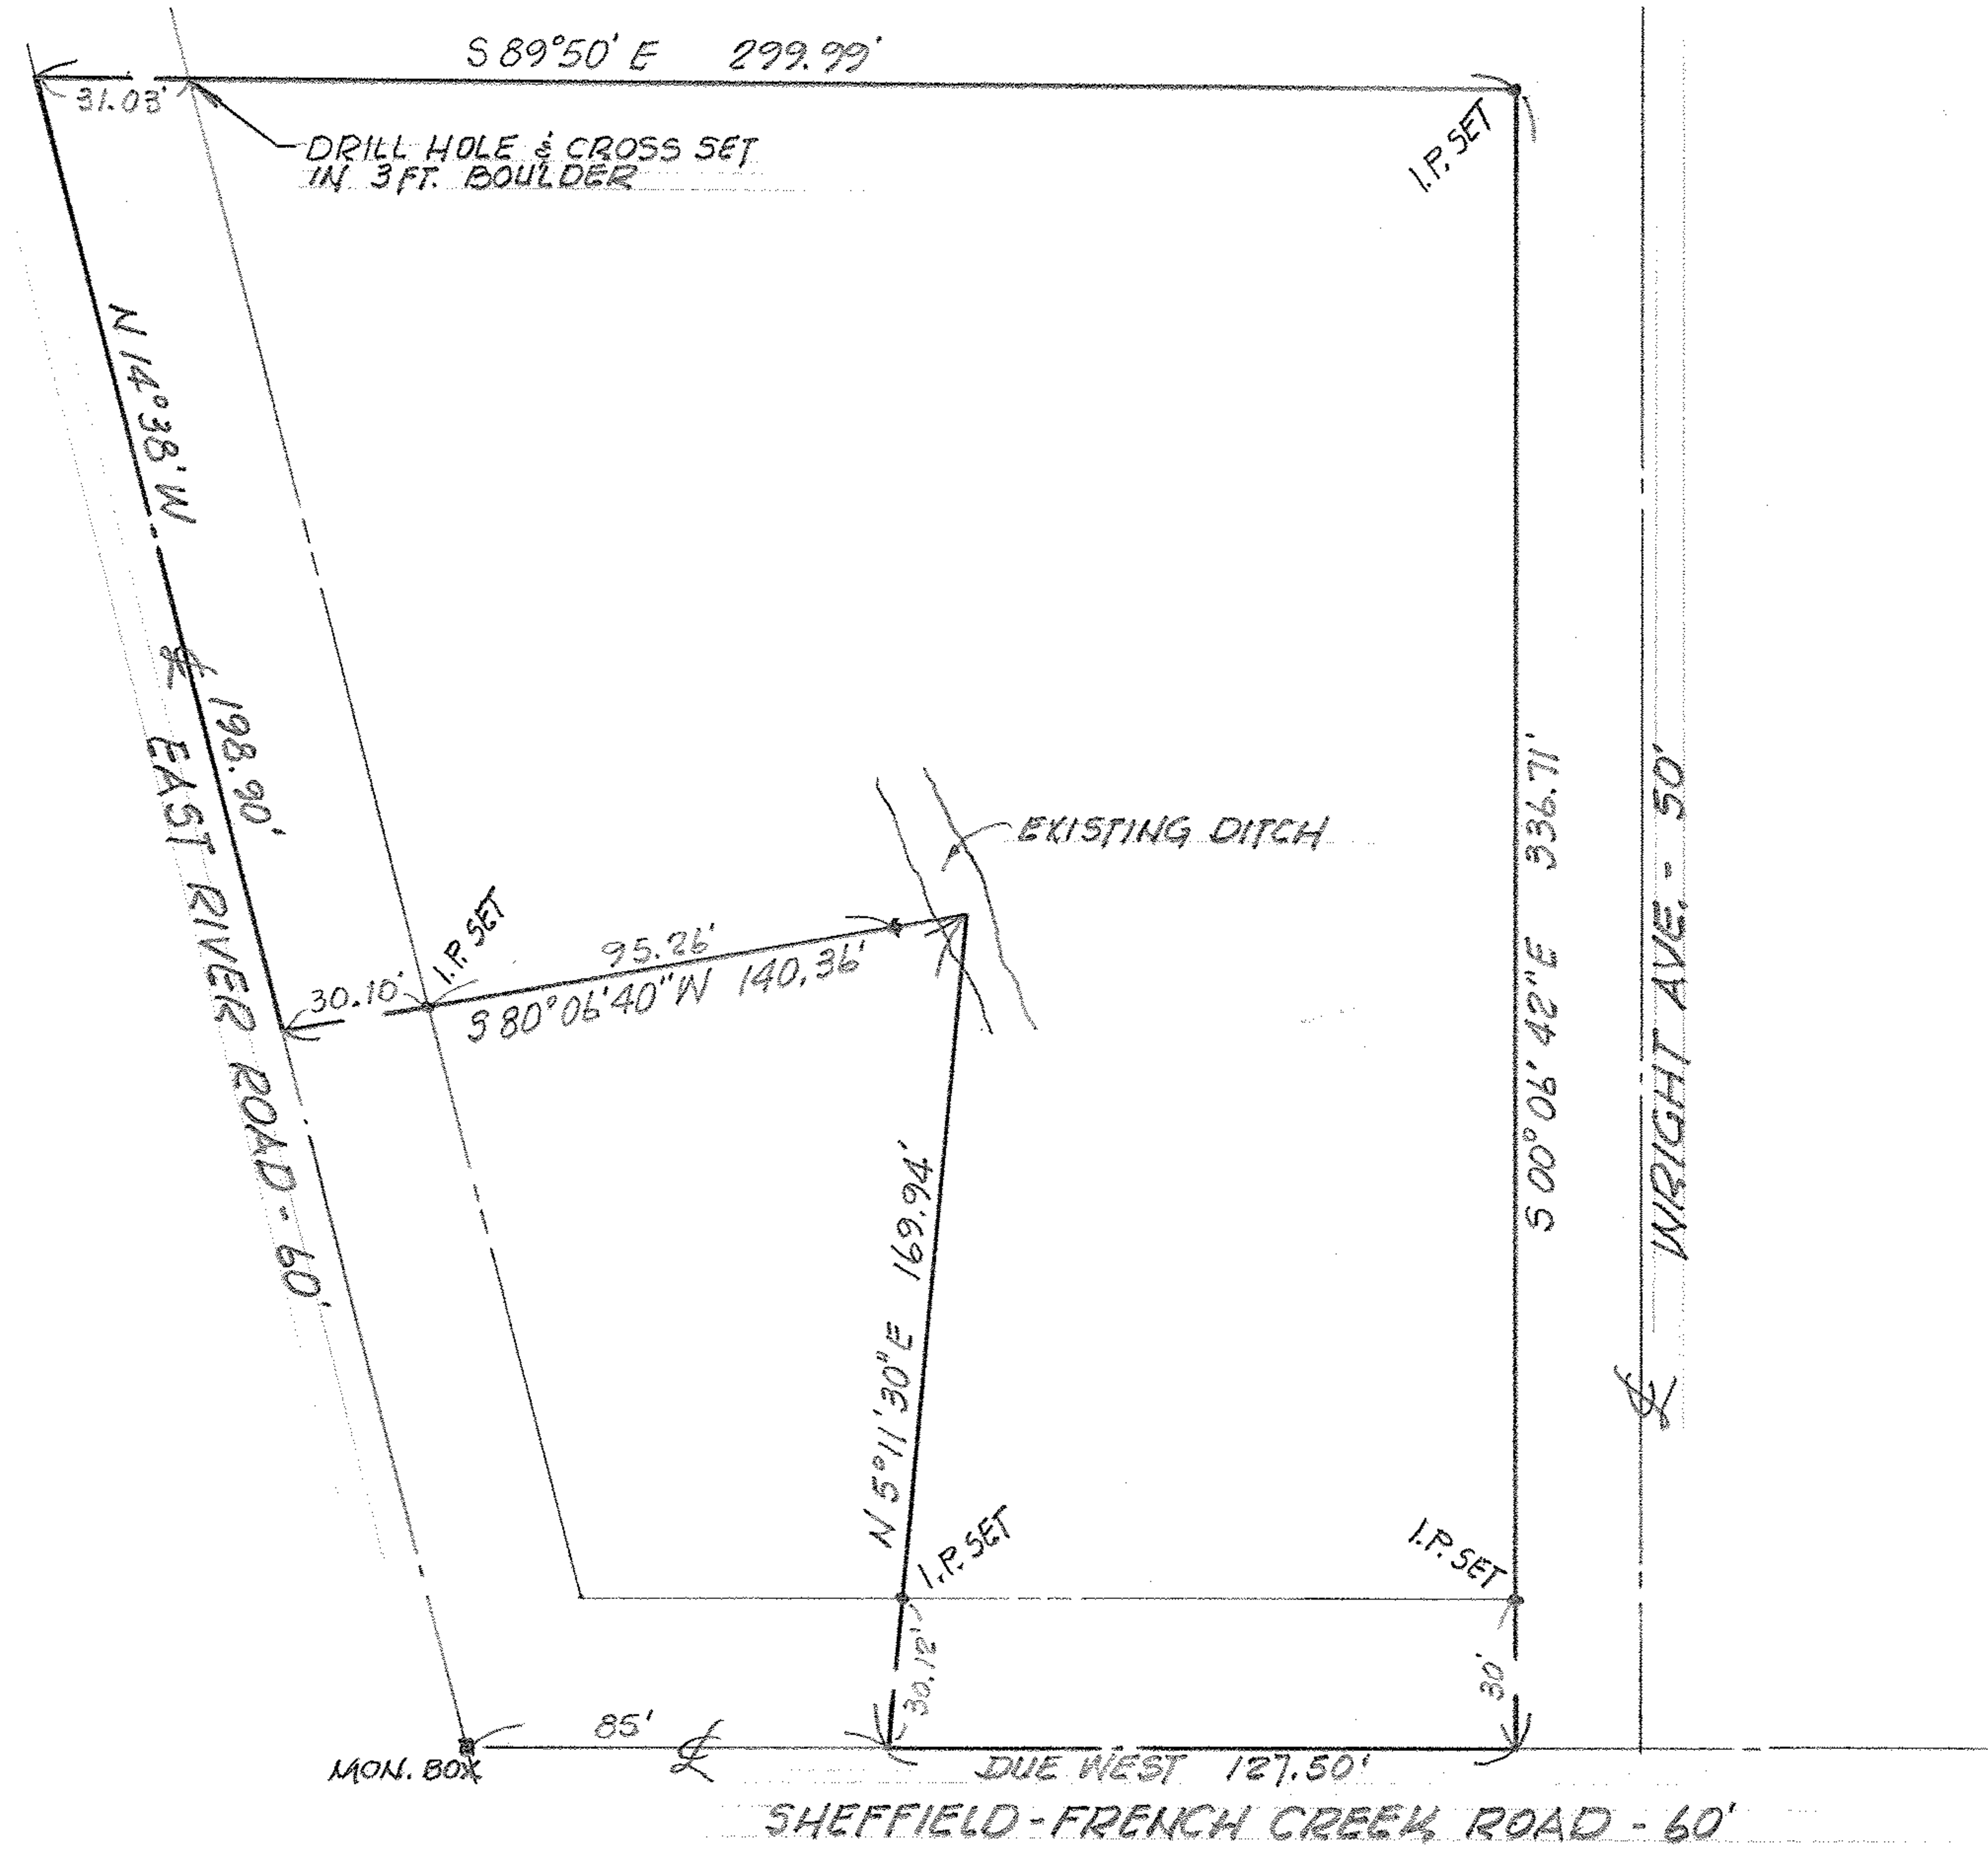

SCALE: 1"=40'

MAP of SURVEY

PREPARED FOR HILDA MULERO et. al.
 PART of ORIGINAL SHEFFIELD TWP. LOT No. 66
 VILLAGE of SHEFFIELD, LORAIN COUNTY, OHIO

McGLINCHY and ASSOCIATES
 PROFESSIONAL ENGINEER & SURVEYORS
 ELYRIA, OHIO
 AUGUST 1978 783743