


PART of ORIGINAL CARLISLE TWP SECTION No. 19  
 TOWNSHIP of CARLISLE, LORAIN COUNTY, OHIO

PT. ORIG. RR# 10-00-019-000-009

MAP of SURVEY  
 PREPARED FOR RONNIE COX

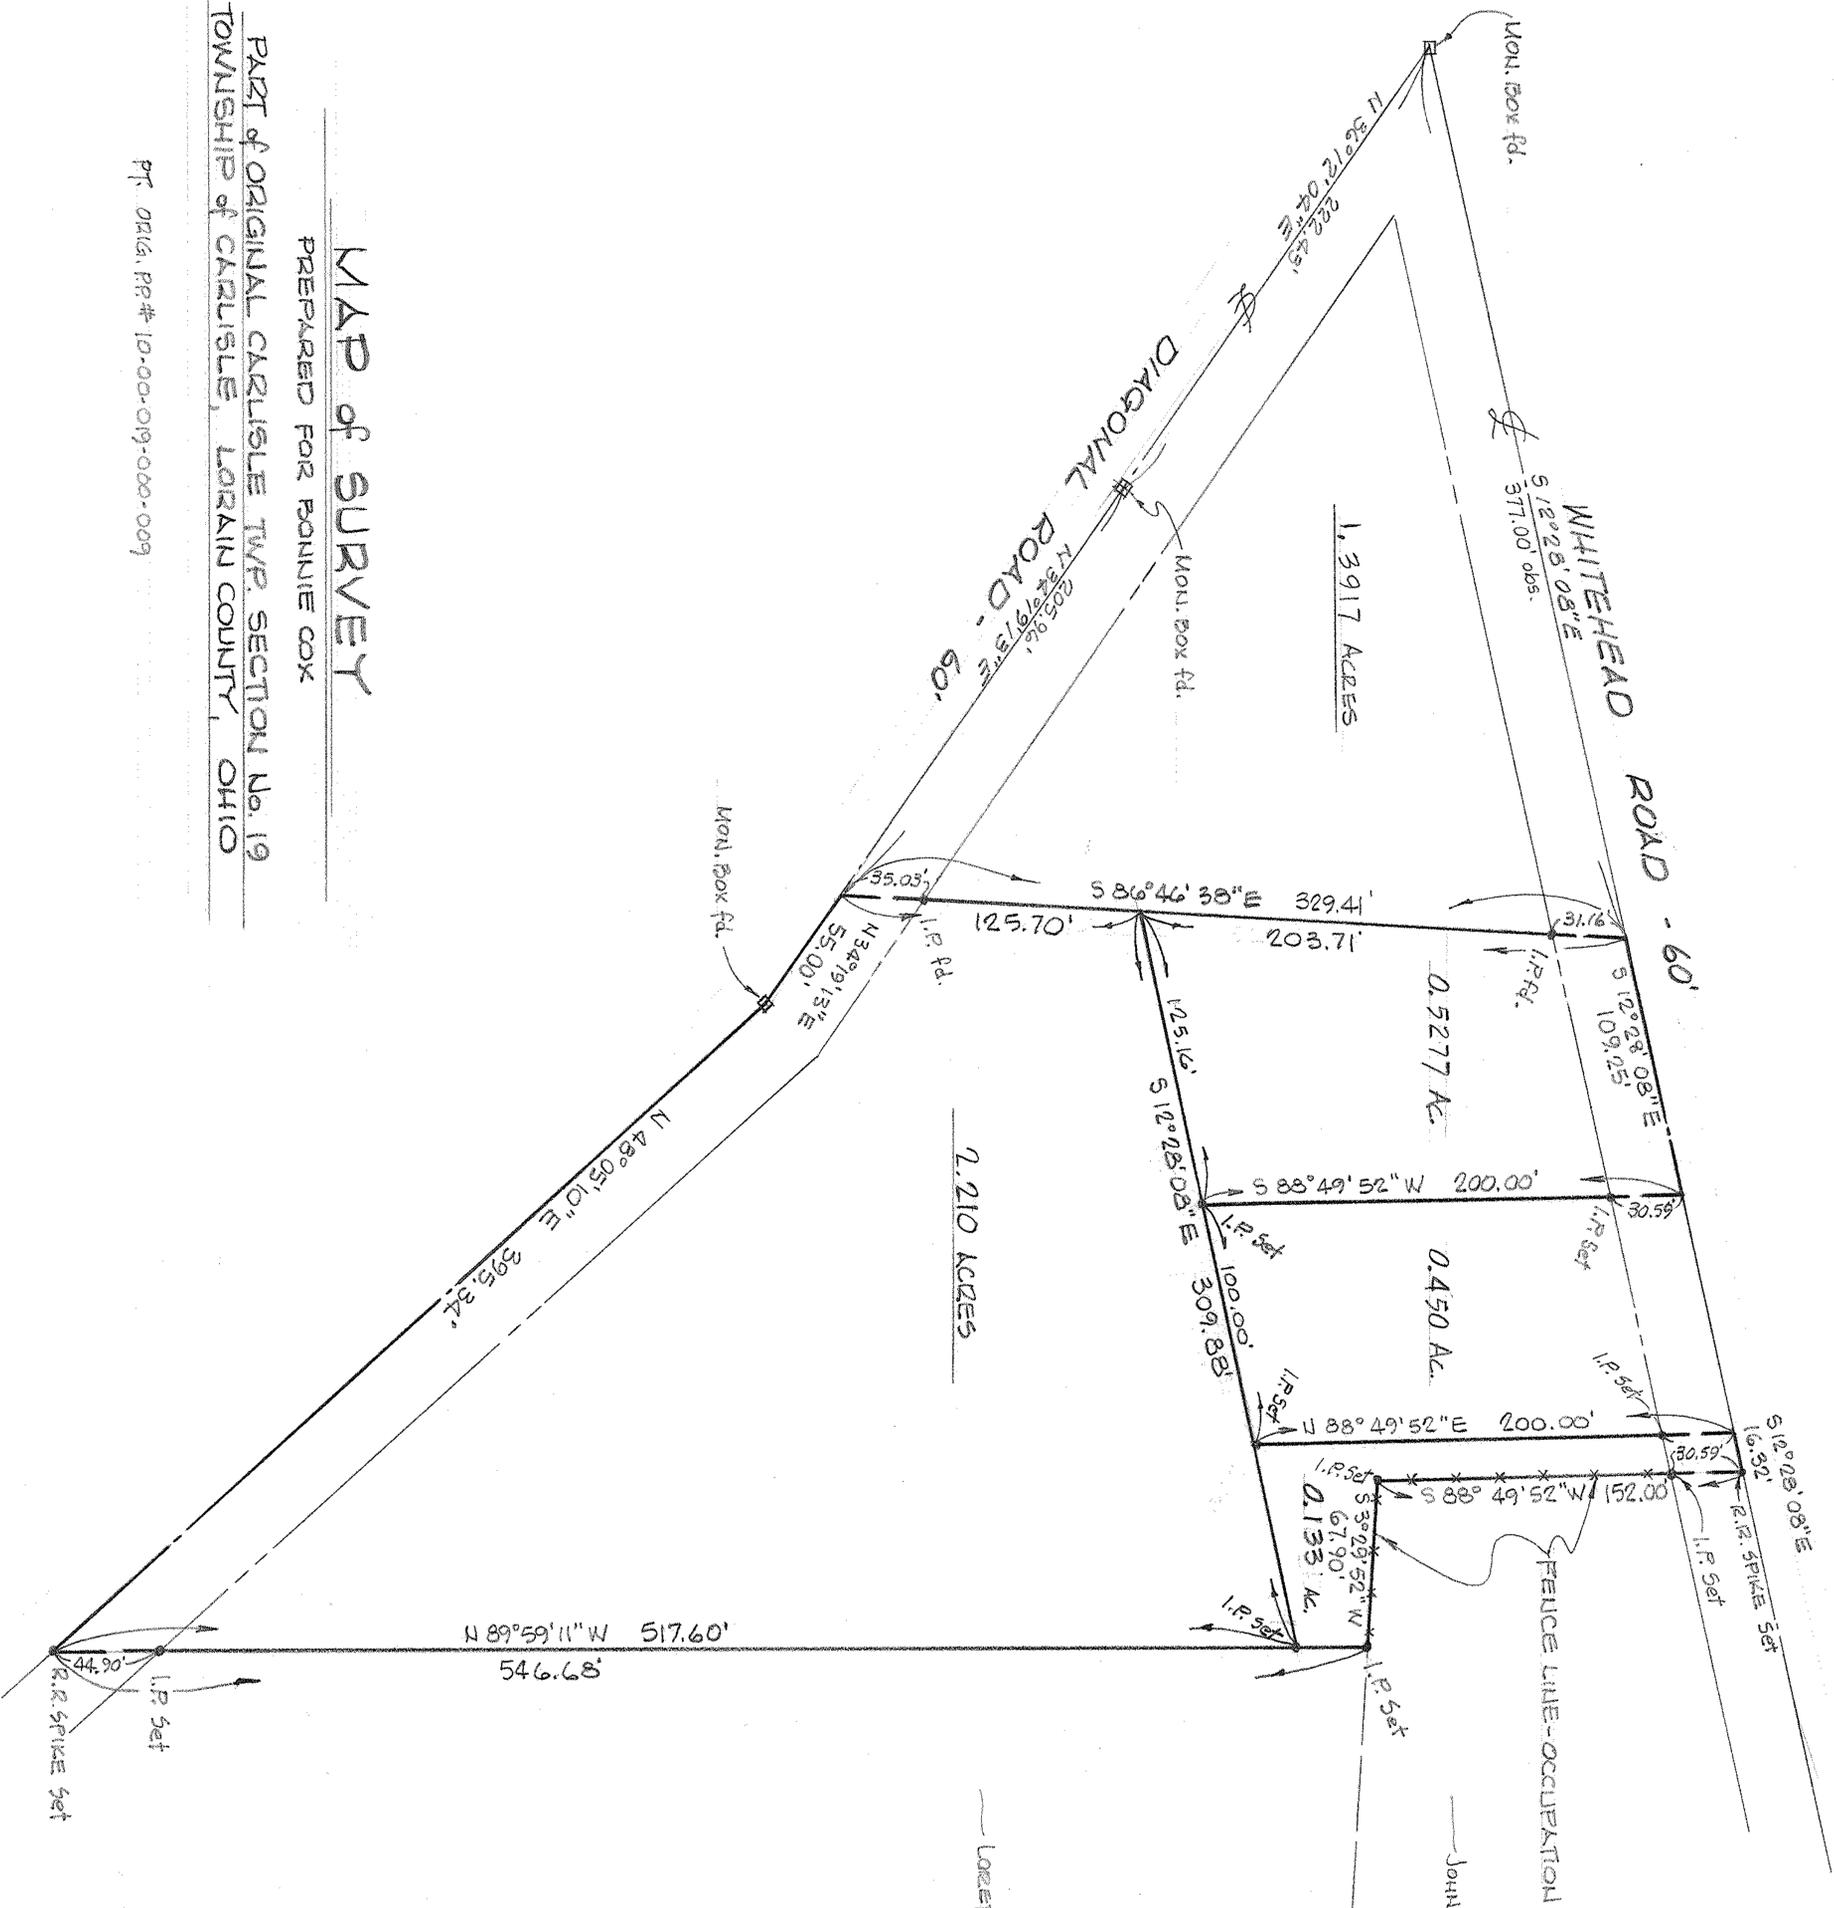

McGLINCHY and ASSOCIATES, INC.  
 PROFESSIONAL ENGINEER and SURVEYORS  
 110 1/2 MIDDLE AVE. ELYRIA, OHIO  
 DECEMBER, 1980 #782905-A  
 REV. 10-29-80  
 REV. 12-30-80 AC  
 10-00-019-000-043, -053 thru -055  
 10-F