

PLAT OF PROPERTY SURVEY AT THE REQUEST OF
JOHN S. HADGIS
 PART OF ORIGINAL LOT 8, TRACT NO. 3
 ROCHESTER TOWNSHIP, LORAIN COUNTY, OHIO


APPROVED
 LORAIN CO.
 MAP DEPT

DATE 8/31/09

PAGE 20-03-008-B

BY D. Holland

#09-01879-A

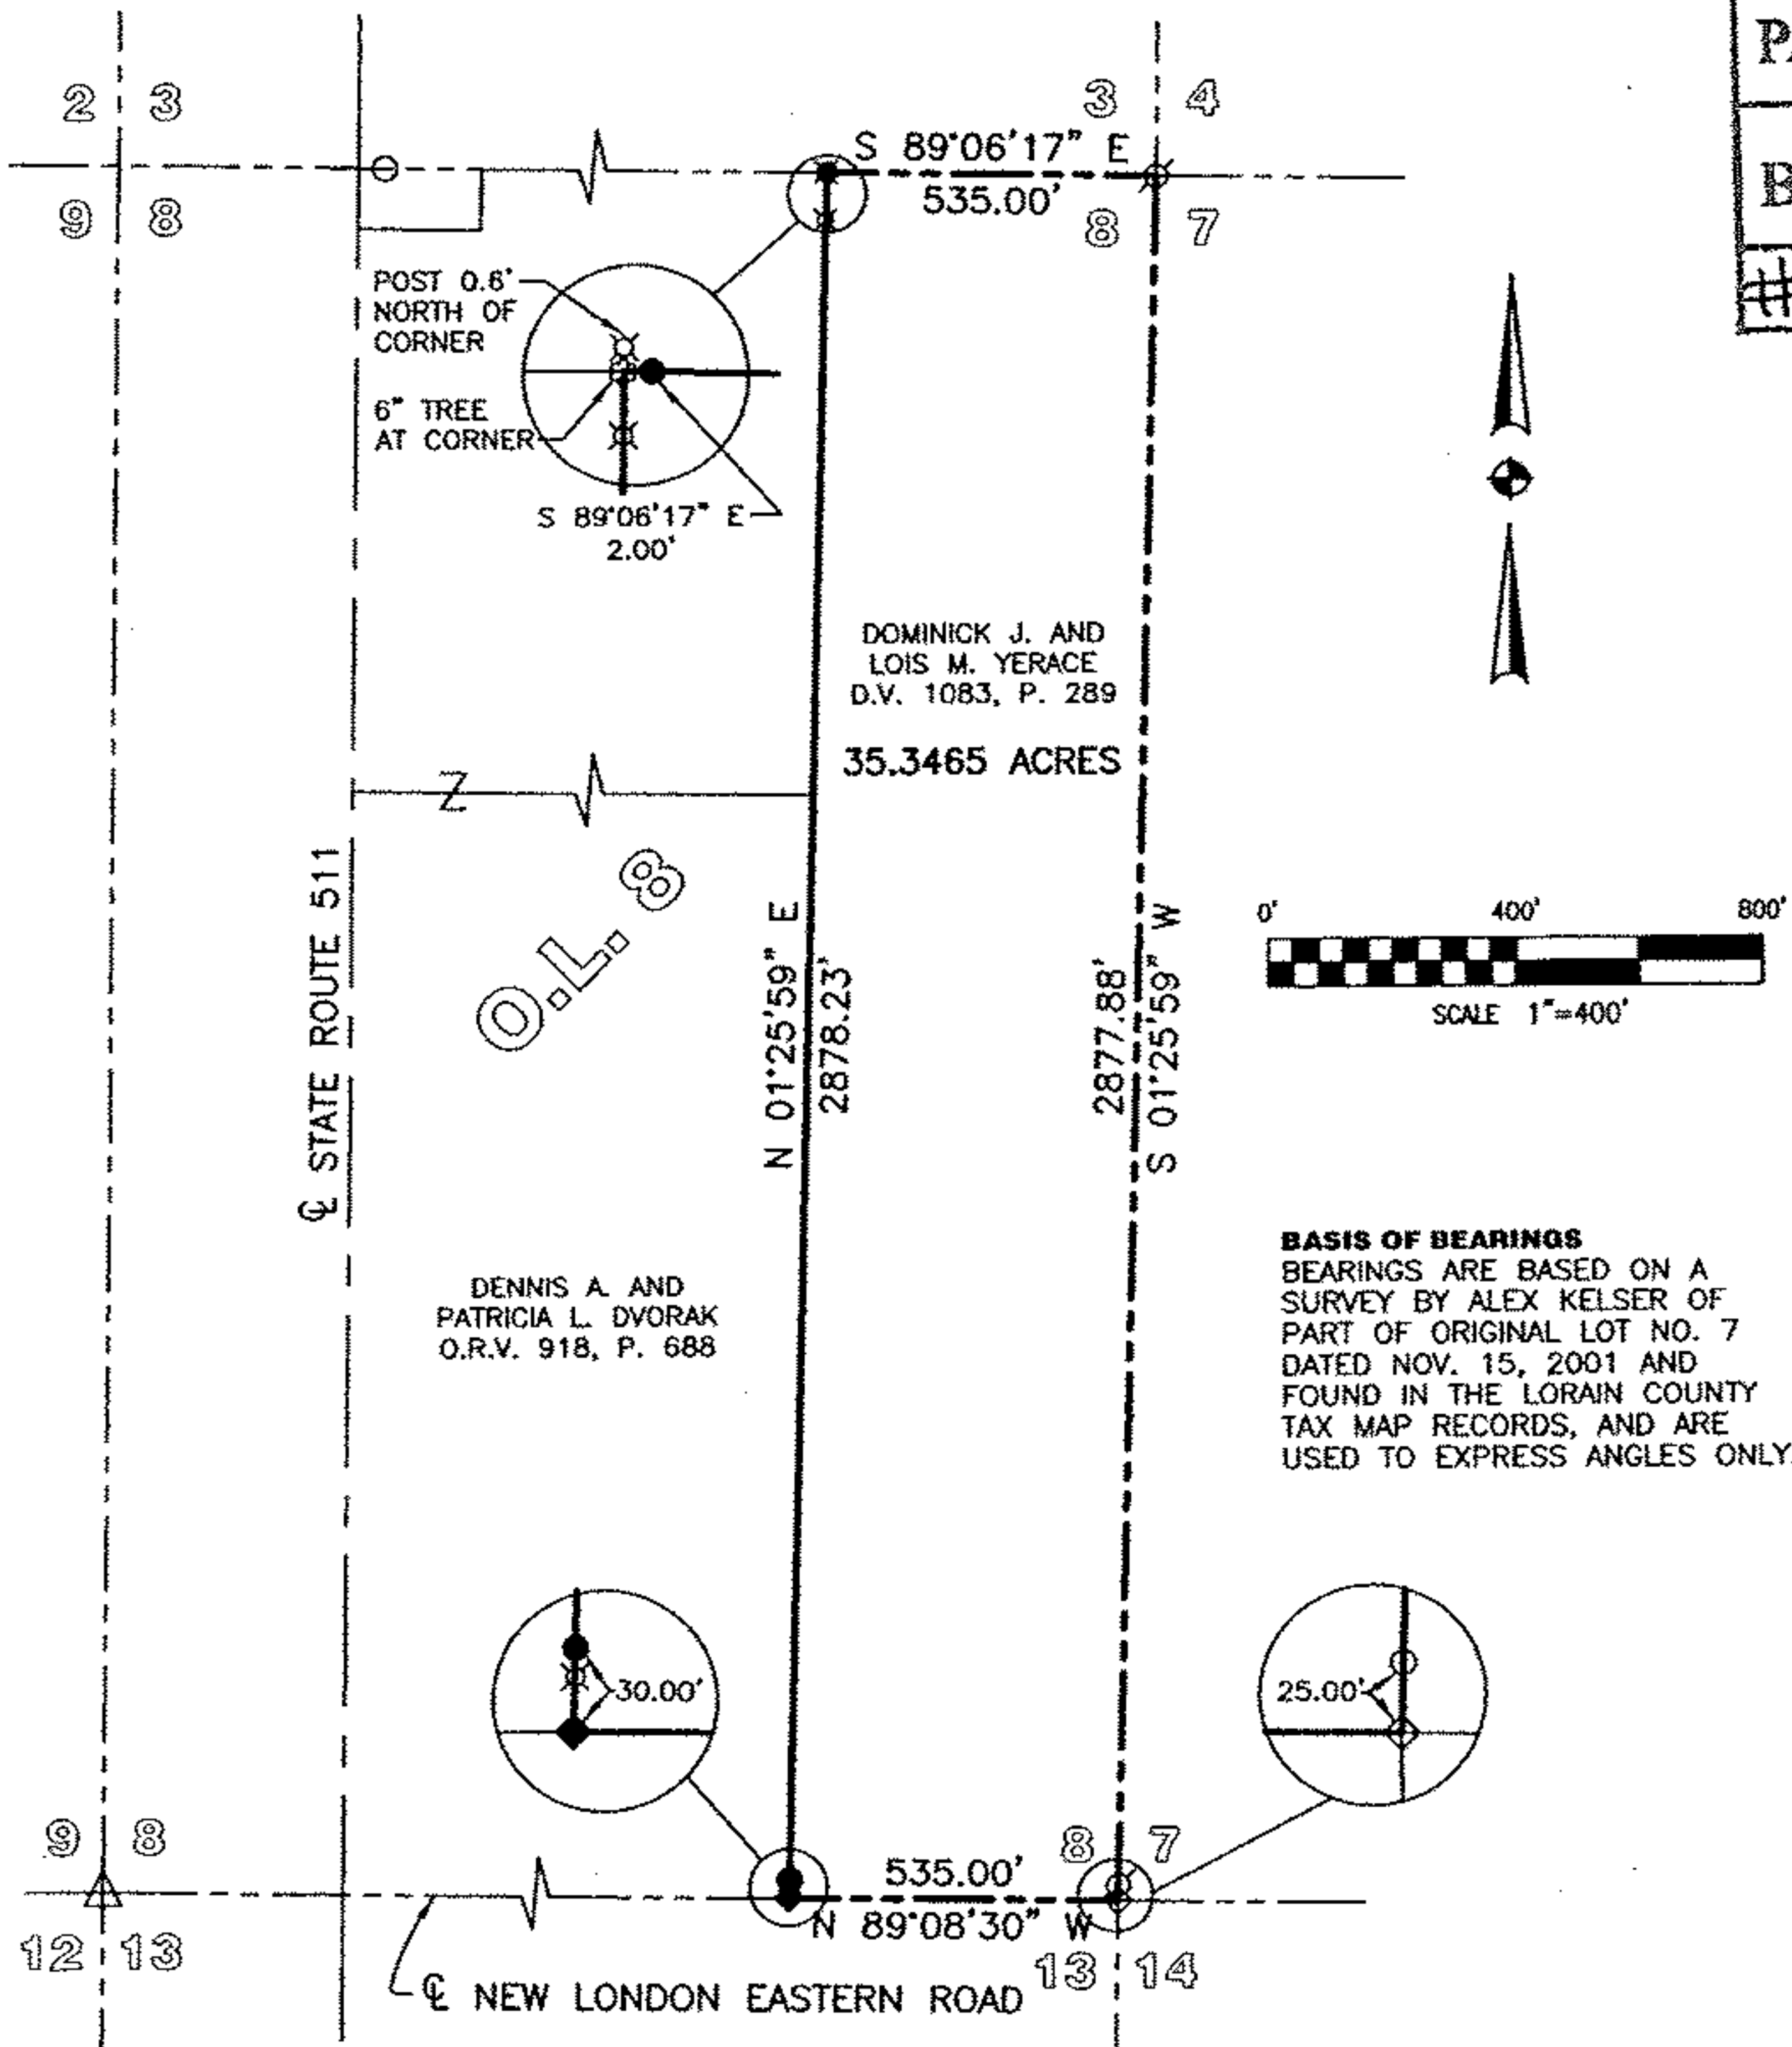

BASIS OF BEARINGS
 BEARINGS ARE BASED ON A SURVEY BY ALEX KELSER OF PART OF ORIGINAL LOT NO. 7 DATED NOV. 15, 2001 AND FOUND IN THE LORAIN COUNTY TAX MAP RECORDS, AND ARE USED TO EXPRESS ANGLES ONLY.

REFERENCES
 TAX MAP
 DEEDS LISTED HEROEN
 SURVEY BY ALEX KELSER DATED 11/15/01
 SURVEY BY THOMAS M. SNEZEK DATED 8/30/94

LEGEND

- 5/8" DIA x 30" LONG REBAR SET WITH PLASTIC CAP STAMPED "WEIGLER 7747"
- ◇ MAG NAIL FOUND
- IRON PIN FOUND W/CAP STAMPED "KELSER 7871"
- △ RAILROAD SPIKE FOUND
- ⊗ WOOD POST FOUND
- IRON PIPE FOUND

CERTIFICATION: I HEREBY CERTIFY THAT THE FOREGOING SURVEY WAS PREPARED FROM ACTUAL FIELD MEASUREMENTS IN ACCORDANCE WITH CHAPTER 4733-37, OHIO ADMINISTRATIVE CODE.

PREPARED BY
WEIGLER LAND SURVEYING, LTD.

GARY E. WEIGLER
 OHIO REGISTERED SURVEYOR NO. 7747
 DATE: MAY 12, 2009
 FILE NO. 09011

