


1-00-022-A  
 01-00-022-103-002  
 01-00-022-120-00-10  
 01-00-022-008-008  
 01-00-022-001-022

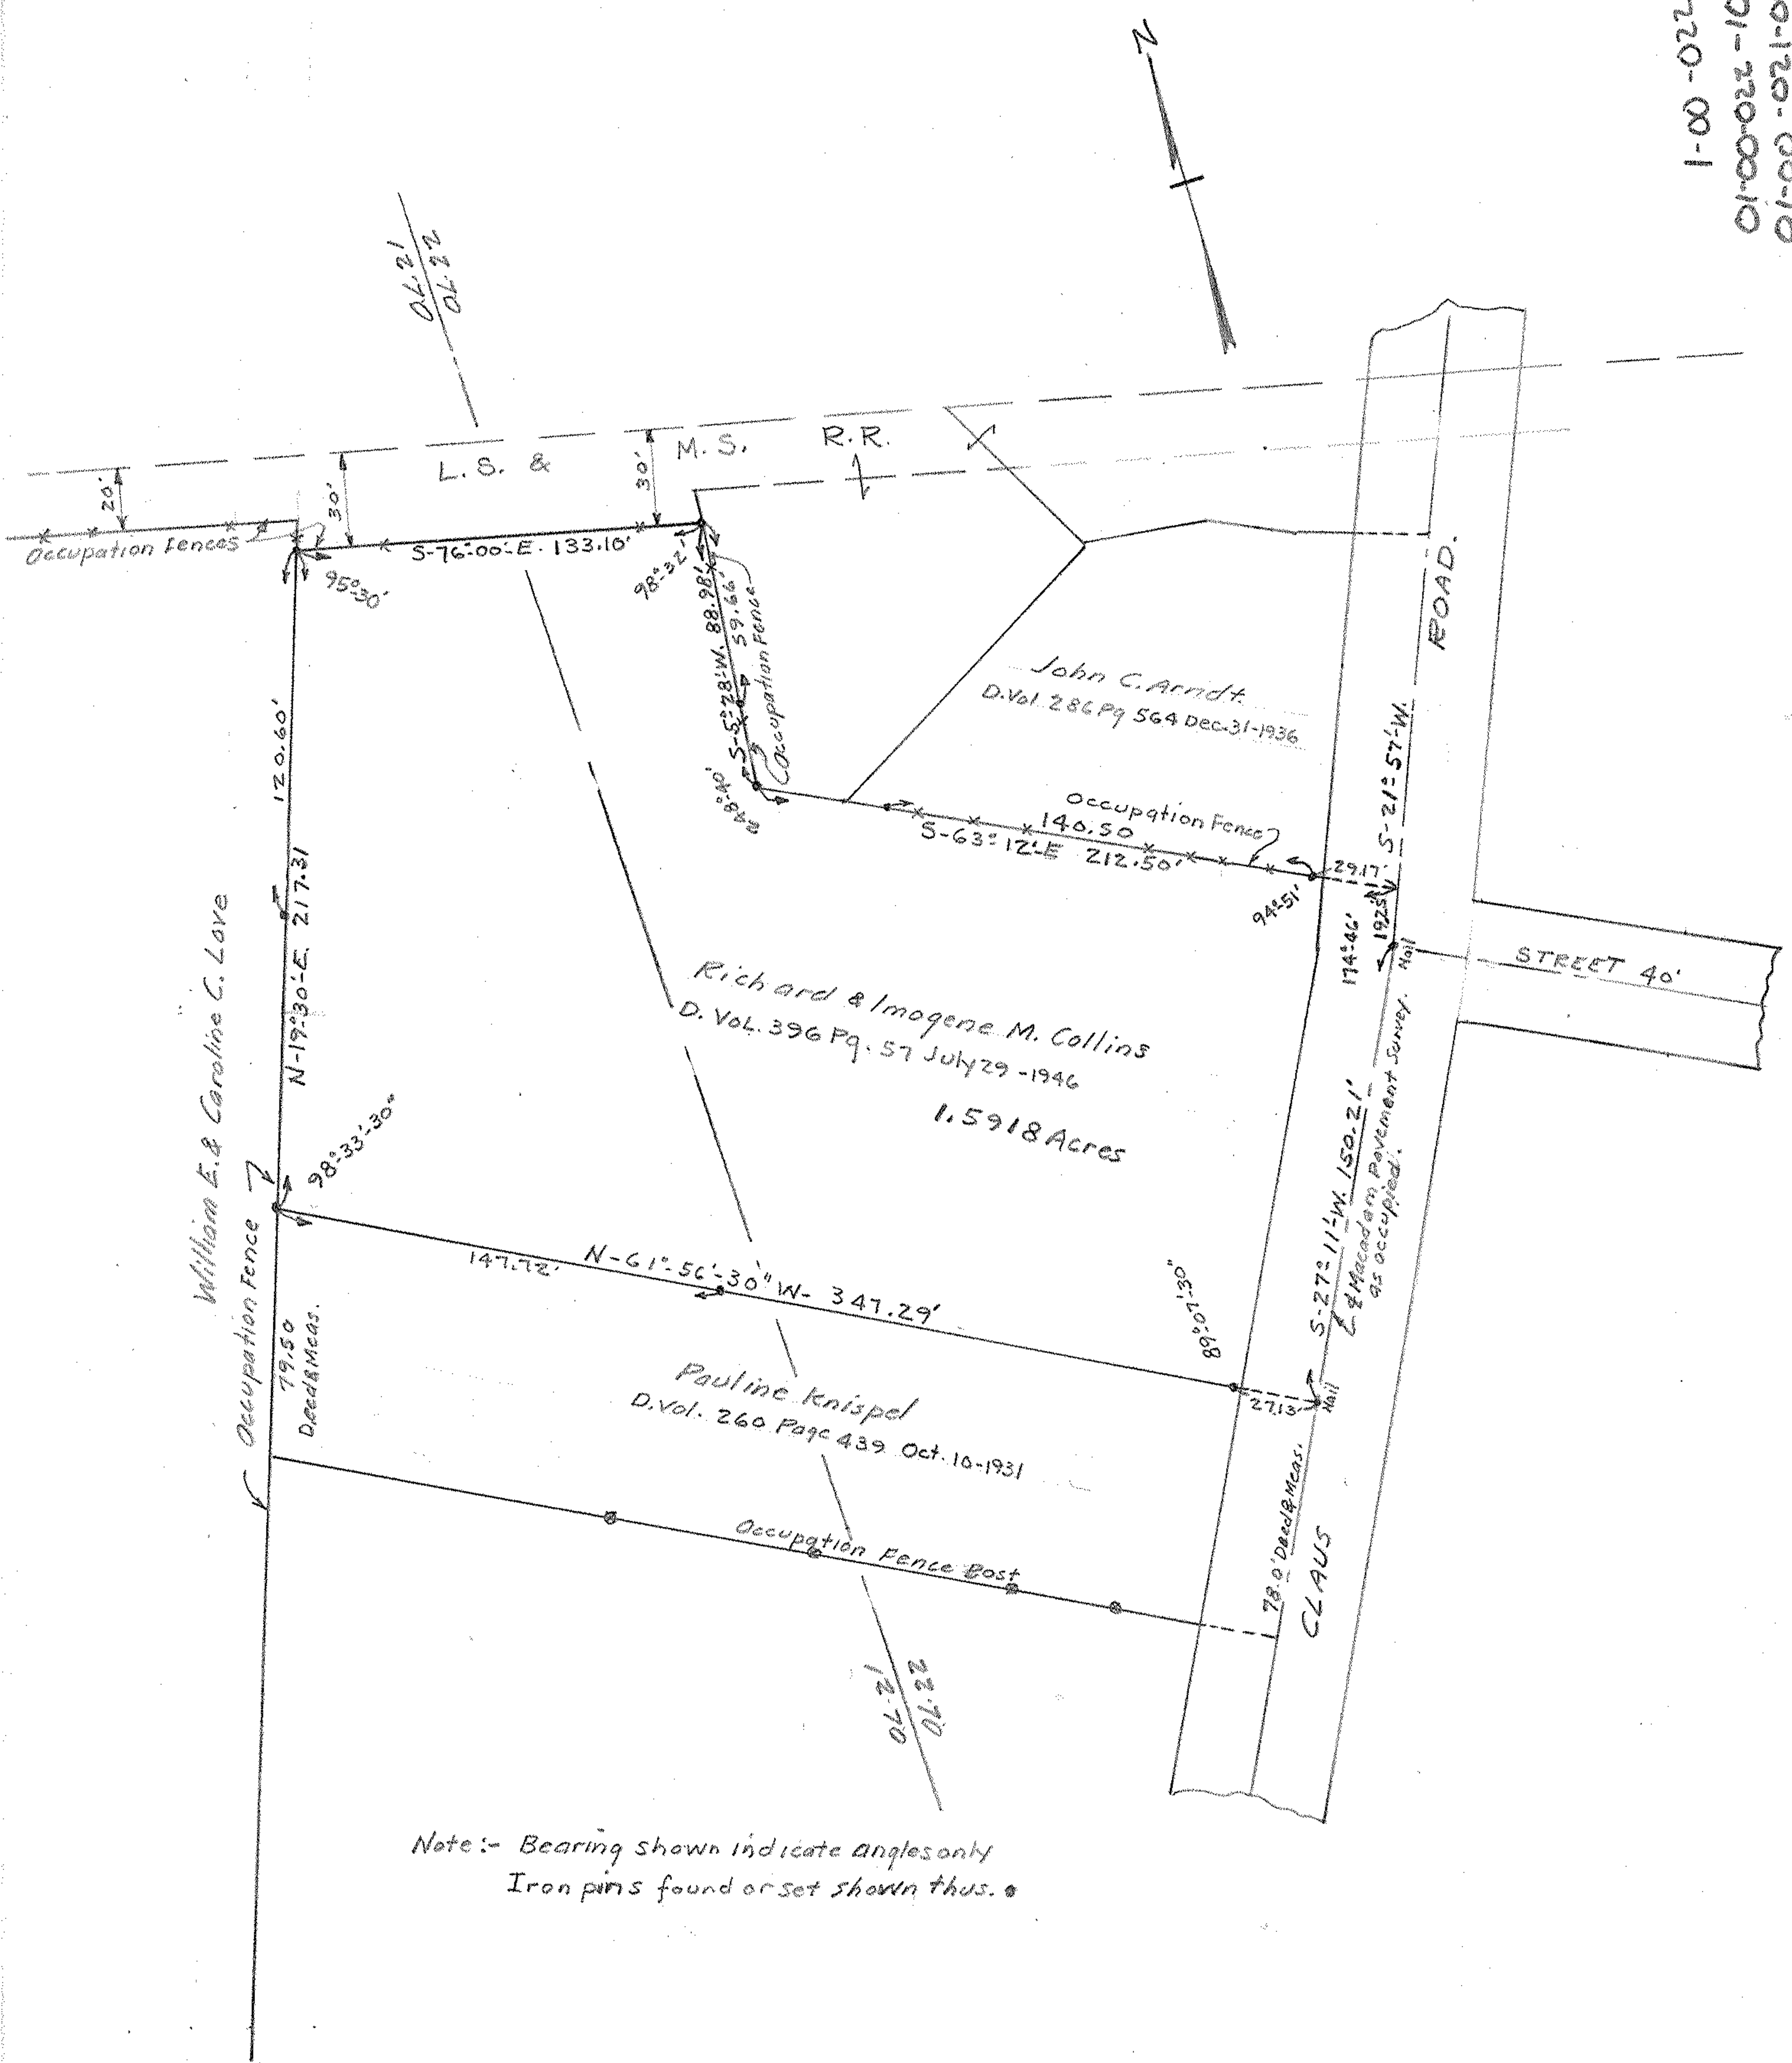

Note:- Bearing shown indicate angles only  
 Iron pins found or set shown thus. \*

MAP OF SURVEY FOR  
 RICHARD & IMOGENE M. COLLINS  
 BROWNHELM STATION  
 OL. 21 & 22 BROWNHELM TOWNSHIP  
 LORAIN COUNTY OHIO  
 Scale 1" = 50' JUNE 23-1952  
 C.E. Penfound Registered Surveyor.

