

Samuel & Mary Mungeon
D. Vol. 233 PG. 310 Jan. 20-1928

CORPORATION LINE VILLAGE OF OBERLIN



Ella Johnson
D. Vol. 331 PG. 645 Dec. 28-1943


Charlie Johnson
D. Vol. 480 PG. 17 July-1949

John Thomas
D. Vol. 469 PG. 576 July 16-1949

Ed. Lewis
0.3281Ac

George M. Harvey
D. Vol. 438 PG. 503 May 11-1948

Robert & Mattie S. Wynn
1.000Ac

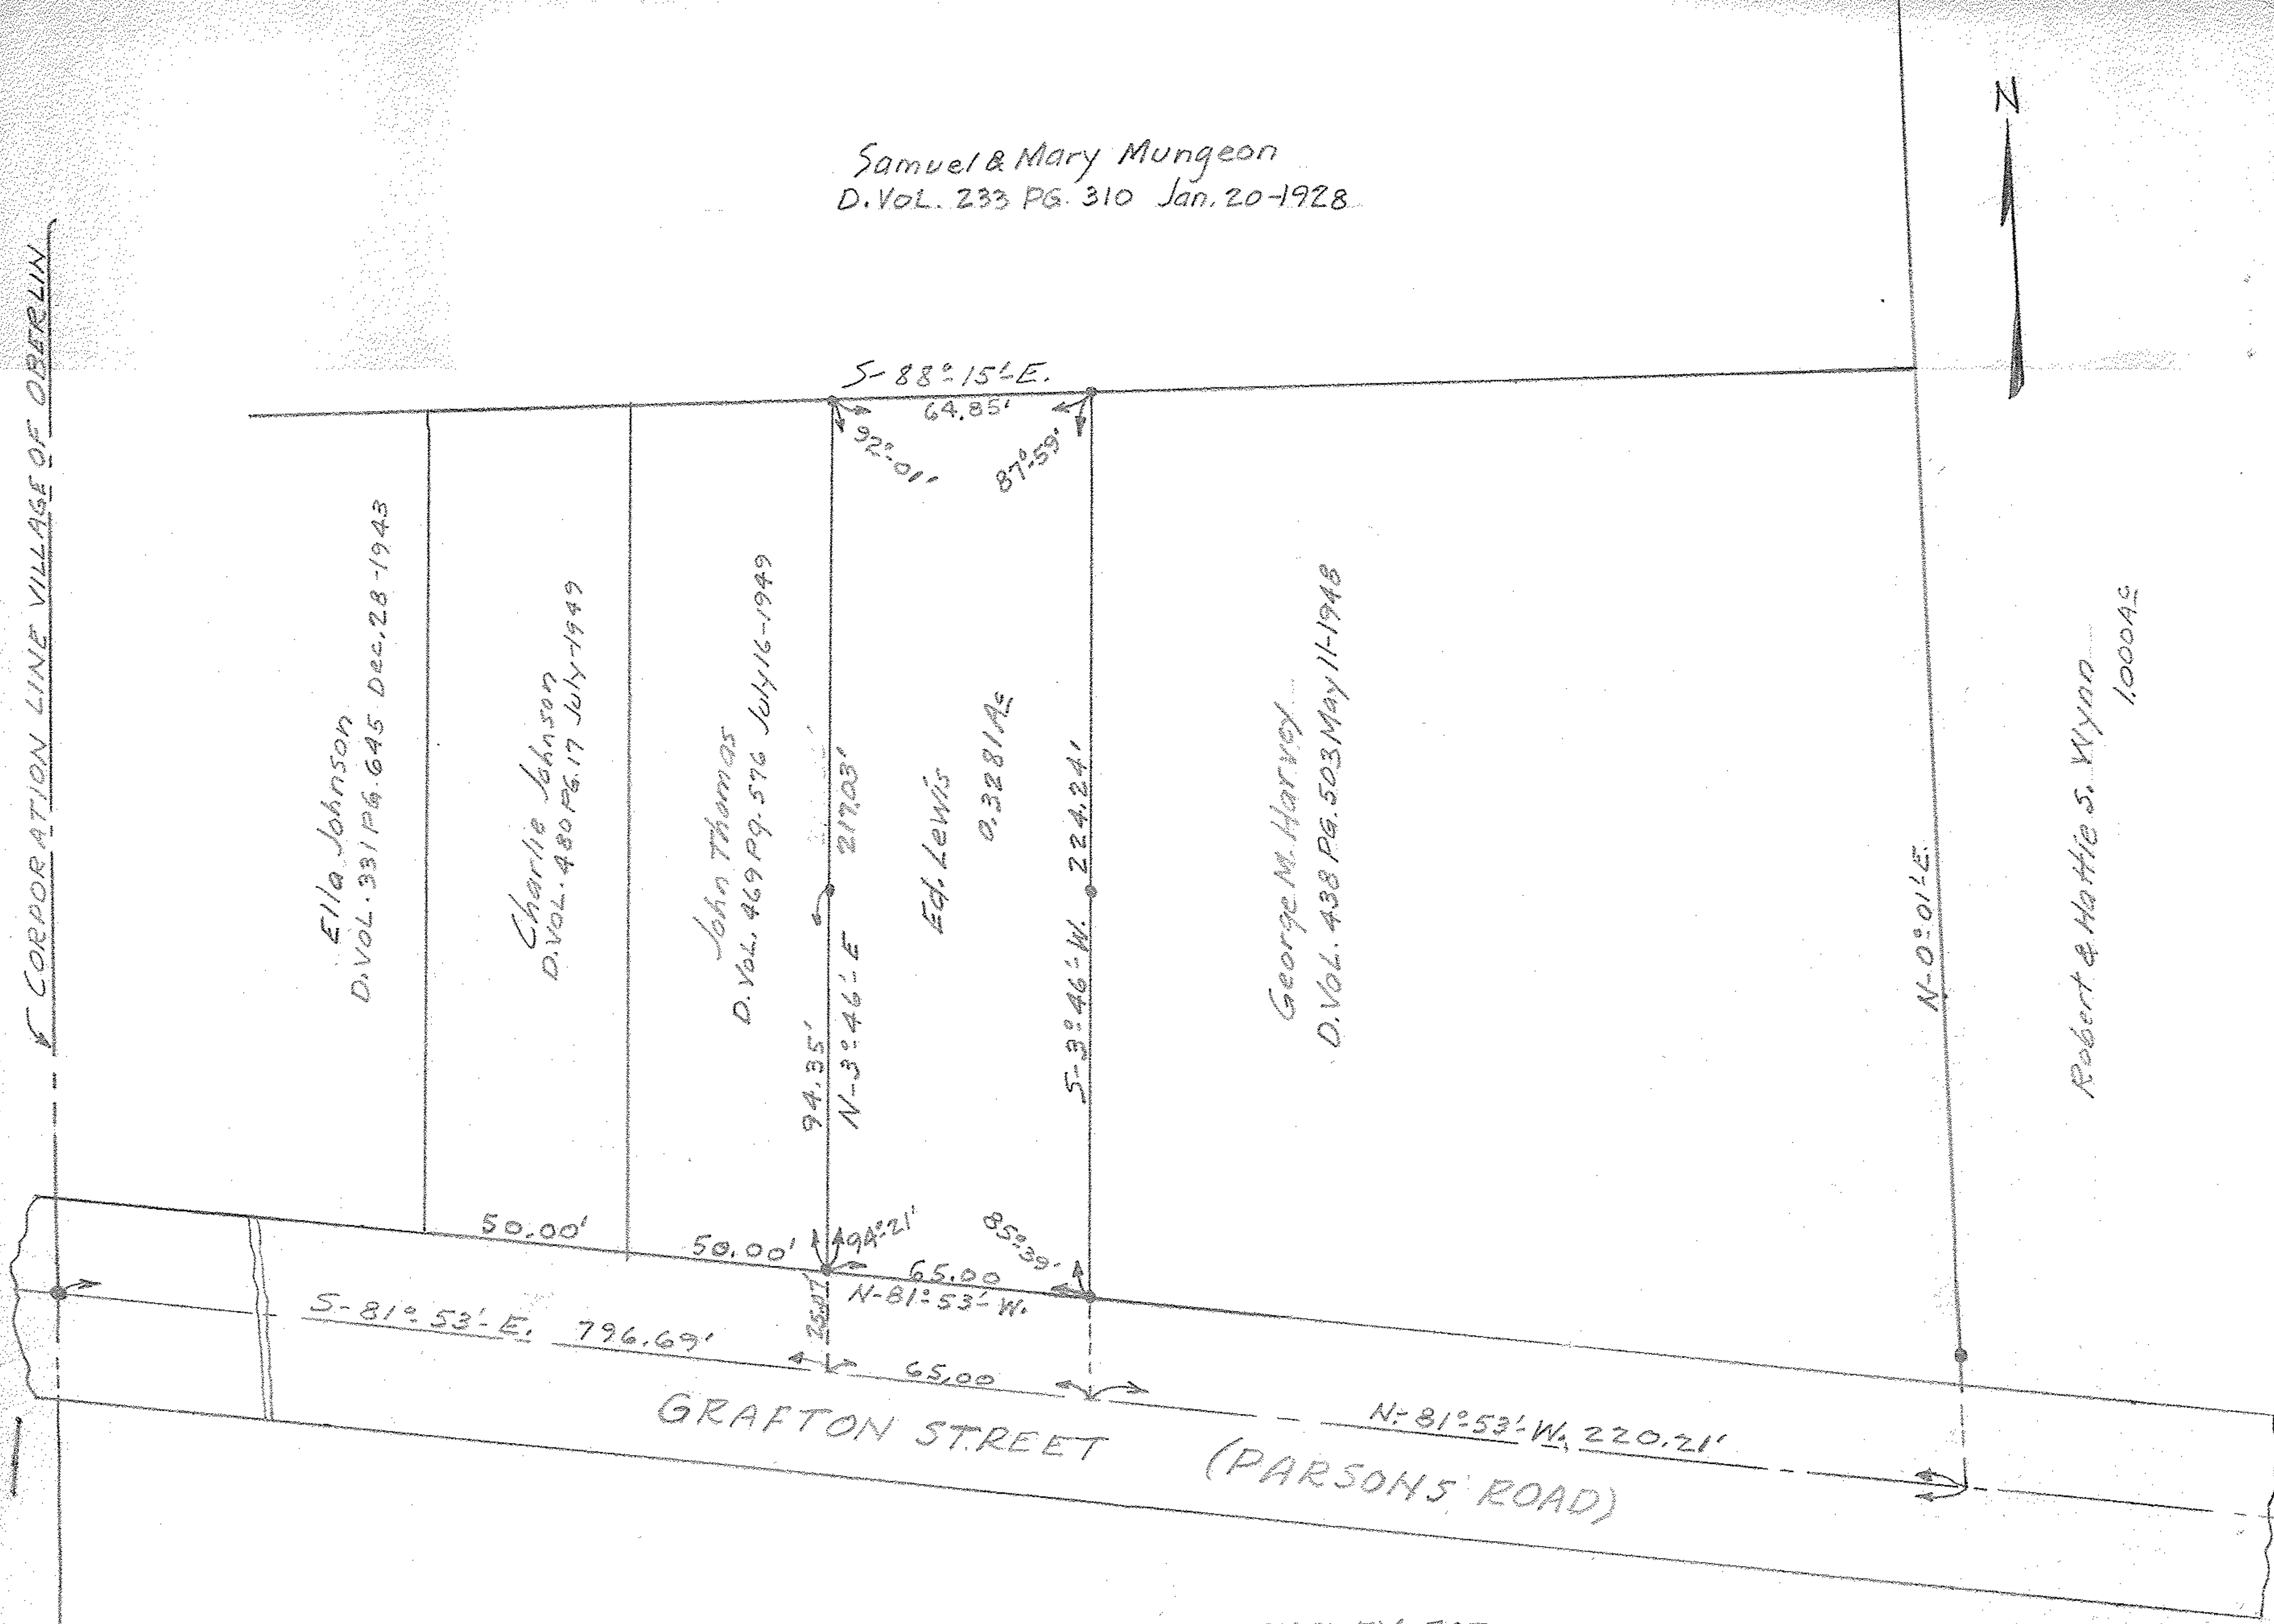

50.00' 50.00' 65.00' 65.00' 220.21'
S-81°53'-E. 796.69' N-81°53'-W. 220.21'
GRAFTON STREET (PARSONS ROAD)

MAP OF SURVEY FOR
Ed. Lewis
O.L. 97 RUSSIA TWP. LORAIN CO.
Scale 1"=40 FT. JUNE-16-1951
C.E. Penfound Registered Surveyor.

09-00-097-A
09-00-097-000-000 09-00-097